


EQUIPMENT
 EQUIPMENT NUMBER < 4800g
 3 BOWER ANCHORS, STOCKLESS 420 KG.
 1 STRENGTH ANCHOR 125 KG. EX. STOCK
 1 KEDGE " 65 KG. EX. STOCK
 300 m 27mm STUD CHAIN CABLES MIN. WEIGHT 4810 KG.
 85 m 57mm STEEL WIRE
 165 m 102mm MANILLA
 135 m 64mm STEEL WIRE.


DIMENSIONS
 LENGTH PP = 36.20 m
 BREADTH MOULDED = 7.80 m
 DEPTH MOULDED = 3.60 m

CLASS
 LLOYD'S REGISTER 100 A1 SAILING AS WELL
 AS MOTOR VESSEL, STRENGTHENED FOR NAVI-
 GATION IN ICE
 PART ELECTRICALLY WELDED.


NUMERALS (METRIC UNITS)
 L = 36.20 B = 7.80 D = 3.60
 d = 2.76 (FRAMING DEPTH)
 L x D = 130.3
 L x (B + D) = 412.7
 L/D = 10.0

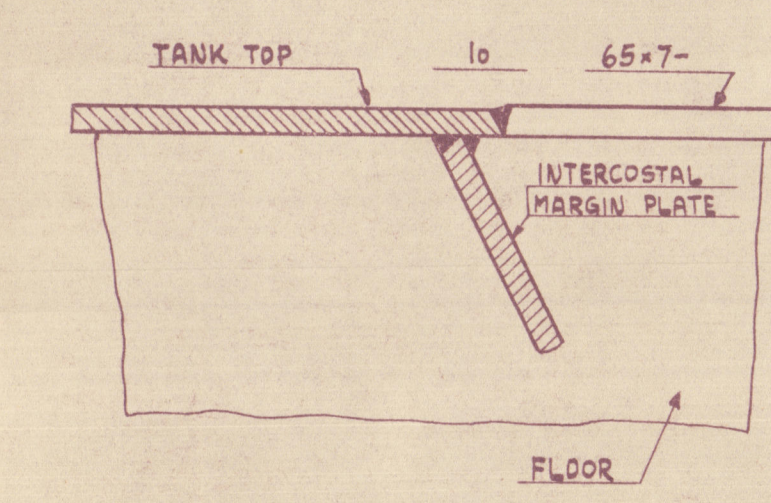


DETAIL "B"

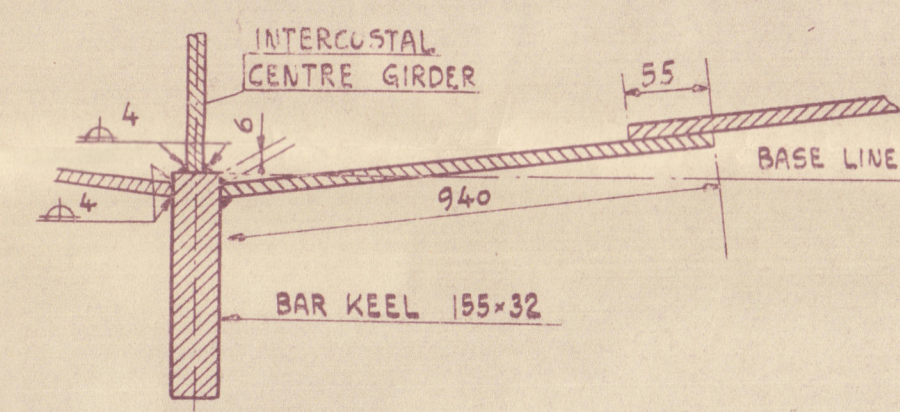


DETAIL "C"

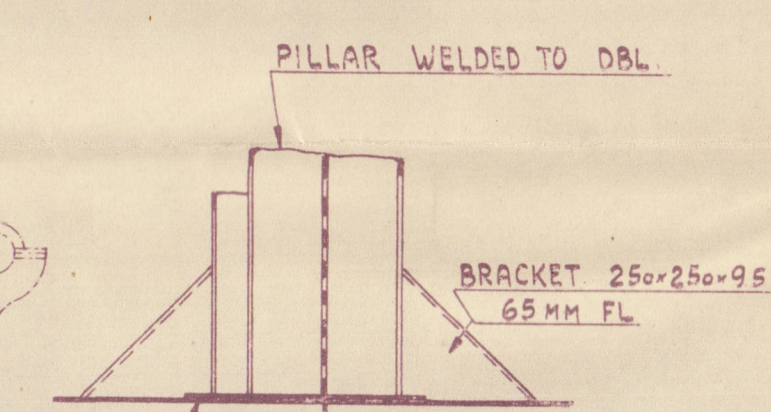

DETAIL "D"

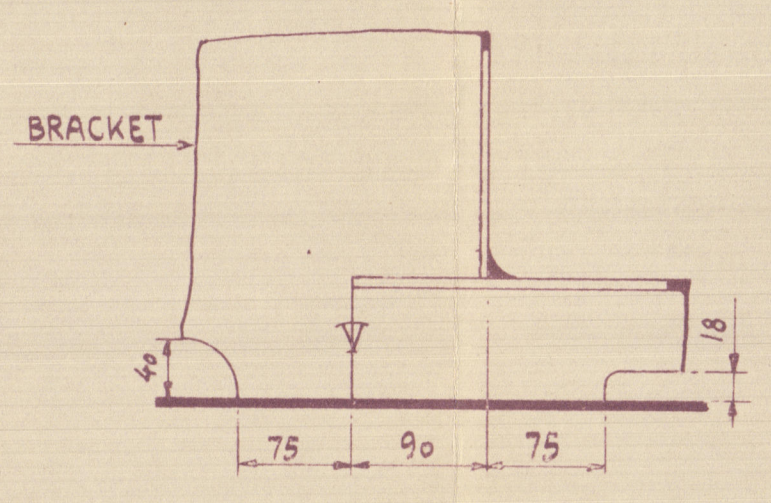

DETAIL "A"

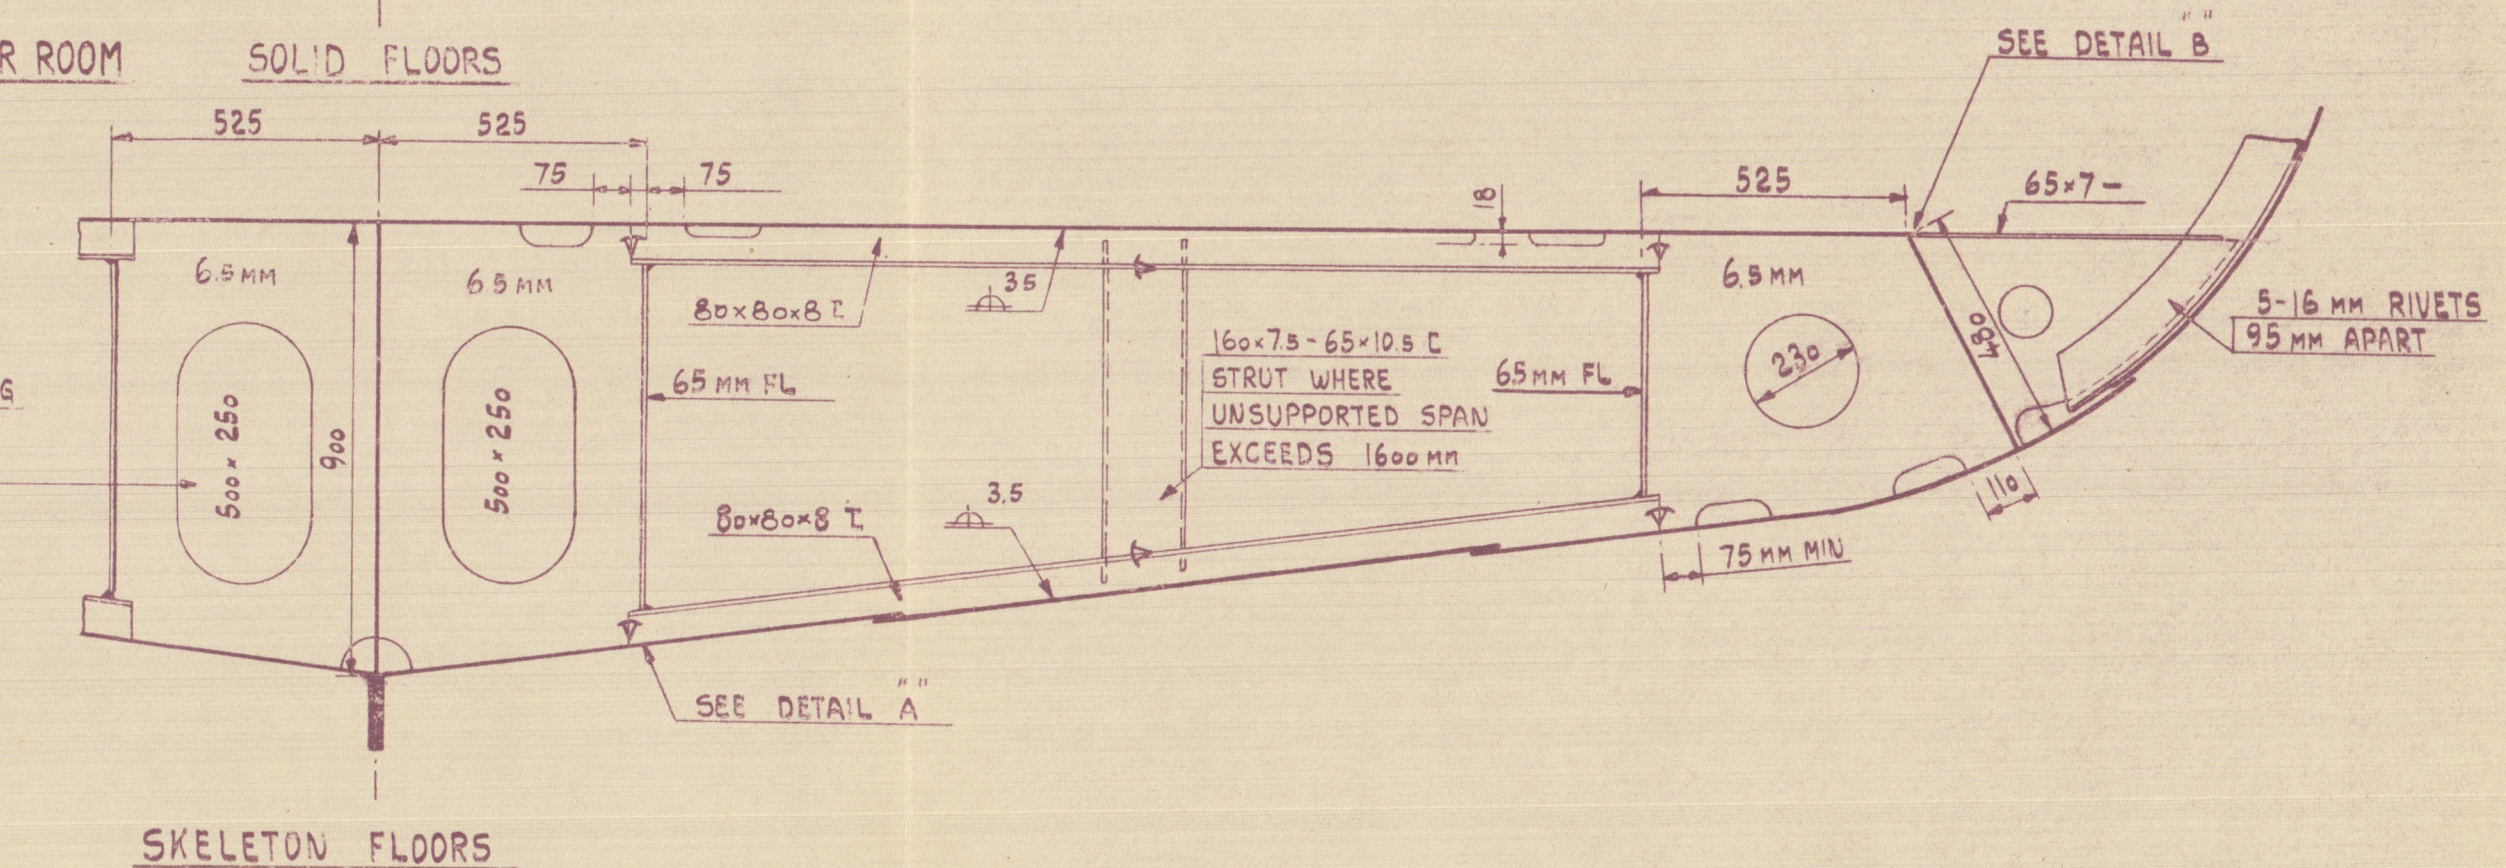

SECTION THROUGH MOTOR ROOM

SOLID FLOORS

SKELETON FLOORS

CORRECTED AS APPROVED BY LLOYD'S. 19-2-40

GOthenBURG FIRST ENTRY REPORT No. 16850.

"VALE"


"VALE"



"INERID"

midship Section (As Built)

RECORDS DEPT.,
LONDON

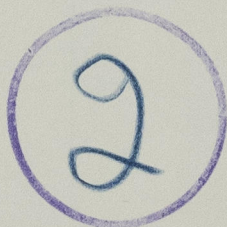

© 2021

Lloyd's Register
Foundation

007967-007976-0076