

Lloyd's Register of British & Foreign Shipping.

SURVEYS FOR FREEBOARD.-STEAM SHIPS.

TUES. 21 JAN 1908

PARTICULARS RELATING TO ALL STEAM SHIPS EITHER FLUSH DECKED, OR WITH TOP GALLANT FORECASTLES, SHORT POOPS AND BRIDGE HOUSES DISCONNECTED, OR WITH TOP GALLANT FORECASTLES HAVING LONG POOPS, OR RAISED QUARTER DECKS CONNECTED WITH BRIDGE HOUSES, OR OTHERWISE.

Port of Survey Nagasaki
Date of Survey 26 Dec. 1907
Name of Surveyor G. D. Aitken

327

Ship's Name. KAMO MARU <i>Mitsui Bishi Co's No 195</i> Number in Register Book	Port of Registry and Nationality. <i>Tokyo</i> Japan	Official Number. ✓	Gross Tonnage. 8628	Date of Build. 1908	Particulars of Classification. 100A1. S.D.K. Rule contemplated
------------------------------------------------------------------------------------------------	------------------------------------------------------------	-----------------------	------------------------	------------------------	-------------------------------------------------------------------

Registered dimensions from Ship's Register.	LENGTH. 464.25	BREADTH. 56.22	DEPTH. 31.54	UNDER DECK Tonnage. 6873.06
Length on LOADLINE	464.25	Frame Depth 1/2 Rule " 7	Ceiling <i>Fitted</i> Sheer 34	Peak includes Tanks include 2.190 in space
CORRECTED DIMENSIONS.	464.25	55.47	31.88	6873.06

Moulded Depth as measured..... 34-6
34-6
36-5

NOTE. - If the depth is measured when vessel is afloat, the details of measurement should be reported.

Co-efficient of fineness837
Any modification necessary [Para. 4 (a) to (e)*]02
Co-efficient as corrected817

CORRECTION FOR LENGTH.

Length of Ship on Loadline..... 464.25
Length in Table 412.50
Difference 50.75
Correction for 10ft., Table A. 1.7
× Difference divided by 10 8.52
If 1/10ths length covered divide by 2 +4.26

Sheer { Stem... 99
at { Sternpost... 38 1/2 } $137 1/2 \div 2 = 68 3/4$... Mean

Sheer at 1/2 of the length from { Stem 57 1/2
Sternpost 19 1/2 } $77 \div 2 = 38 1/2$... Mean

Gradual mean Sheer 70"
Standard mean Sheer (Table, Para. 18) 56.42 Correction
Difference..... $12.33 \div 4 = -3.08$

§ If limited as Para. 18 (f).....

CORRECTION FOR IRON DECK.

Proportion covered, if less than 1/10ths length covered613
Thickness of usual wood deck, less stringer..... 3 1/2
3" wood sheathing allowed in reduced width. Corr. = -1/4

Rise in Sheer from amidships { At front of bridge house.....
[Para. 18 (e)] { At after end of forecastle

Fall in sheer { $3/4" \div 2 =$
Para. 18 (d) }
Length uncovered *allowed by bridge* Correction

CORRECTION FOR ROUND OF BEAM.

Breadth at Gunwale amidships..... 55-8"
Round of Beam..... 14"
Normal round 14"
Difference $0 \div 2 =$
Proportion of Deck uncovered (Para. 19) 8 1/2

ALLOWANCE FOR DECK ERECTIONS:-

Freeboard, Table C..... 6-5
Correction for Length, if required (Para. 12, 13, and 14) 9-5
Freeboard by Table A, corrected for sheer, and for length, if required (Para. 12, 13, and 14) 9-3 1/4
Difference 3-0
Percentage as below..... 41.3%

Freeboard, Table A 9-8
Correction for Sheer 3
Correction for Length 4 1/2
Allowance for Deck Erections 8-6
Correction for Round of Beam..... 0
Correction for fall in Sheer (if any) 0
Correction for Iron Deck (if required) 8-5 3/4
Additions for non-compliance with provisions of Para. 11 (d) and (e) 0
Other Corrections (if any)..... 0

Correction for R. Q. Dk. if engine and boiler openings not covered by bridge house (Para. 11)	<u>15 1/4</u>
Allowance for Deck Erections	<u>14 3/4</u>
Forecastle	Length <u>53-10"</u> Length allowed <u>48-10"</u> Height <u>7-9</u>
Bridge House	Length <u>175-6</u> Length allowed <u>175-6</u> Height <u>7-9</u>
† Raised Qr. Dk.	Length <u>60-8</u> Length allowed <u>60-8</u> Height <u>7-9</u>
Poop	Length <u>60-8</u> Length allowed <u>60-8</u> Height <u>7-9</u>
Total	Length <u>290</u> Length allowed <u>285</u> Height <u>6-13</u>
Length of Ship	<u>464.25</u>
Corresponding percentage (Para. 11, 12, 13, or 14)	<u>41.3%</u>

Winter Freeboard 8-5 3/4
Summer Freeboard 7-11 1/2
Indian Summer Freeboard 7-5 3/4
N. A. Winter Freeboard 8-1 1/2

Correction necessary because clearside amidships, measured in accordance with the Statute, is not taken at the intersection of the wood or iron deck with side. + 2 1/4

Winter Freeboard from deck line 8-8
Summer " " " " 8-11 1/2
Indian Summer " " " " 7-7 1/2
N. A. Winter, " " " " 8-1 1/2

FREEBOARD recommended amidships from centre of Disc to top of Statutory Deck Line, Wood (Iron) Deck :-

Fresh Water Line above centre of Disc
Indian Summer Line " " " "
Winter Line below " " " "
Winter North Atlantic Line " " " "

Amended Tables March 1906.

MARKING REPORT RECEIVED 20 MAY 1908

† If the frames, skin planking, or ceiling are of unusual thickness the breadth of vessel to inside of ceiling should be reported if possible.
† In vessels obtaining an allowance for deck erections under Para. 11 where the sheer drops abaft amidships the height of the R.Q.D. is to be taken from the level of the top of the amidship beam.
† In flush-decked vessels the total standard mean sheer means the sheer measured at the stem and sternpost. In vessels having poops and forecastles, it means the sheer measured at points distant one-eighth of the vessel's length from stem and sternpost.

† State dimensions of freeing port area on back of this form.
† The Surveyor should state whether the fall in sheer as reported is measured relatively to the straight line of keel or to the water line. If measured relatively to water line the vessel's draft at time of survey, and also the usual load draft forward and aft, should be reported.

Ln B7S 23/1/08

Copy to Surveyor 23/1/08

4800-689700-184700


Do all the Frames extend to the top height in the Poop? *Yes* Raised Quarter Deck? Bridge House? *Yes* Forecastle? *Yes*
 To what height do the Reverse Frames extend? *Upper 8 ft for 3 1/2 ft before & aft of main M. & alternately and to 6 ft below*
 Has the Poop or Raised Quarter Deck an efficient Iron Bulkhead at the fore end? *Yes*
 Give particulars of the means for closing the openings in Bulkhead *Iron doors, riveted hinges*
 Is the Poop or Raised Quarter Deck connected with the Bridge House? *No* Has the Bridge House an efficient Bulkhead at the fore end? *Yes*
 Give particulars of the means for closing the openings in Bulkhead *W. G. doors riveted hinges*
 What is the thickness of the Bridge Front plating? *9/20* and Coaming plate? *10/20*
 Give scantlings and spacing of the Stiffeners *9 1/2 x 3 1/2 x 13/20 13 Angle 20° apart*
 Are bracket plates fitted at each end of the Stiffeners? *Yes* Are hor'l. brackets fitted connecting Bridge Bulk'd. with Bulwarks? *Yes*
 Has the Bridge House an efficient Iron Bulkhead at the after end? *Yes*
 How are the openings closed? *Storm boards in channels, half height*
 Is the Forecastle at least as high as the main or top-gallant rail? *Yes* Has the Forecastle an efficient Iron or Wood Bulk'd. at after end? *Yes*
 Are the Engine and Boiler openings covered by a Bridge, Poop, Raised Quarter Deck, or enclosed by a Strong Iron or Steel Deckhouse? *Yes*
 If the openings are not so protected are the exposed parts of the Casings efficiently constructed?
 Give thickness of plating; scantlings and spacing of Stiffeners
 What is the height of the exposed Casings? Are suitable means provided for closing all openings in them in bad weather? *Yes*
 Are the Weather Deck Hatchways efficiently constructed and at least equal to the requirements of Section 28 of the Rules for 1904-5? Give particulars below:— *Yes*

Position and Size.	N ^o 1 for 19-6 x 16		N ^o 2 28-2 x 18-0		N ^o 3 17-4 x 16-0 <i>on bridge deck</i>		N ^o 4 23-10 x 18		N ^o 5 21-8 x 18-0	
	Ship.	Rule.	Ship.	Rule.	Ship.	Rule.	Ship.	Rule.	Ship.	Rule.
COAMING										
Height above top of DECK	30	30 <i>W</i>	30	30 <i>W</i>	24	18	30	30 <i>W</i>	30	30
Thickness	Sides	9/20	10/20	10/20	9/20	8/20	9/20	9/20	8/20	8/20
	Ends	8/20	8/20	7/20	9/20	8/20	9/20	9/20	8/20	8/20
SHIFTING BEAMS OR WEB PLATES	Number	1	3	3	2	2	2	2	2	2
	Section and Scantlings	web 8/10	web 9/10	web 9/10	web 8/10	web 8/10	web 9/10	web 9/10	web 9/10	web 9/10
	Material	Steel	Steel	Steel	Steel	Steel	Steel	Steel	Steel	Steel
FORE AND AFTERS	Number	3	3	3	3	3	3	3	3	3
	Section and Scantlings	1 bulk plate 10 x 10/20	1 bulk plate 11 x 11/20	1 bulk plate 11 x 11/20	1 bulk plate 10 x 10/20	1 bulk plate 10 x 10/20	1 bulk plate 11 x 11/20	1 bulk plate 11 x 11/20	1 bulk plate 11 x 11/20	1 bulk plate 11 x 11/20
	Material	Steel	Steel	Steel	Steel	Steel	Steel	Steel	Steel	Steel
HATCHES Thickness										
Remarks										

* When the Fore and Afters are of wood the depth should be stated from the underside of the hatches.
 (If the sill of the lowest side scuttle will be less than 6 inches above the Indian Summer Load Line if assigned under the tables, state vertical distance from top of deck at side amidships to lower edge of lowest side scuttle.)

The following information is to be given in all Cases of vessels built with under Paras. 11, 12 (under 15 feet moulded depth) and under Shelter Deck Rules.

What is the thickness of the Bridge Sheerstrake? *16/20* Strake between Main and Bridge Sheerstrakes? *13/20*
 Delete the words that do not apply { The Crew ~~are~~ are not, berthed in the bridge house.
 The arrangements to enable them to get backwards and forwards from their quarters are, ~~are not~~ satisfactory.
 Length of Bulwarks in well *4-8-10* = ~~34-65~~ Sq. ft.
 Area of Freeing Ports required by Para. 11 (e) each side of vessel = *35-8* Sq. ft.
 Ft. Tenths. Ft. Tenths. No. }
 4-5 x 1-29 x 3 } Freeing Ports (each side of vessel) = *35-8* Sq. ft.
 4-78 x 1-29 x 3 }
 Total deficiency or excess = ~~1-14~~ Sq. ft.

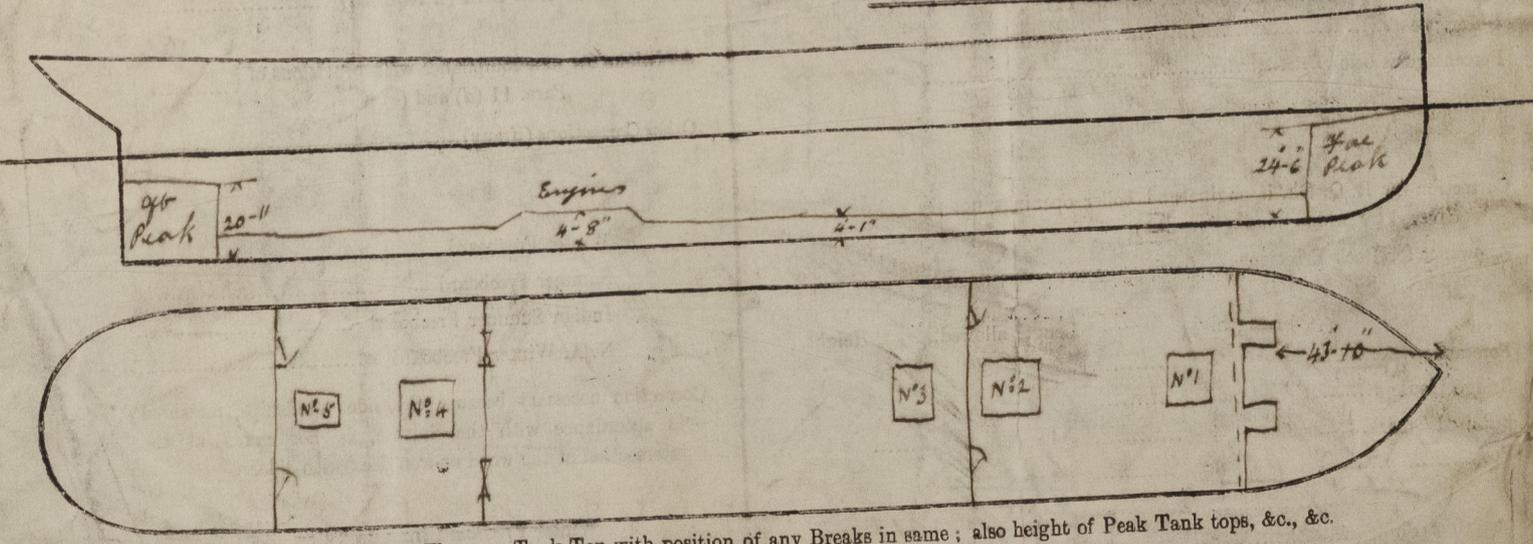

Show hereon line of Floors or Tank Top with position of any Breaks in same; also height of Peak Tank tops, &c., &c.

State any special features in the construction of the Vessel *None. Request for survey is enclosed.*

Owners *Nippon Yusen Kaisha*
 Address *Tokyo Japan*

Fee £ Received by me

