

5.9.04

MIDSHIP SECTION

STEEL STEAM TRAWLER.


— No 332. —

DIMENSIONS.

123'-2" x 21'-6" x 12'-4" MLD. 11'-6" HOLD.

SCALE 1/2" = 1 FOOT.

E + D. Casineg as previously approved.

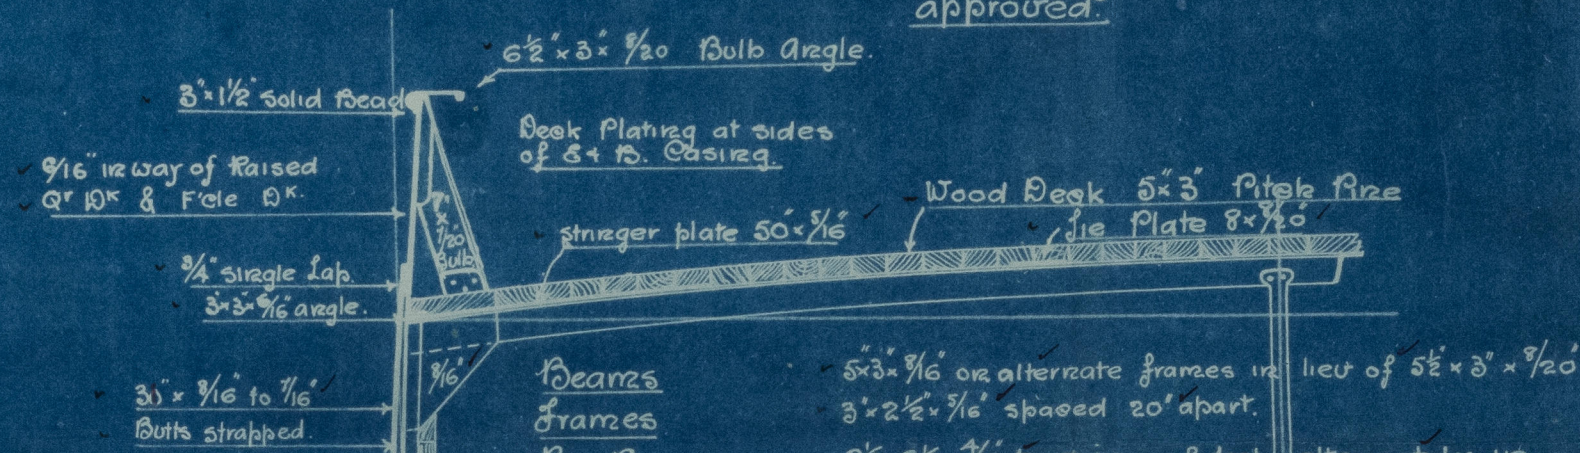

Equipment.

1st Power Axlekor 5/4" cuts Ex Stock S-2-0



© 2020

Lloyd's Register
Foundation

- Midskip Section -


Cochrane & Sons

- No 332 ½ -



½ 'Guth'

Hull Report No. 16567

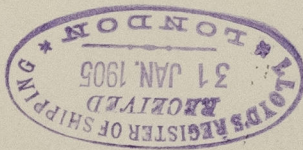

© 2020

Lloyd's Register
Foundation

007488-007497-0061