

5.9.04

# PROFILE & DECK PLAN

STEEL STEAM TRAWLER




- No 332 -

123-2 D.P. x 21-6 x 11-6 HOLD.

SCALE 1/4" = 1 FOOT

1ST No 42-36

2ND No 5167-92.

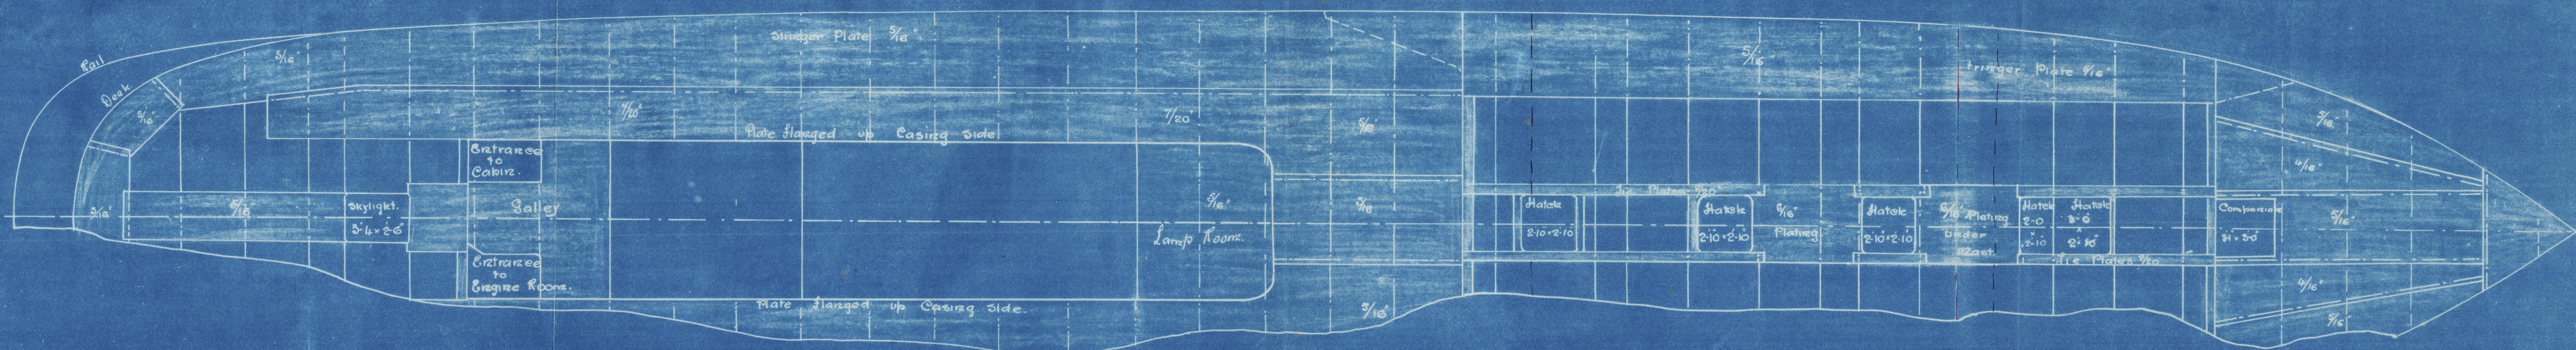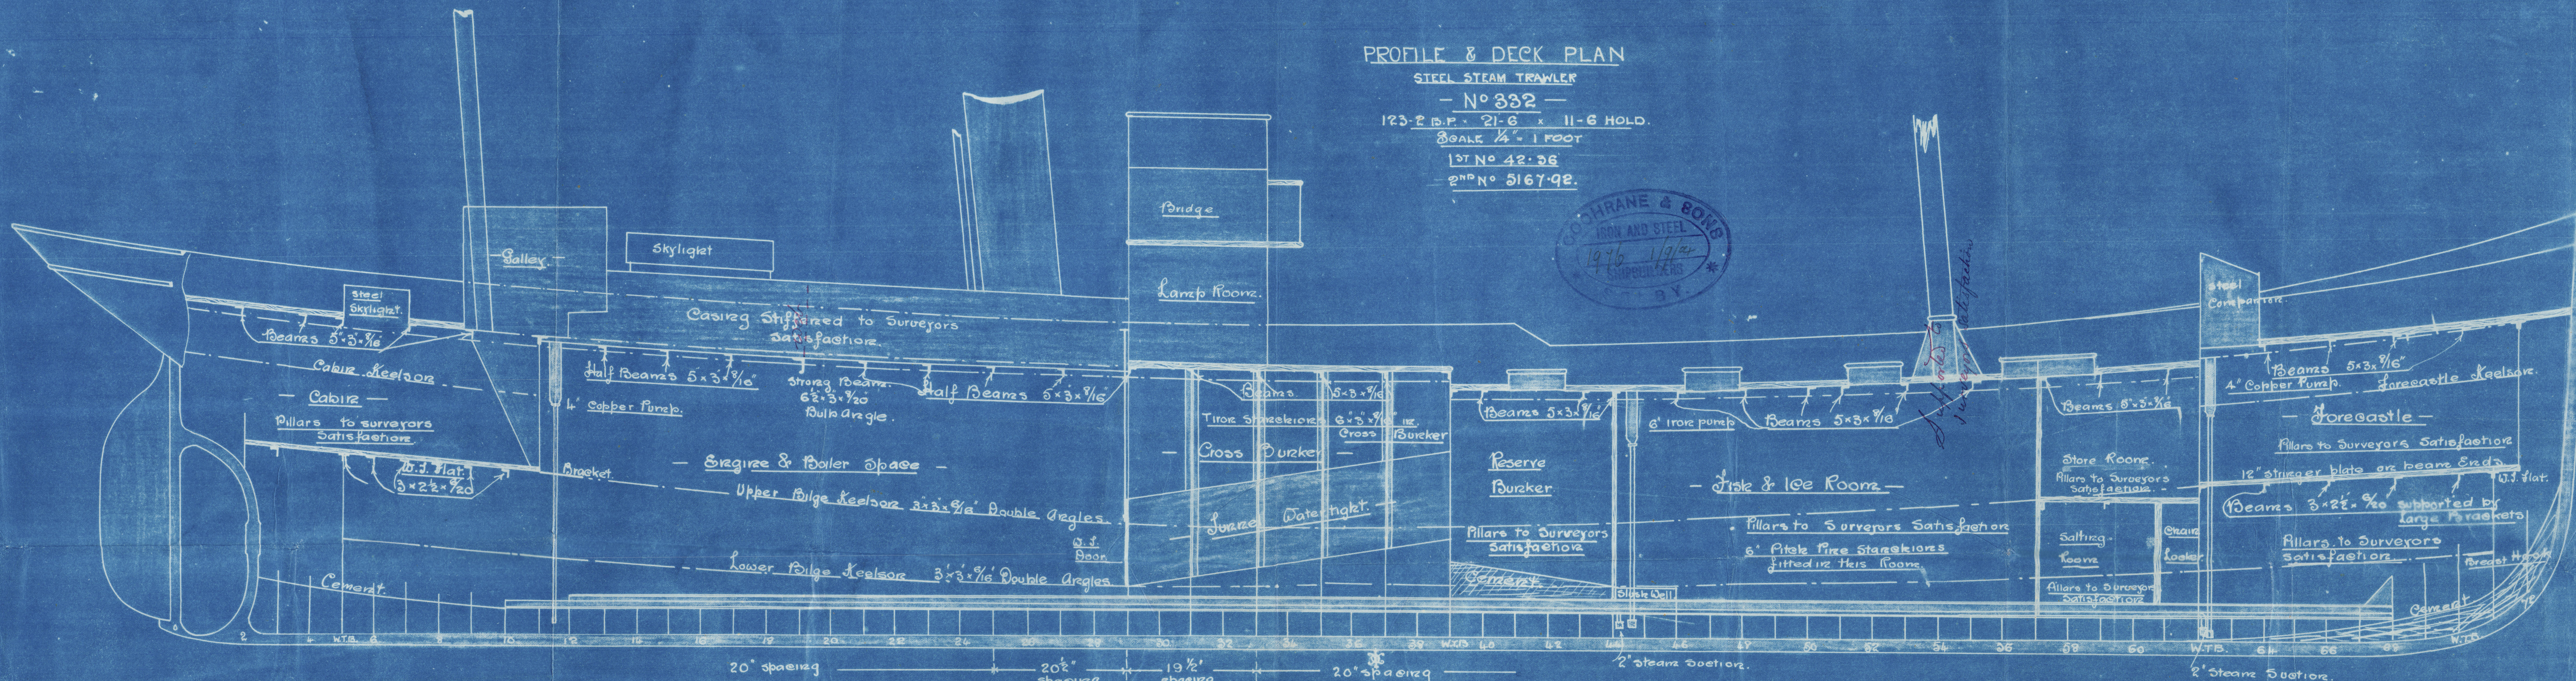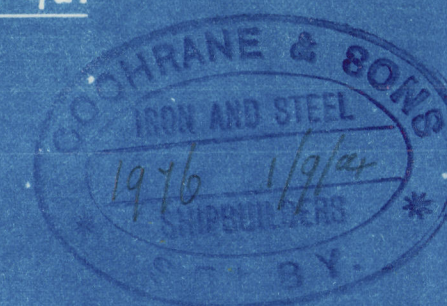

J. J. 5/9/04

007988-007997-0002



Profile + Deck Plan

Cochran & Son

No 332 -



of furth

Hull Report No. 16564



© 2020

Lloyd's Register  
Foundation

007988-007997-0002