


20-12-16

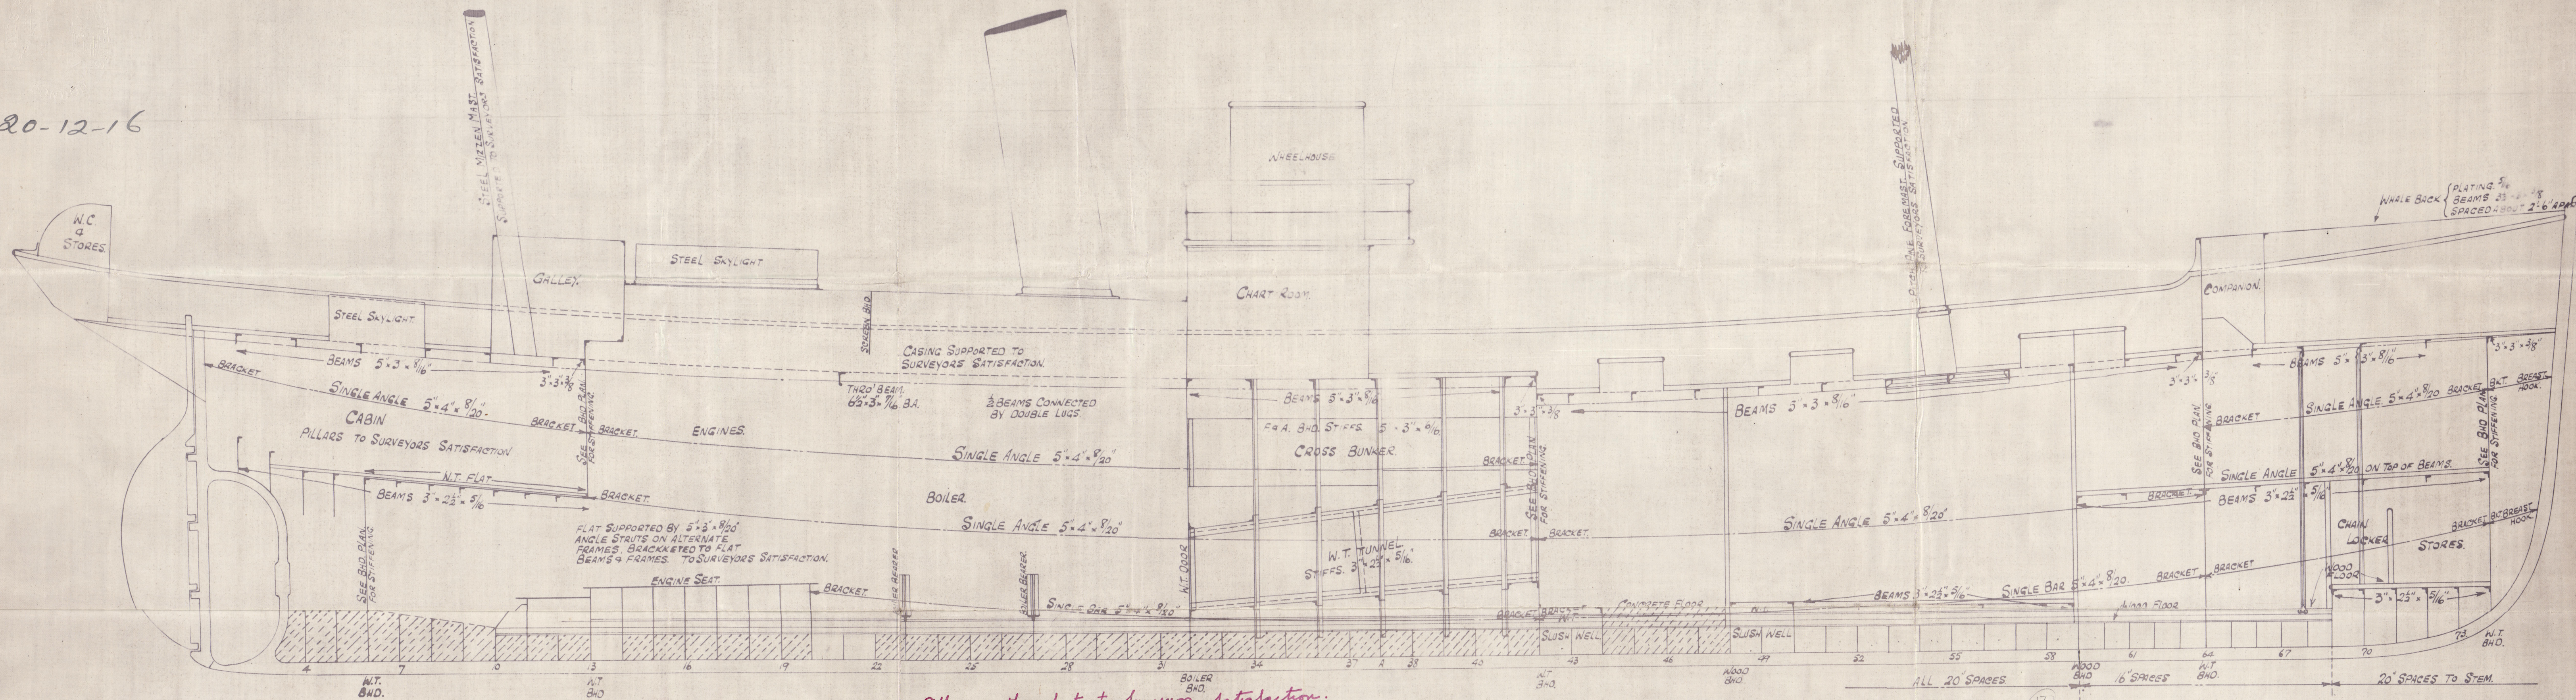

BEAM ARRANGEMENT

Pillaring throughout to Surveyors satisfaction.

DIMENSIONS - 125-03P, 22-3EX, 13-1MLO, 2-3HOLD.
SCALE 1/4" = 1'00"

SUBMITTED TO LLOYOS.
APPROVED BY LLOYOS.

№^{ос} 373-4-5 § 6.



COOK, WELTON & GEMMELL, LTD
SHIPBUILDERS.
BEVERLEY.

Cf.
19.12.16
2

N^os 373-4-5-6

PROFILE & DECK

COOK WELTON & GEMMELL

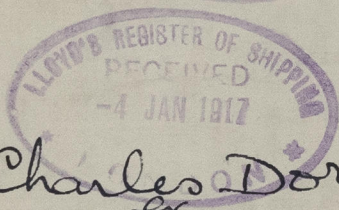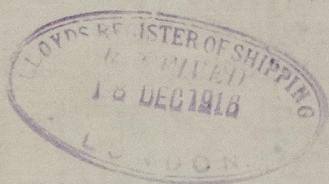

Charles Doran
ex
To John Anderson Hull Rpt No 30,310

Charles Doran 



© 2020 007988-07997-0034

Lloyd's Register
Foundation