


193

SCREW STEAMERS NOS. 1911-1913.

— SCALE $\frac{1}{2} = 1$ FOOT —

S.S. "Benvenue"

— LENGTH B.P. 360 · 0 · BREADTH EX 46 · 0 · DEPTH MOULDED 28 · 5 —

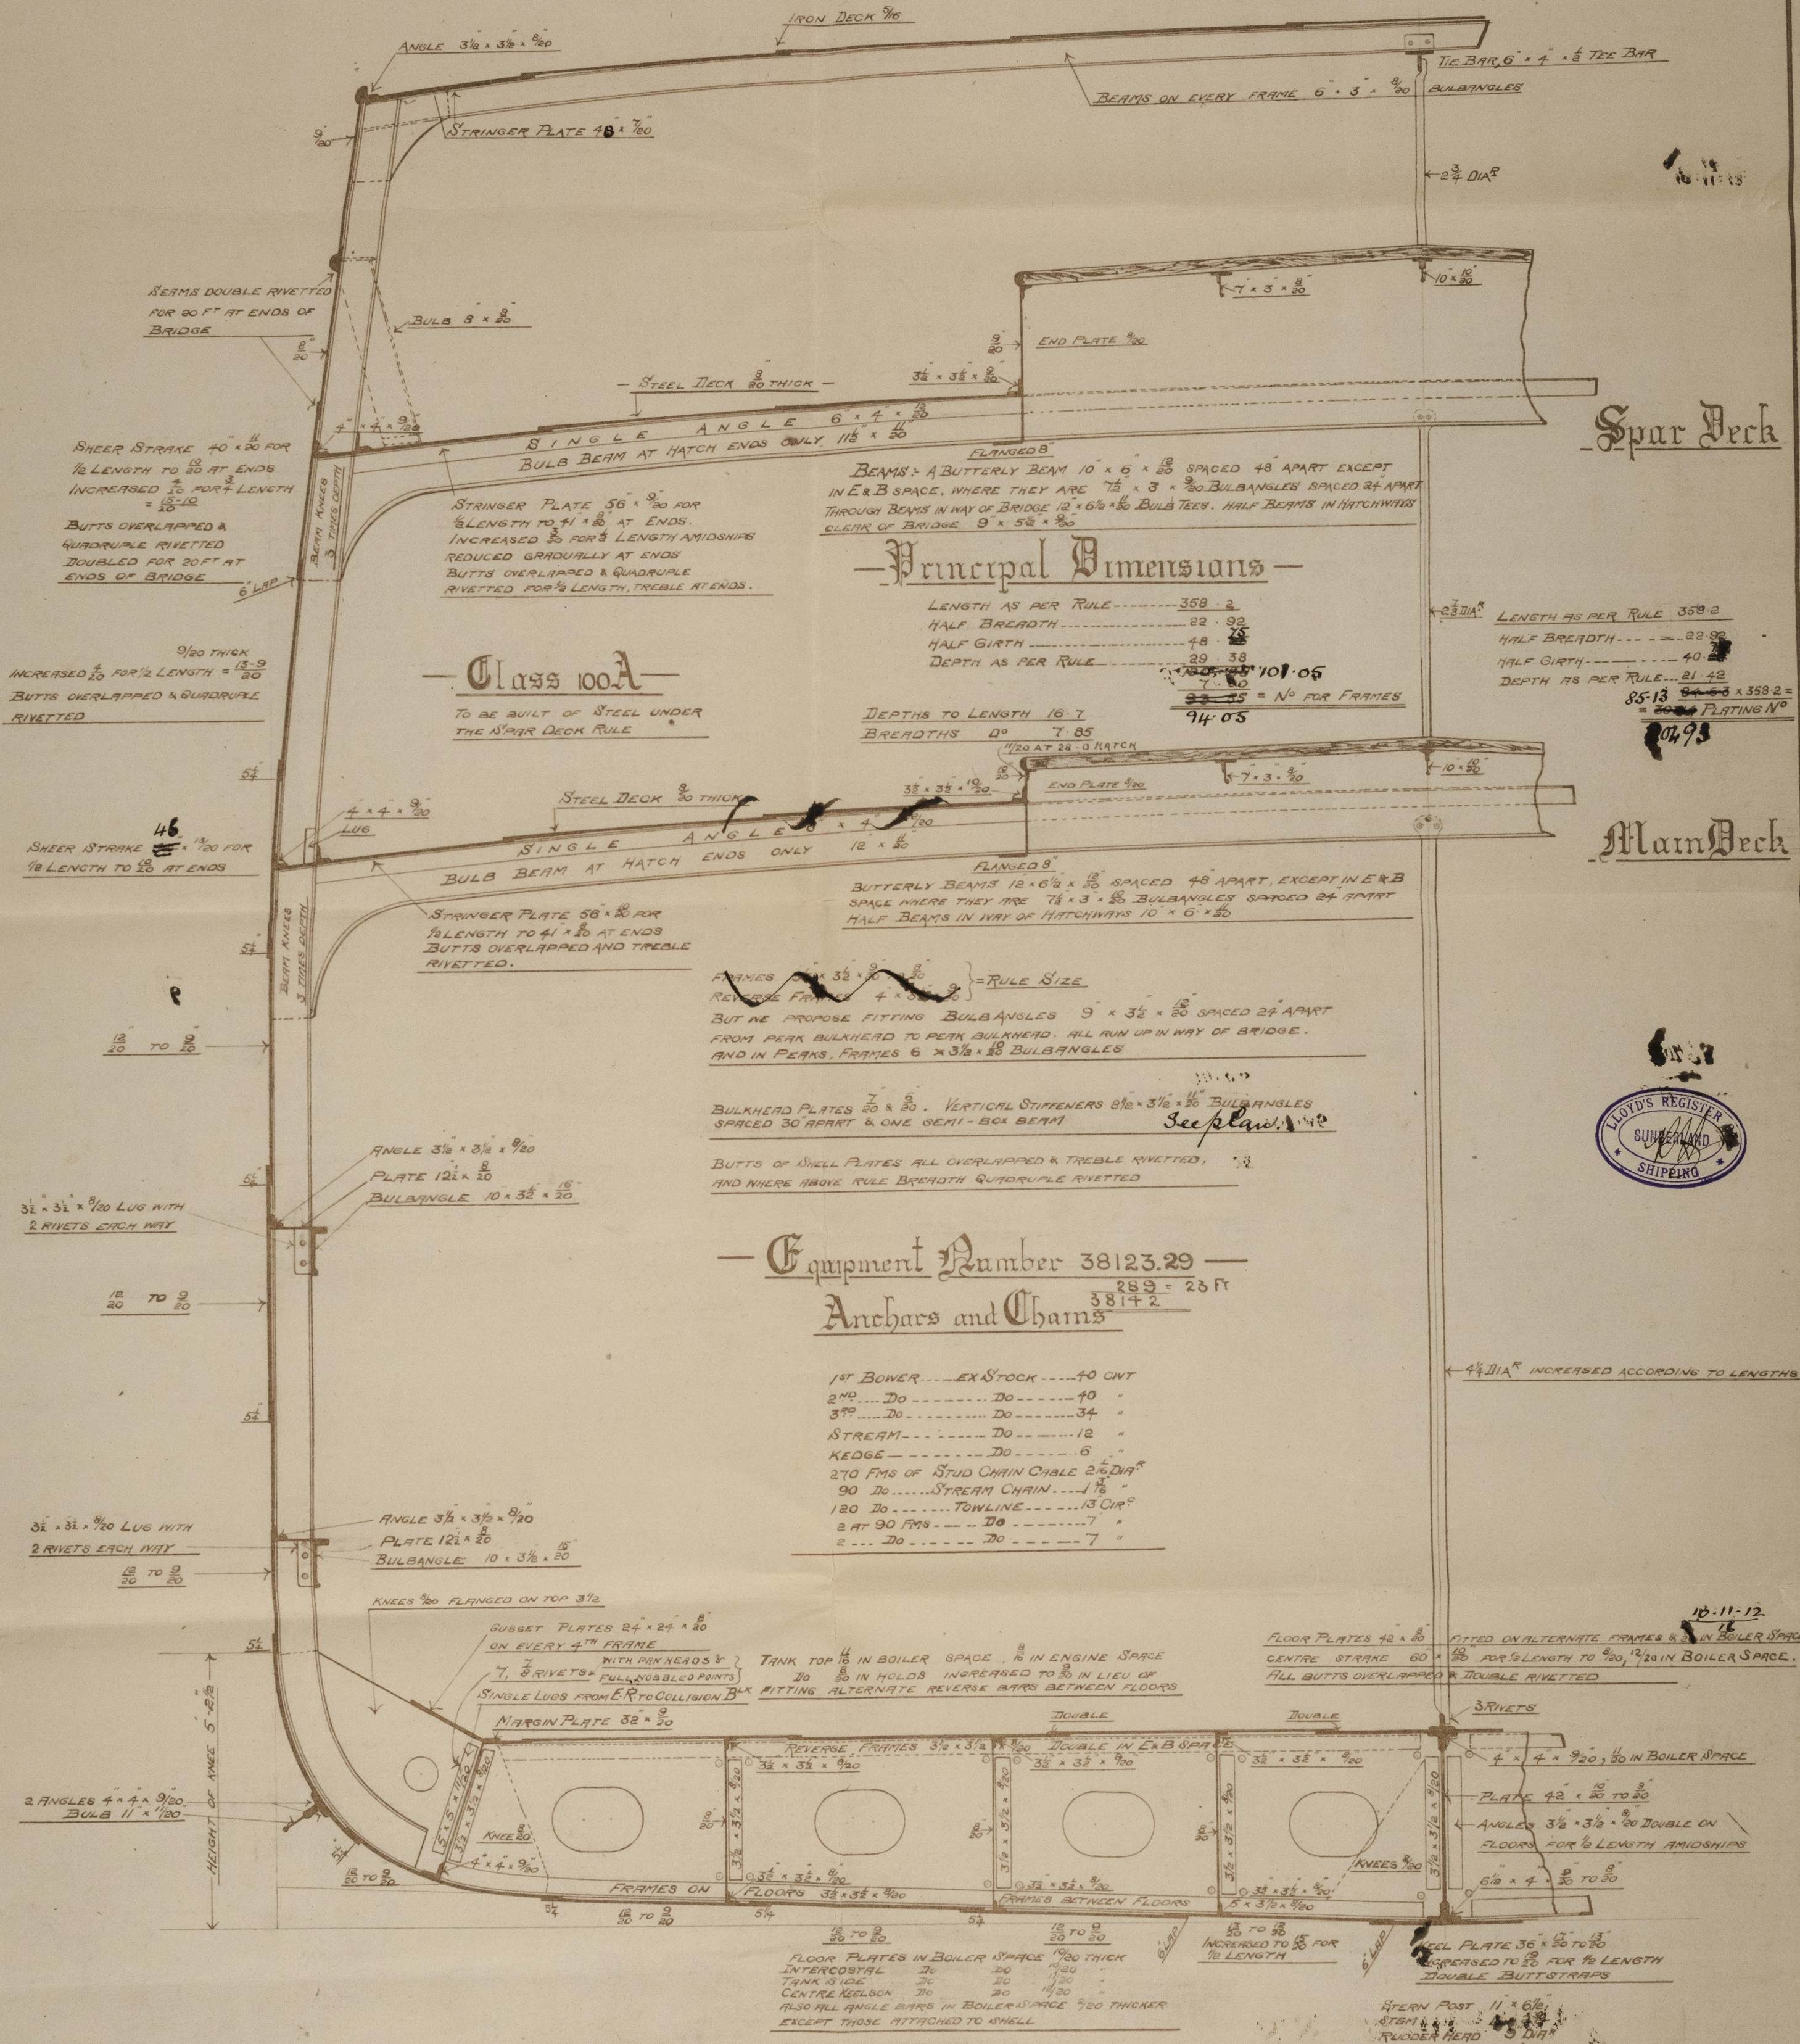

Principal Dimensions —

LENGTH AS PER RULE	358 · 2	LENGTH AS PER RULE	358 · 2
HALF BREADTH	22 · 92	HALF BREADTH	22 · 92
			FLATING NO

Equipment Number 38123.29 —

Anchors and Chains

- 1ST BOWER EX STOCK 40 CWT
- 2ND Do Do 40 "
- 3RD Do Do 34 "
- STREAM Do 12 "
- KEDGE Do 6 "
- 270 FMS OF STUD CHAIN CHABLE 2 1/2 DIA
- 90 Do STREAM CHAIN 1 1/2 "
- 2 AT 90 FMS Do 7 "
- 2 Do Do 7 "



Bartram Sons

S. S. No 193

Middlesex Section
on Light

S. S. Benvenue

Sld F. E.

No 21875



Register Vessel

to

SS Benlang

Sld 21787



© 2020

Lloyd's Register
Foundation

007433-001017-042