

SCALE $\frac{1}{8}$ " = 1 FOOT.




Bartram & Sons


No. 193.

Profile
as built.

"S. S. Benvenue"
Sld. F. E. No. 21895.

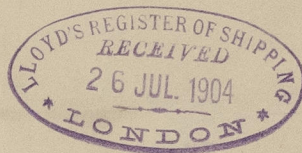

sister vessel to
"S. S. Benlany."
Sld 21787.

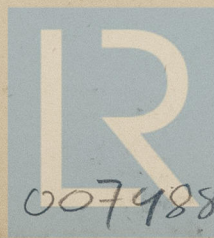

© 2020

Lloyd's Register

007488-007497-0043
Foundation