

SHIPS N^{os}. 365-72.

PROFILE & DECKS.

SCALE: 1/4" = ONE FOOT.

DRG. N^o. 23.


DIMENSIONS: 141'-0" B.P. • 27'-0" MLD. • 11'-0" MLD.

CLASS: ~~CLASS~~ BULK OIL CARRIER, SPECIAL SERVICE.

DRAUGHT 10'-0". BOA: "Carrying Petroleum in Bulk"

For Service in the Mediterranean and North African Coasting
Service to Dakar

Yard N^o 386 = Maro ex Chant 445

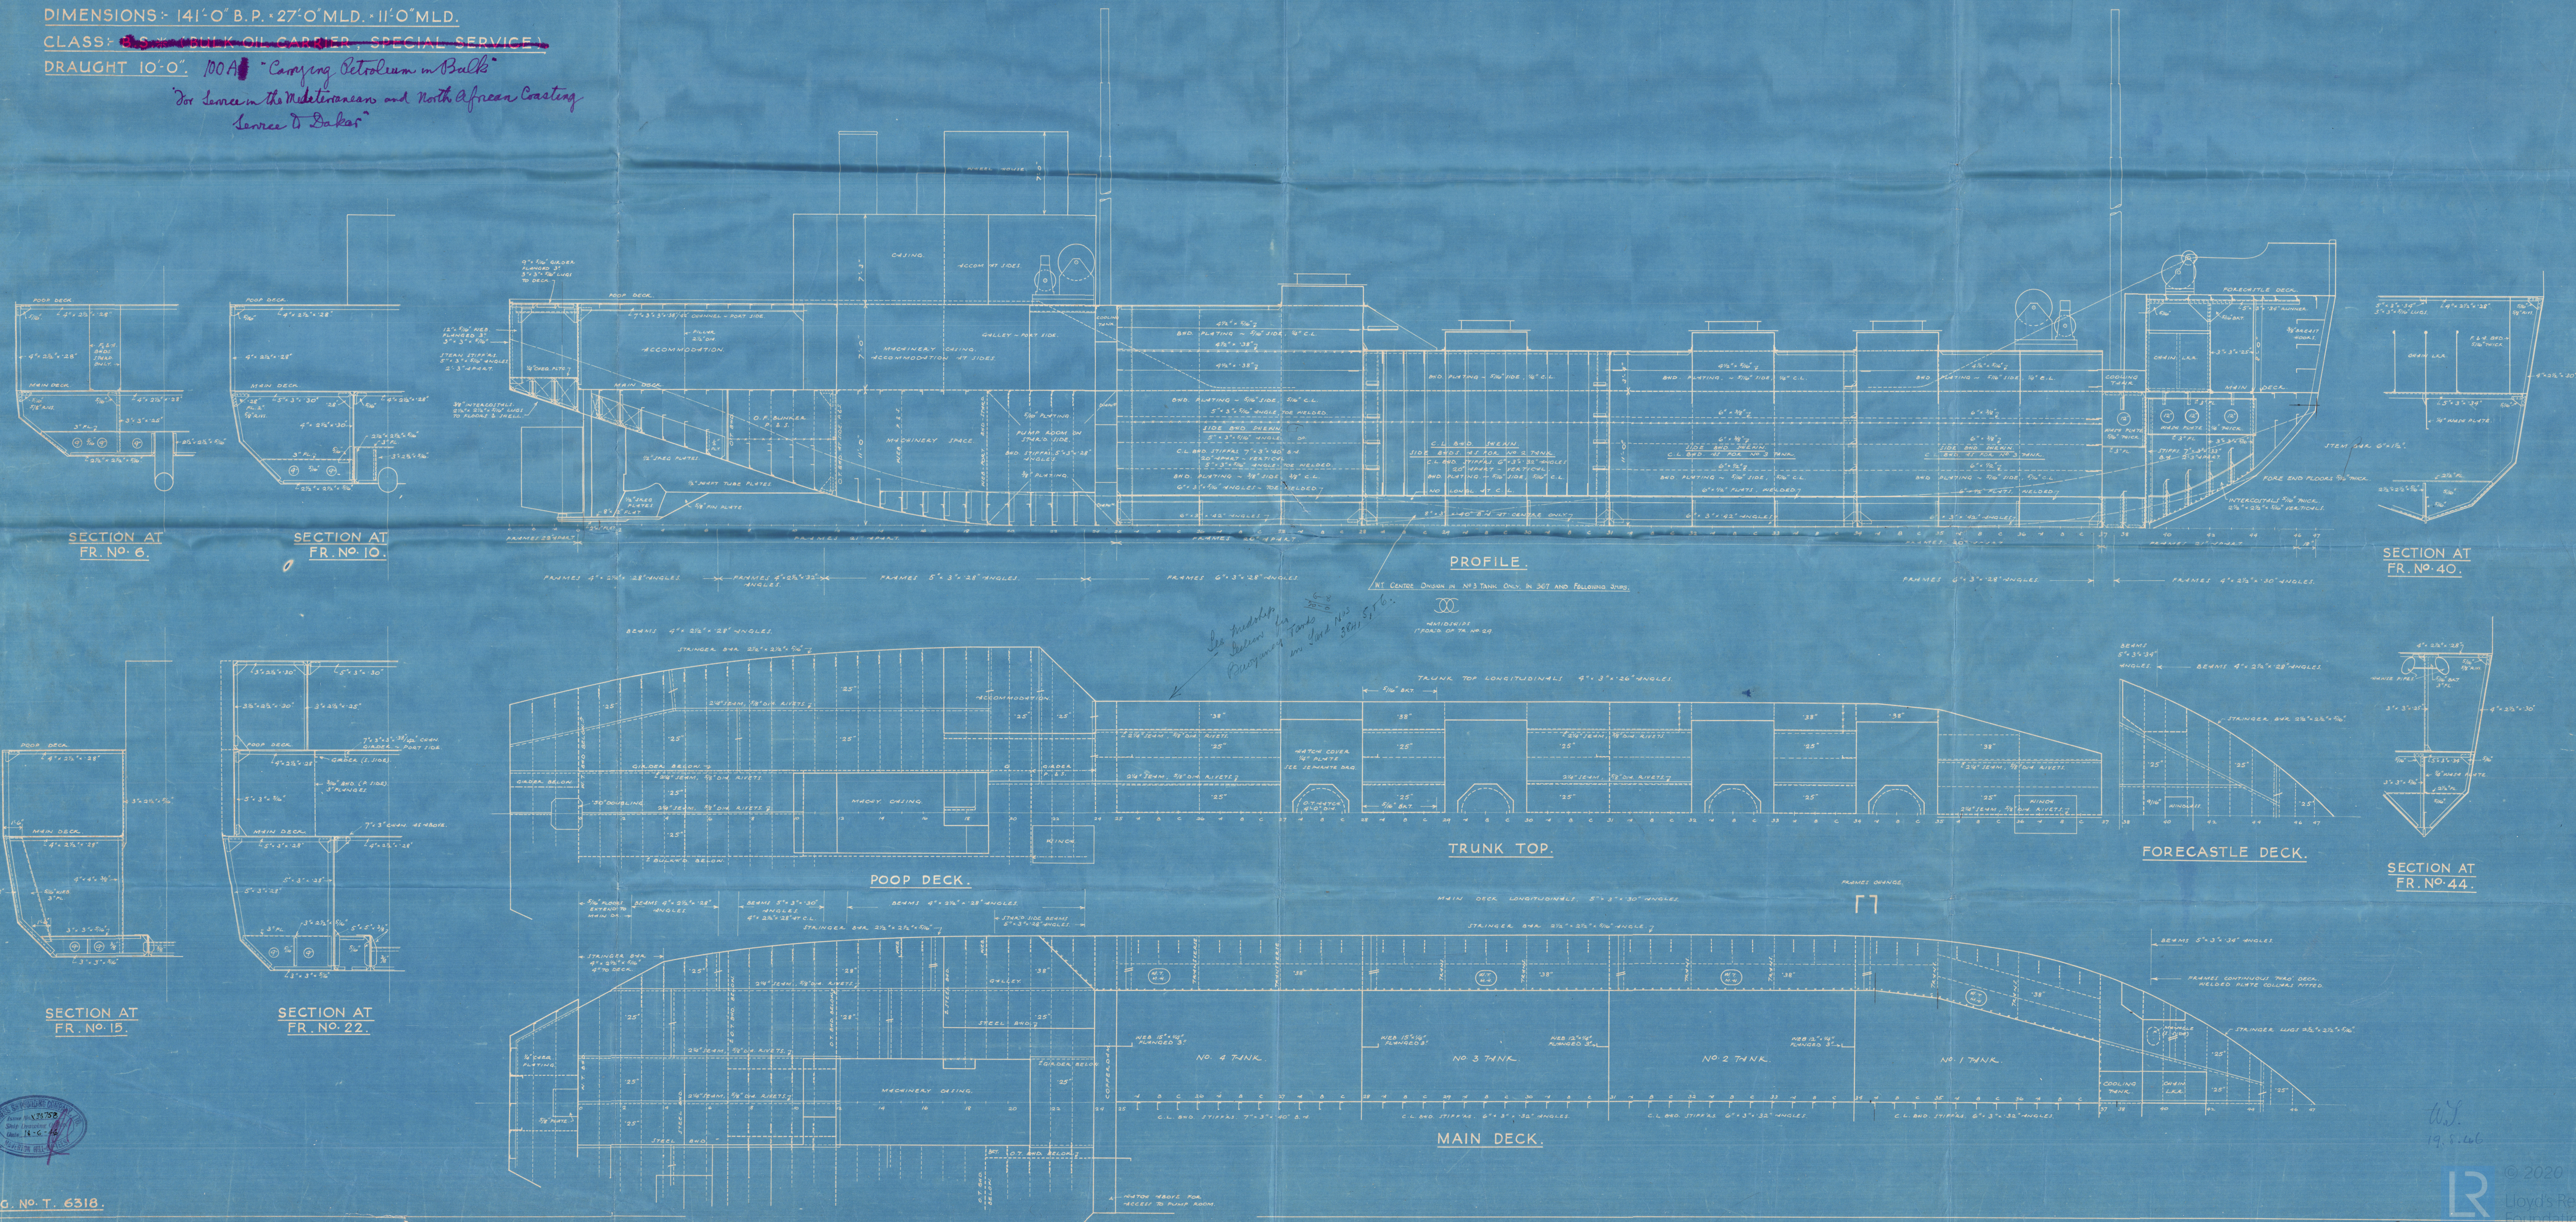



Recd with letter dated
5/7/46

Profile & Decks

"Lucia II." *

Off rept No. 55651.
Furness S.B.

2

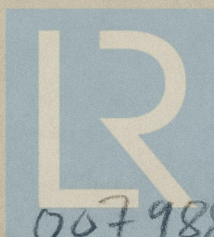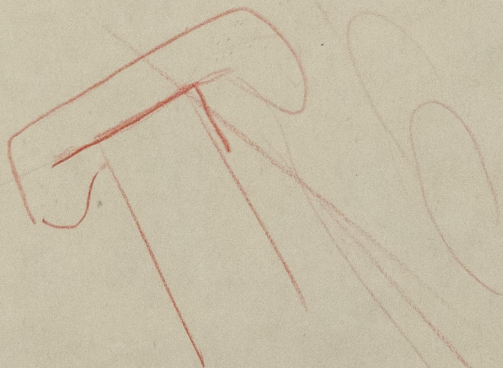

© 2020

Lloyd's Register

007988-607997-0101