

No. 309.  


Scale  $\frac{1}{4}$  = one Foot.

Length L.P. 154' 0"


Breadth 26' 10"

Depth 12' 3"



(Holland)

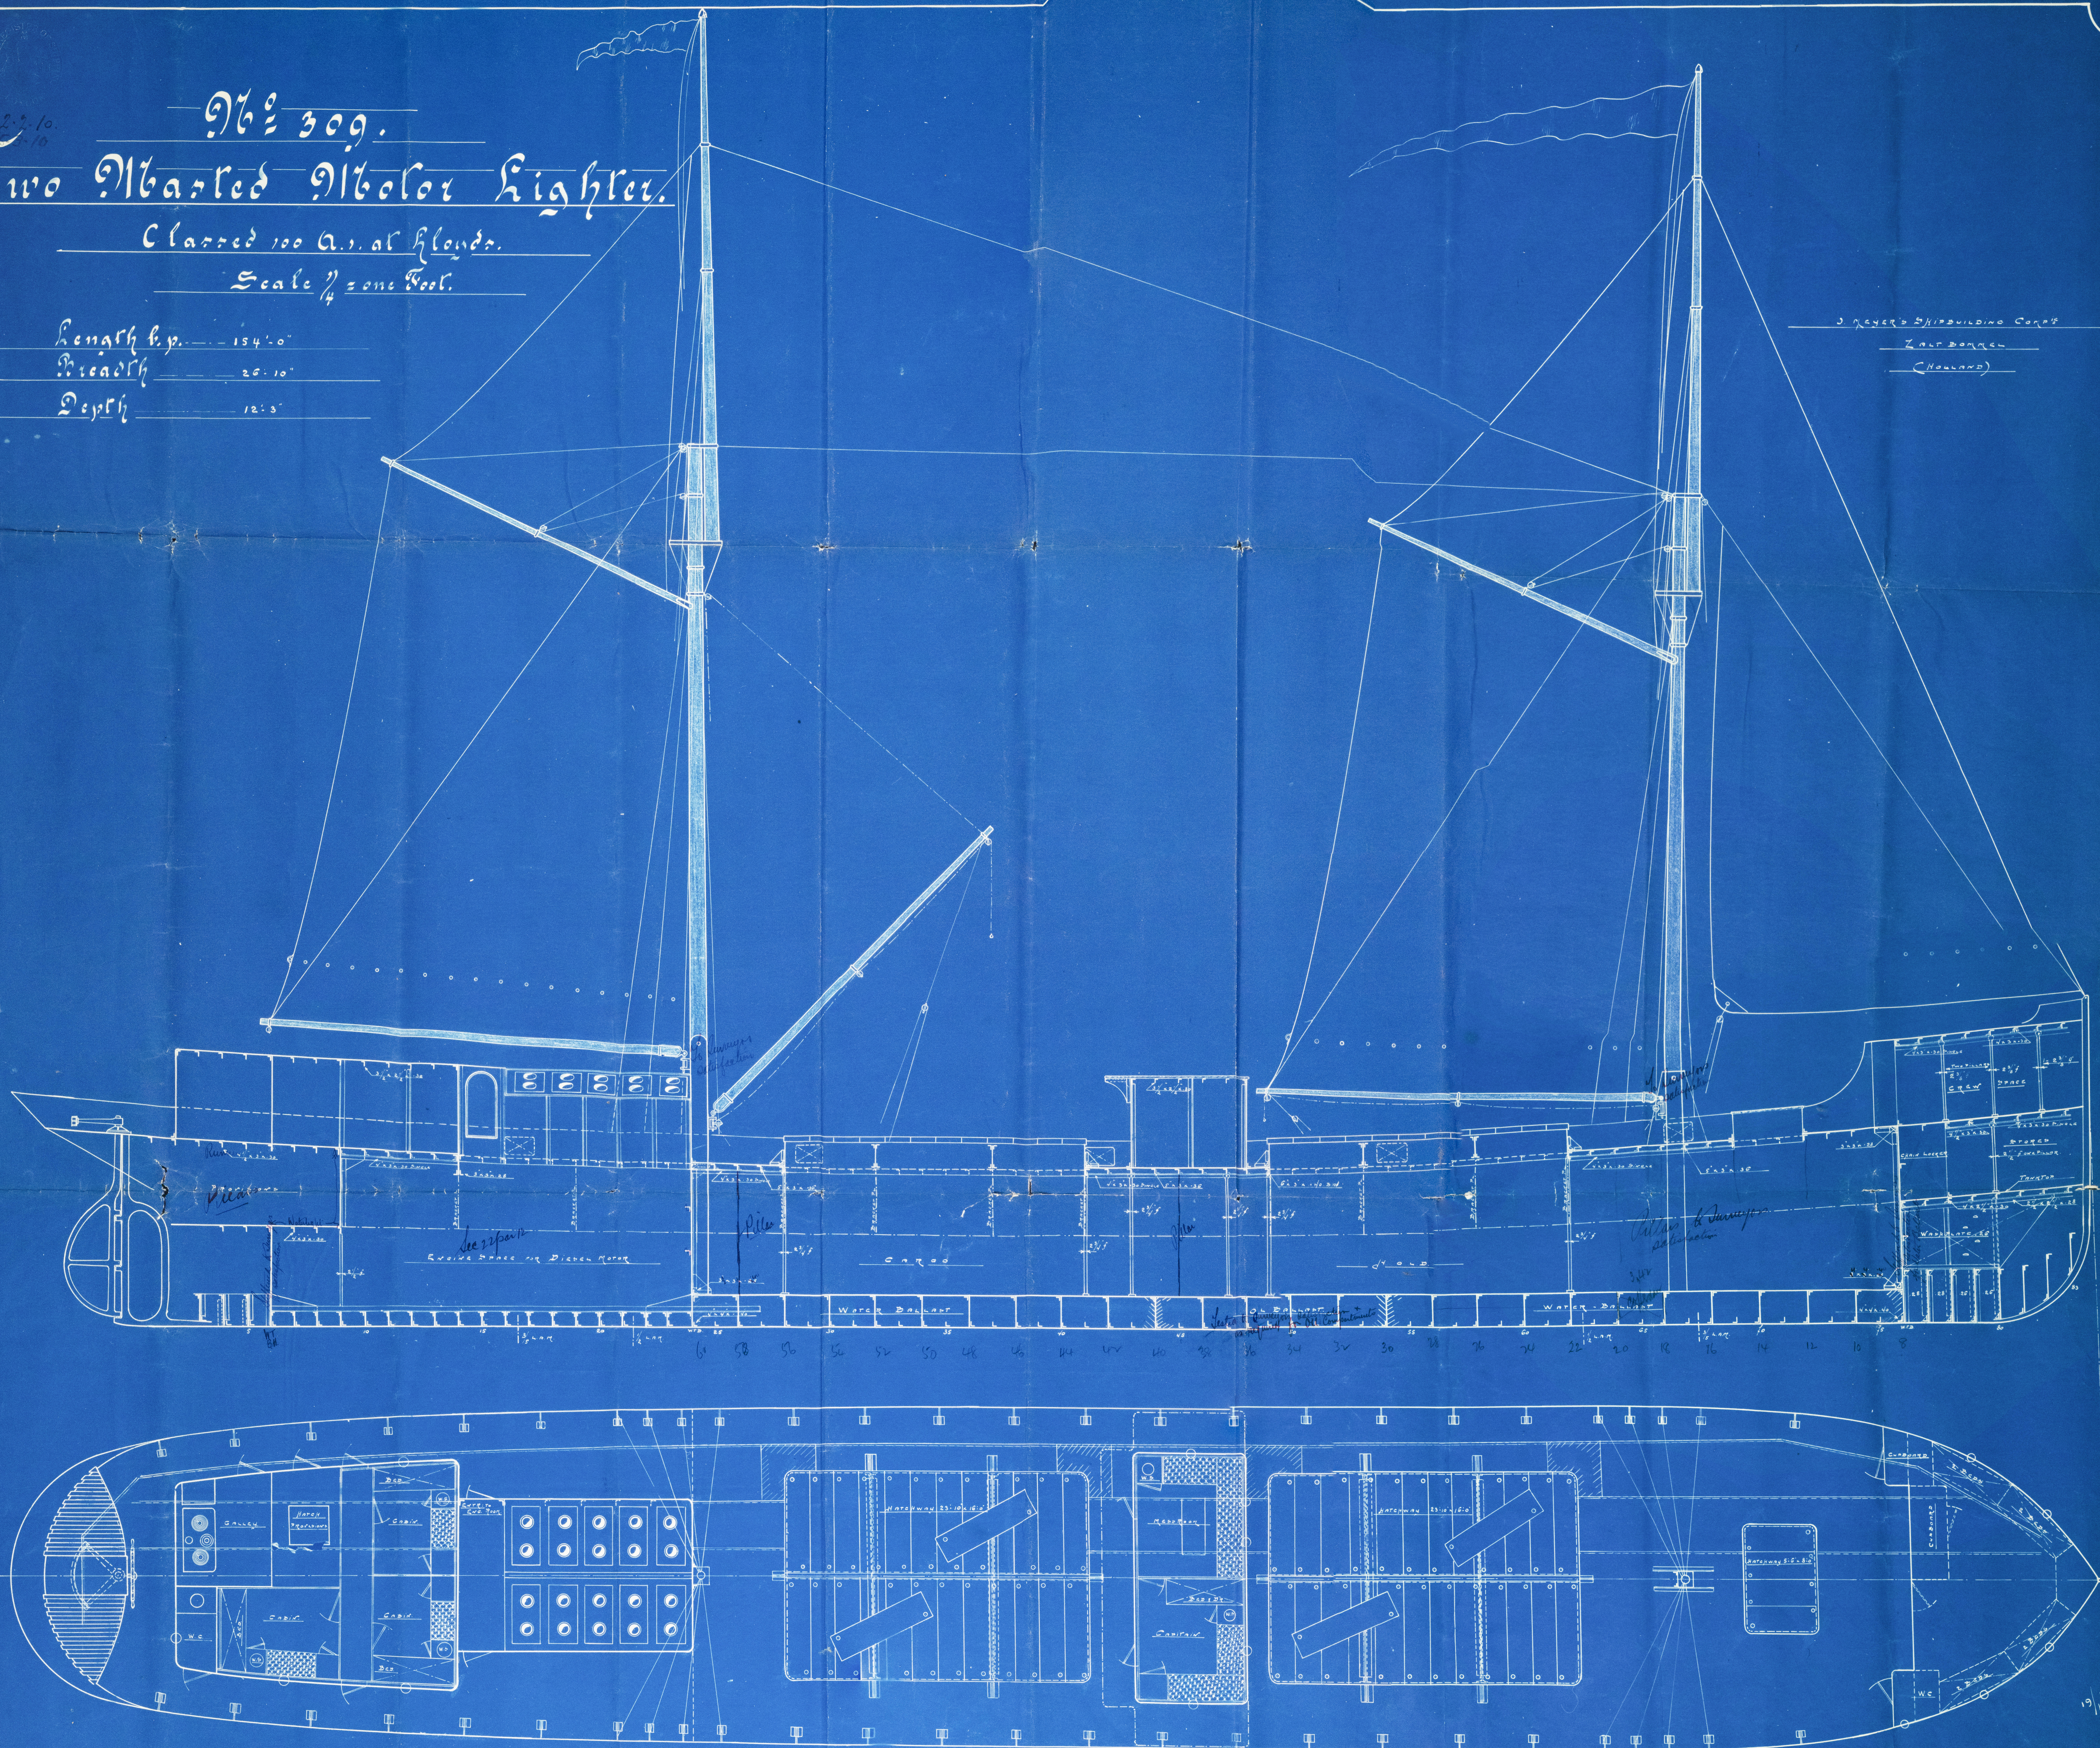

11/2/10

001988-007997-0181



"Esquadr"  
Cornelio


Amo 4 1884.

Mejor Shipbuilding

Nº 309.

Motor Schooner

Prof. & Desplome.

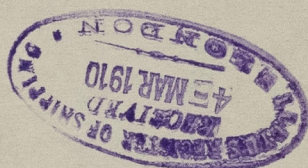

© 2020

Lloyd's Register

007988-007997-0181