


CLASSE + 100 A1 LLOYD'S REGISTER E REGISTRO ITALIANO

Scala 1:100.

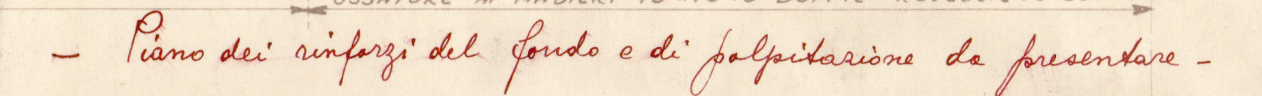

No 52875
Cantiere Odero - Sestri-Ponente

Approved profile & Deck plans for proposed
229'-0" Oil tanker.

Revised plans 15/3/24.



© 2021

Lloyd's Register
Foundation

008008-008019-0078