


MOTONAVE CISTERNA N.º 321.

RINFORZI ALLE ORDINATE 48-54-62-68-76-82.

Scala 1:20

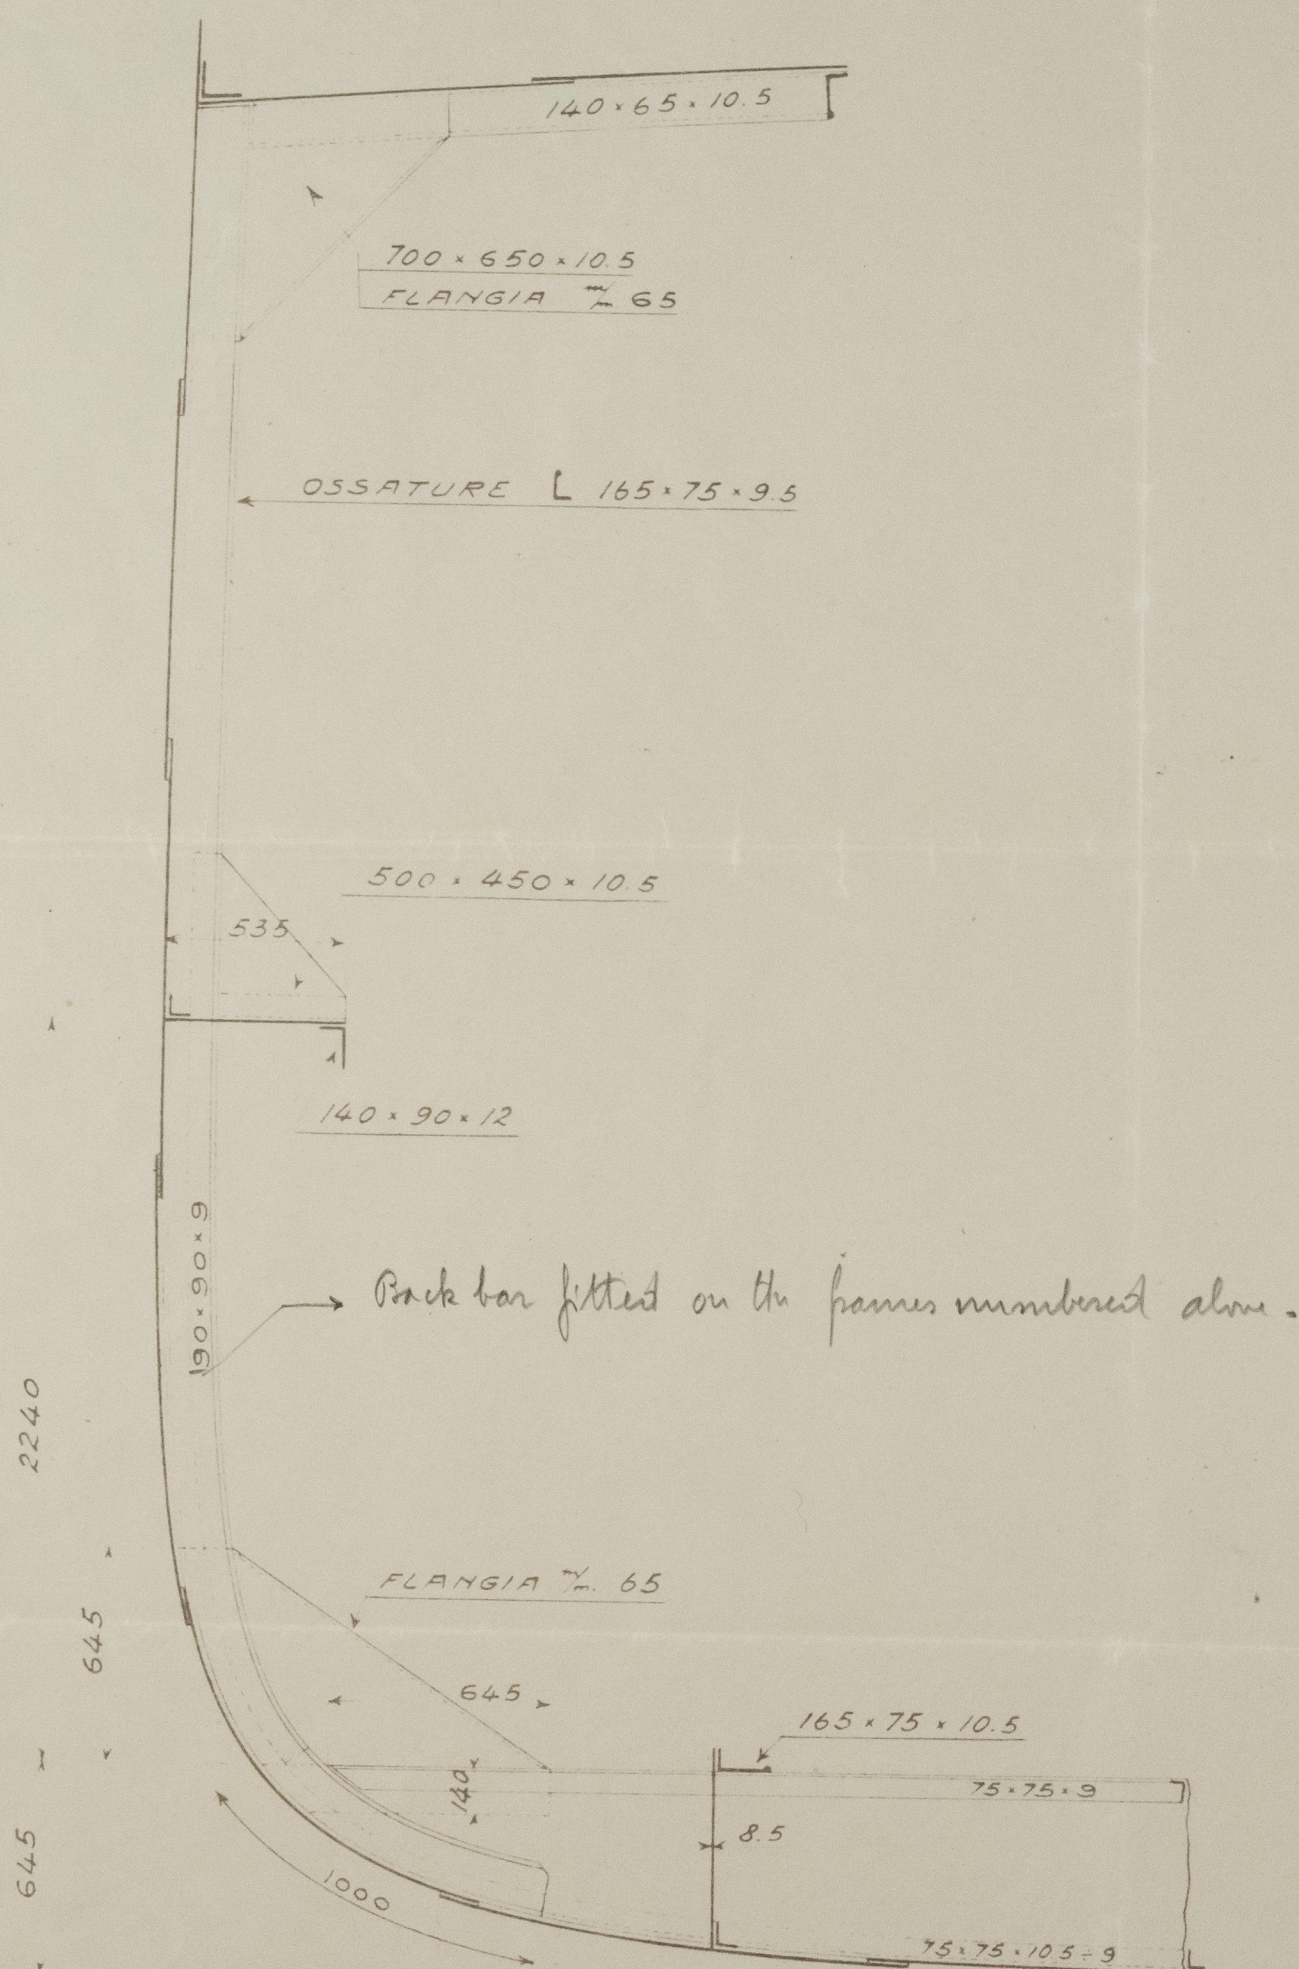

M.T.C. 3

Cantiere Odere - Porto Ponente

S.S.S. "Stetor"

Back bar fitted on frames 48-54-62-68-76-82
at the request of the Registro Italiano.



© 2021

Lloyd's Register
Foundation

008008-008019-0080