


SCALE $\frac{1}{2}" = 1 \text{ FOOT}$

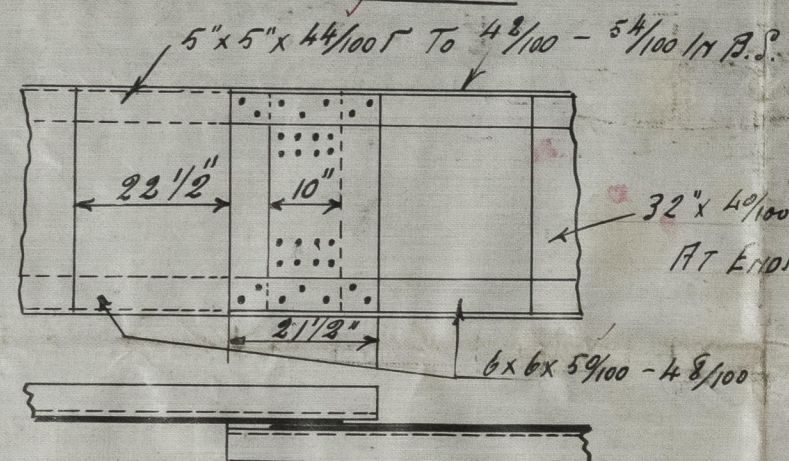

13. 9. 13
7. 10. 13




PRINCIPAL DIMENSIONS

LENGTH BETWEEN P.P.	210'-3"
BREADTH MOULDED	31'-6"
DEPTH MOULDED	15'-7"


S. S. N^o 70 & 71

PROFILE & DECK PLAN


SCALE $\frac{1}{100}^{\text{TH}}$ FULL SIZE

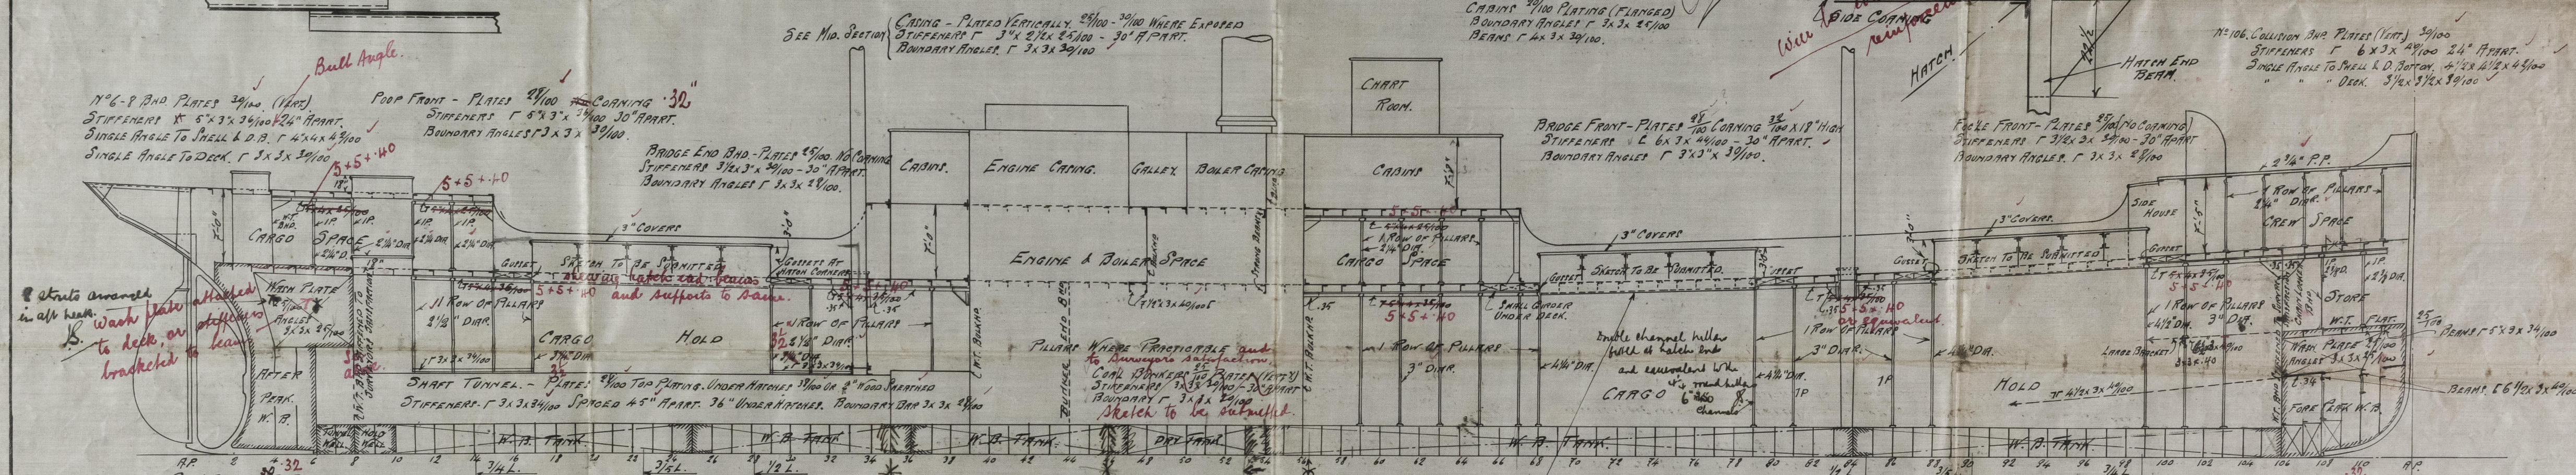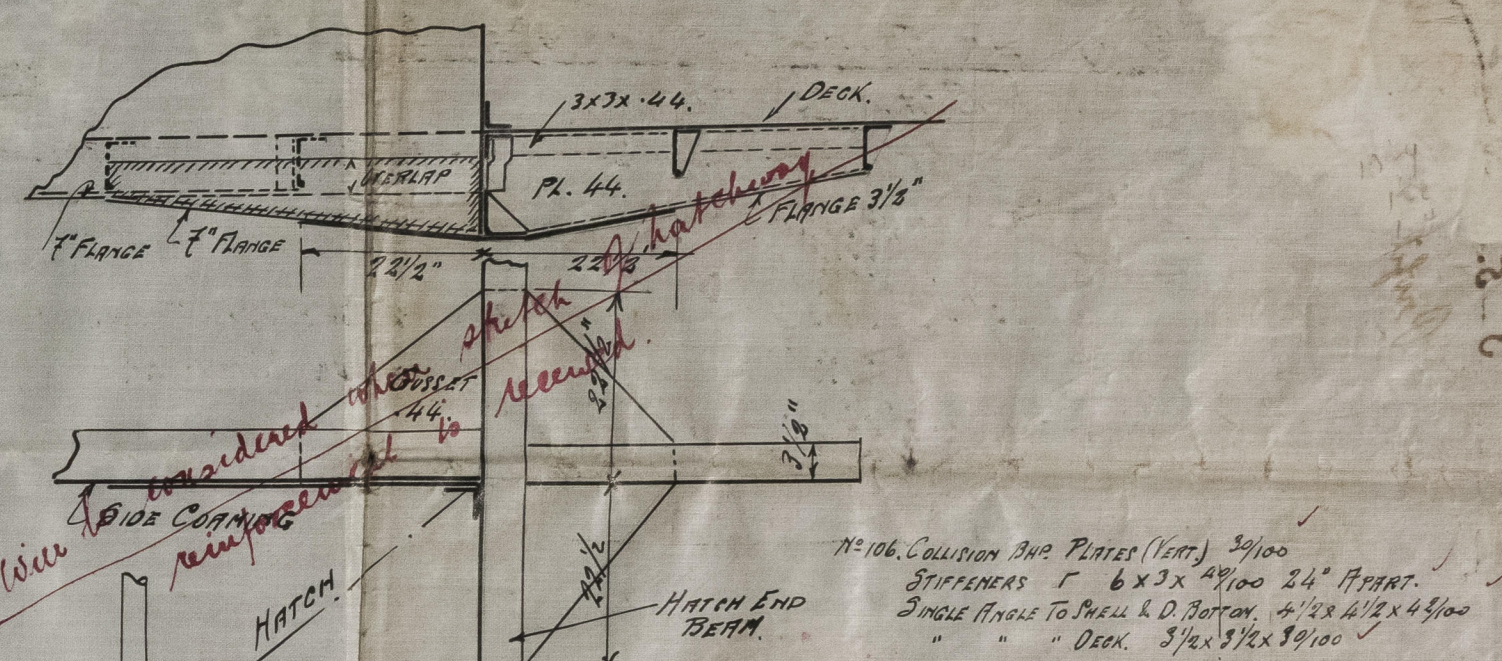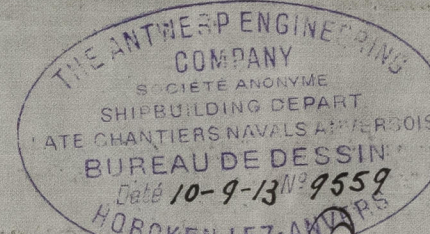


HALF PLAN OF POOP DECK.

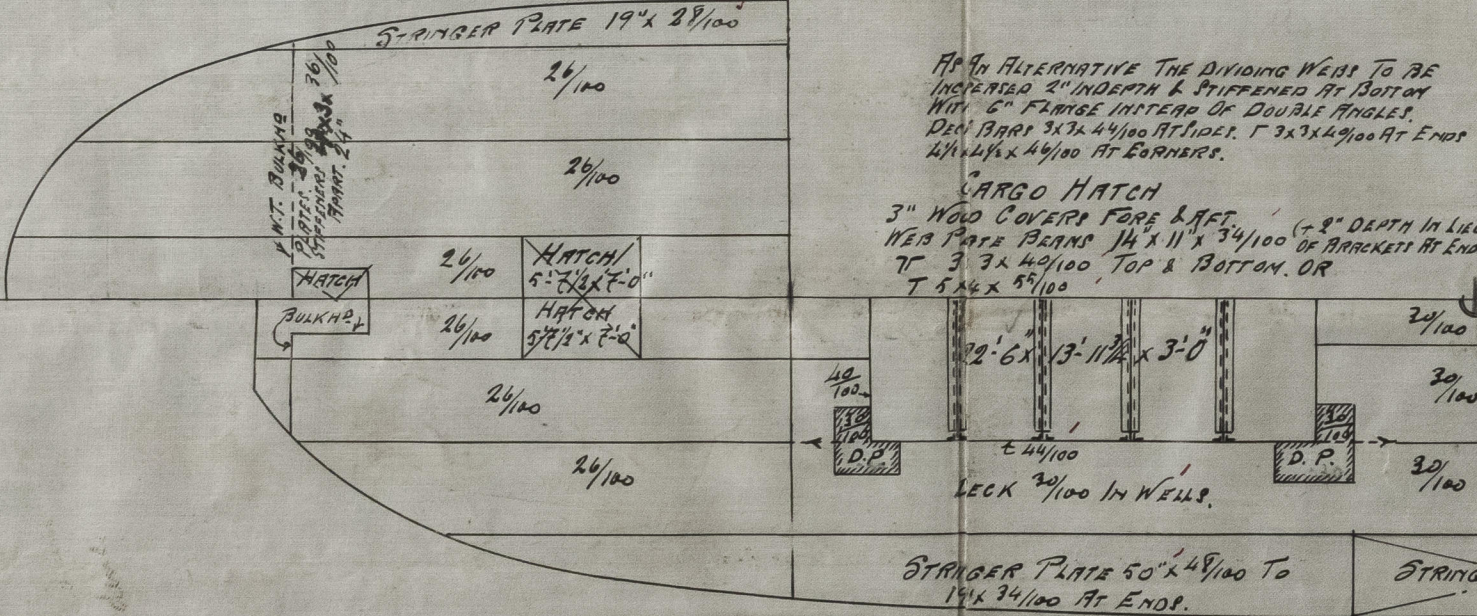


HALF PLAN OF BRIDGE DECK

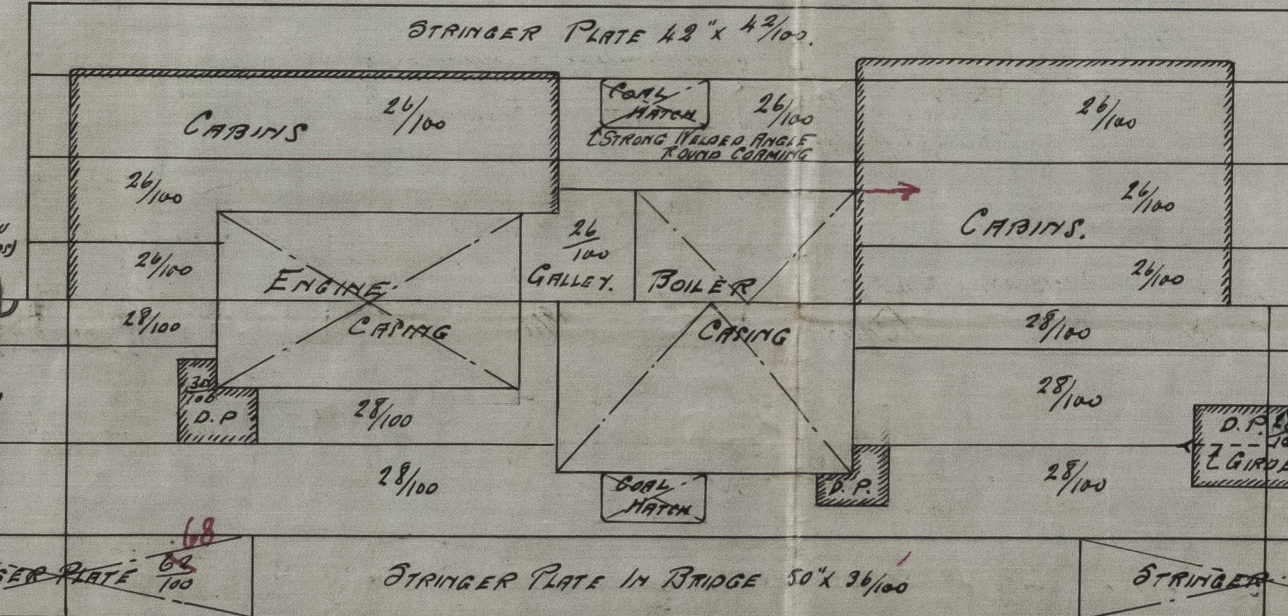

HALF PLAN OF FORECASTLE DECK

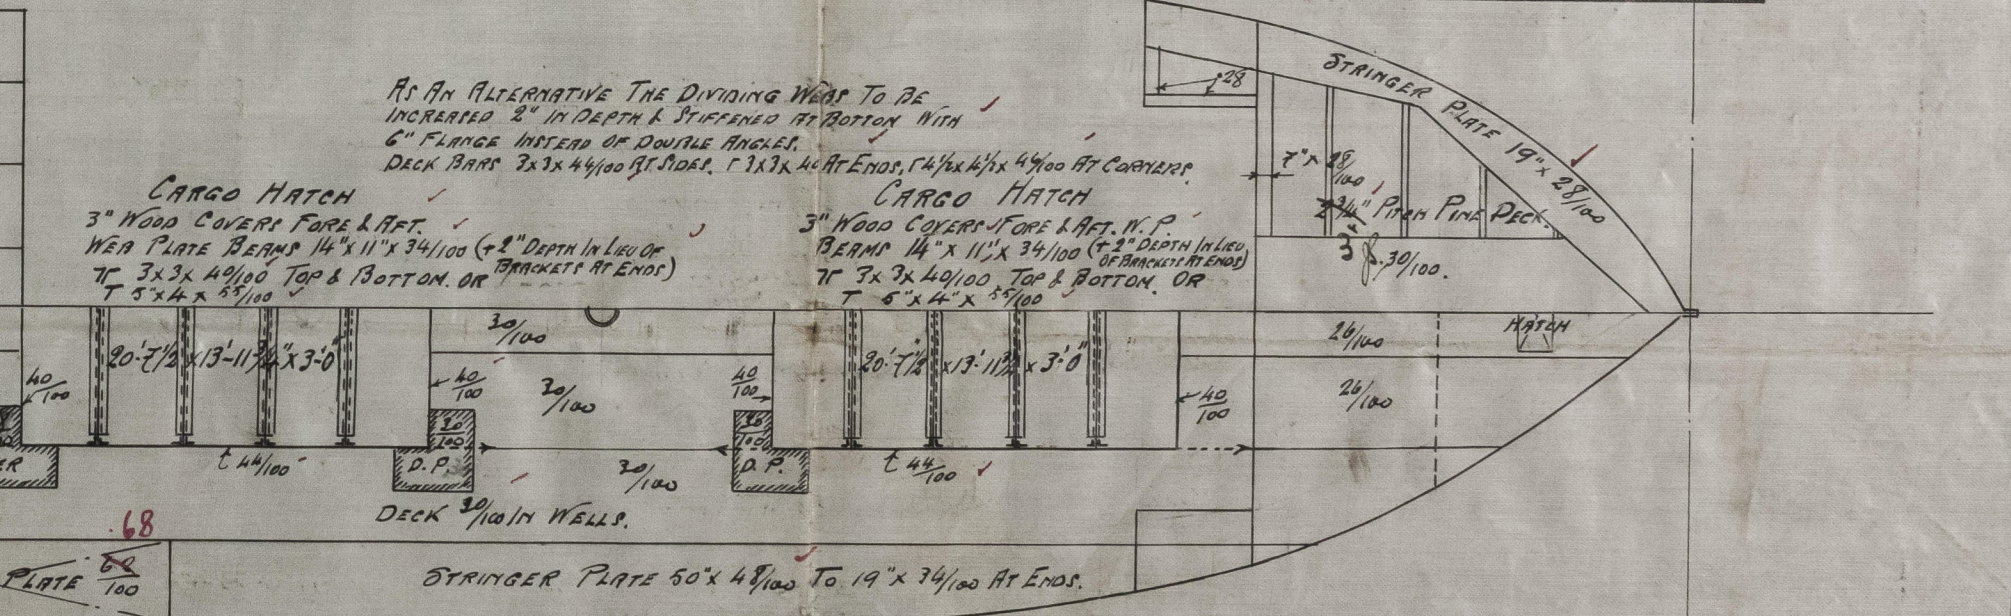

HALF PLAN OF MAIN DECK

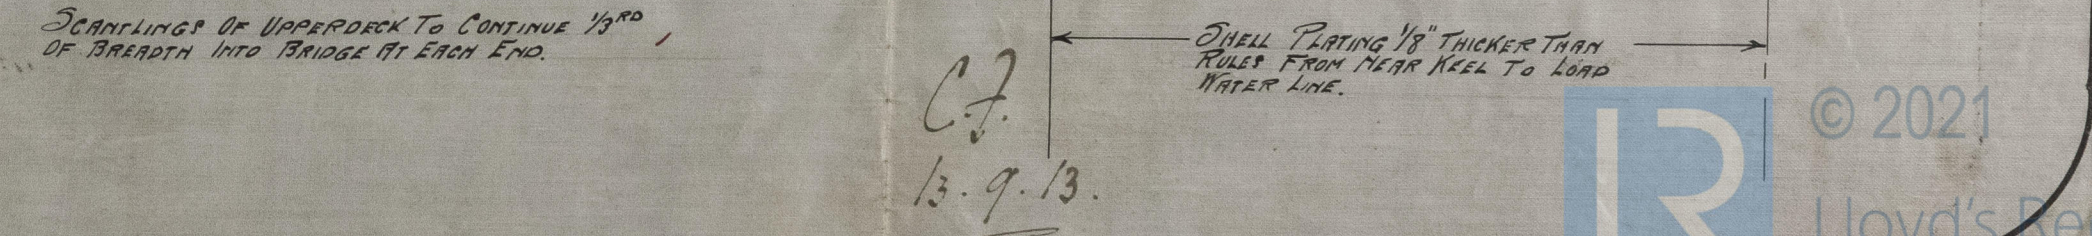

Antwerp Eng. Co.

S. S. nos 40-41

Profile & Deck plans.

Enclo.

late Cha

N. N. "TYLON"

70 as "Valborg"

Ant. 10791

71 as "Yrsa"

Ant. 10833

008008-008019-0119



© 2021

Lloyd's Register
Foundation