





## : PROFILE & DECK PLAN:

**DIMENSIONS**


LENGTH B.P.	234'-0" ✓
BREADTH M <sup>LD</sup>	55'-4" ✓
DEPTH M <sup>LD</sup>	18'-6" ✓

SCALE:  $\frac{1}{8}" = 1 \text{ FOOT}$

CLASS : LLOYDS 100 A.1

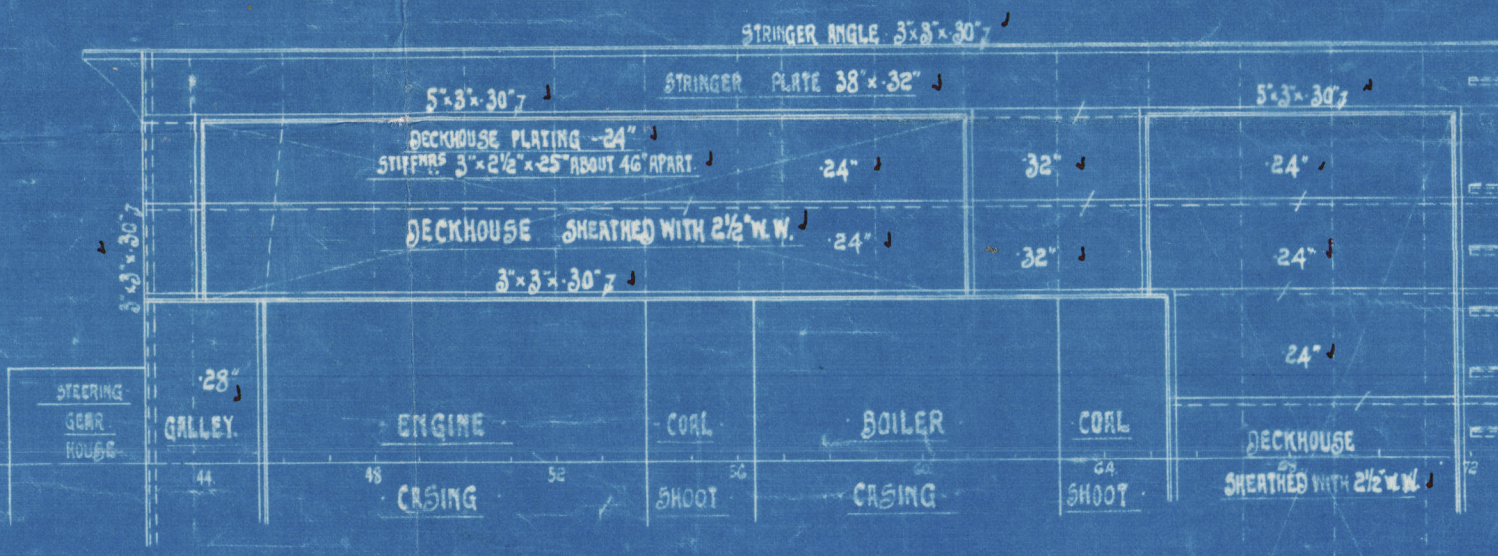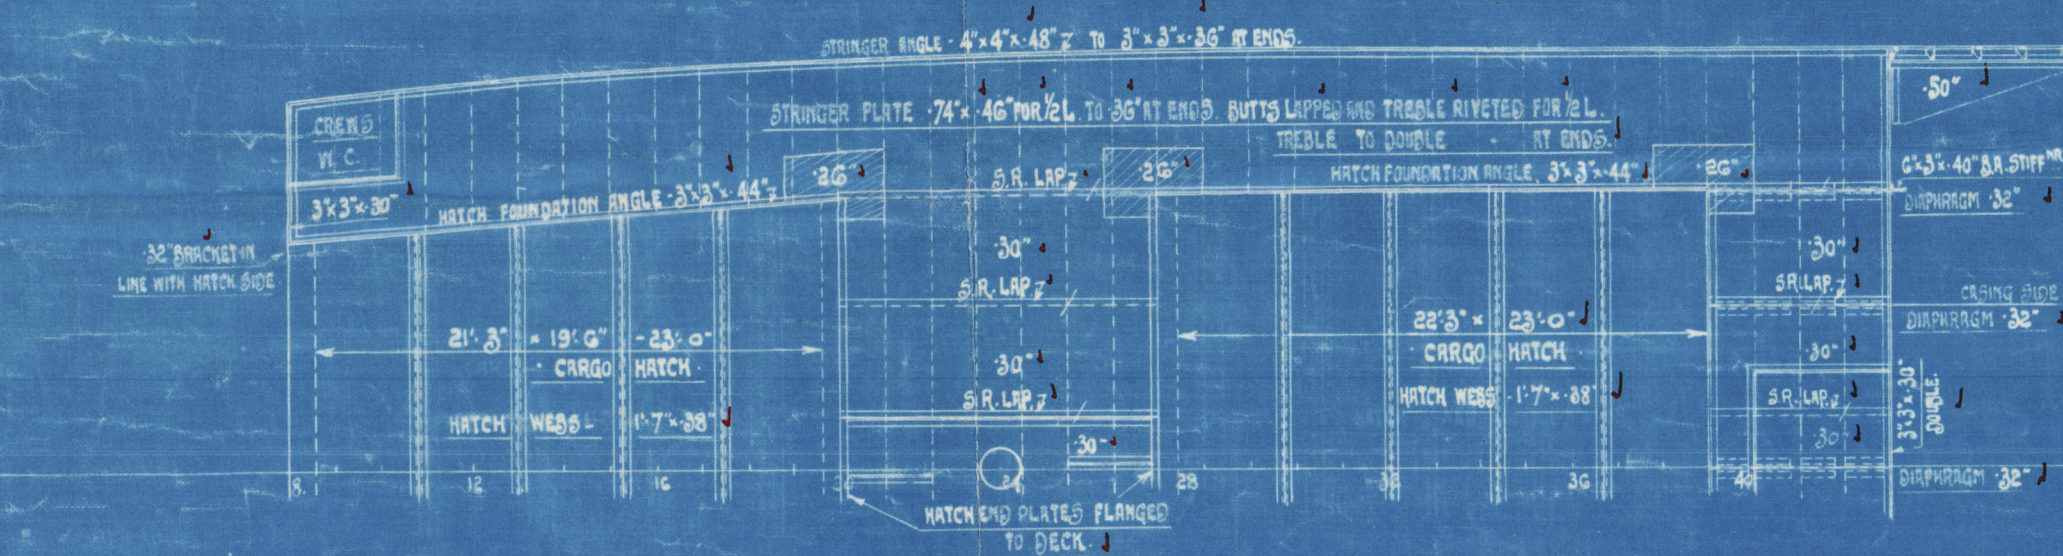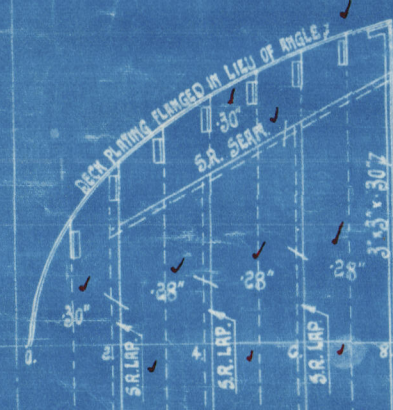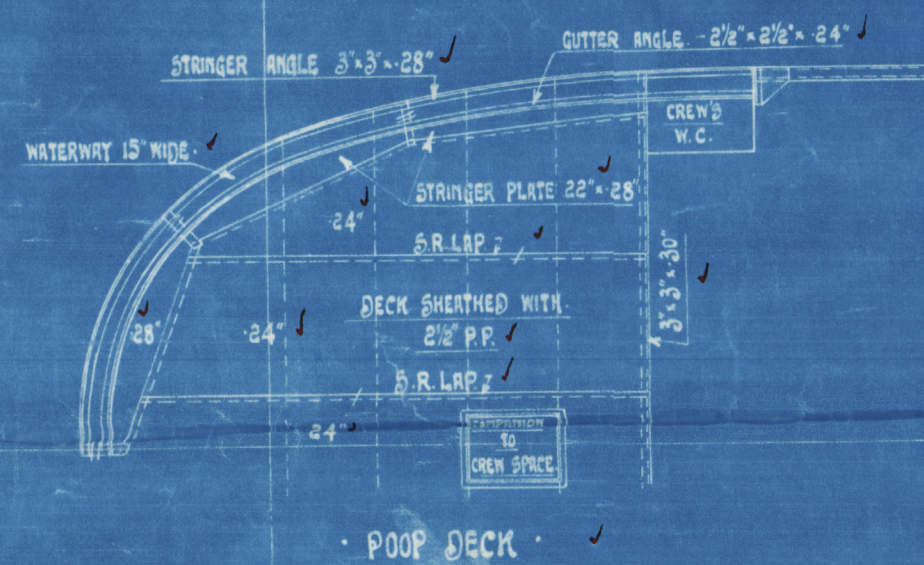

APPROVED  
LLOYDS REGISTER OF SHIPPING

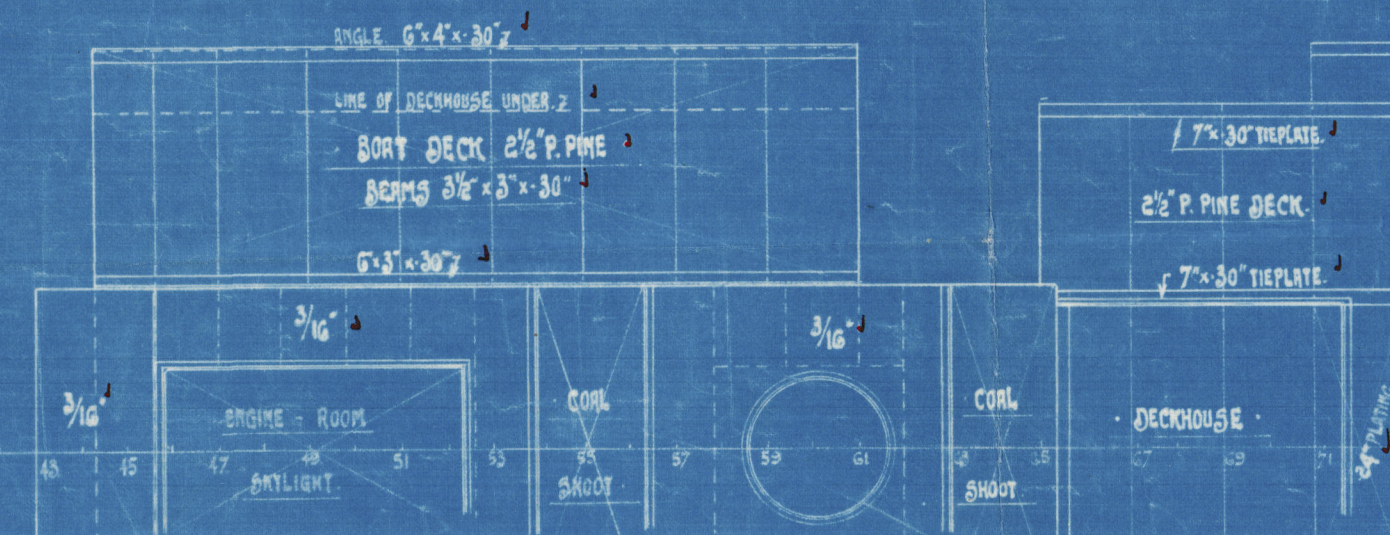

UPPER DECK ✓

55. N° 85.67.  
Drawing N° 1.  
1<sup>st</sup> August 1919.  
-008027-0123



J. LEWIS + SONS LD

N<sup>os</sup> 93 + 94.

PROFILE AND DECK PLANS.

N<sup>o</sup> 93 = "JOYCE LLEWELLYN"


ABN. REPORT N<sup>o</sup> = 13582.

N<sup>o</sup> 94. "COPTHORNE"

ABN. REPORT N<sup>o</sup> = 13296.

n. n.

Mina

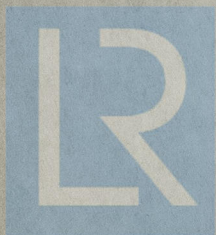

© 2020

Lloyd's Register  
Foundation

008020-008027-0123