
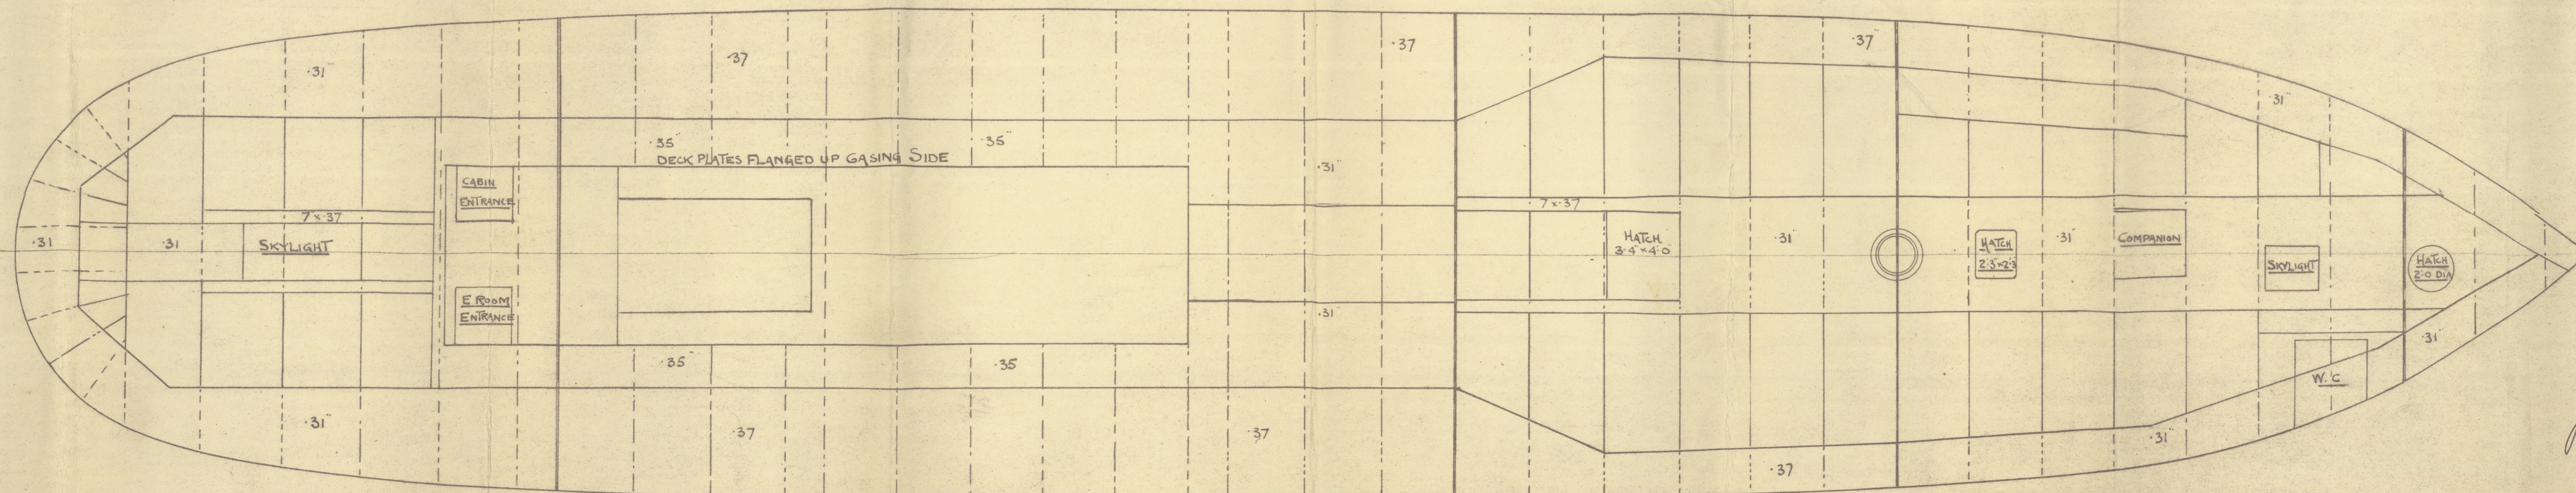


19.6.14  
14.7.14

# PROFILE & DECK PLAN.

N<sup>os</sup> 617 & 18.  
DIMS 112-0BP x 22-6 EXT x 13-2 MLD  
SCALE 1/4" = 1"



PLAN No. 4431  
FOR ENCLOSURE TO  
MESSRS LLOYD'S SURVEYOR  
HULL FROM  
COCHRANE & SONS, LTD.  
SHIPBUILDERS, SELBY  
DATE 12/6/14

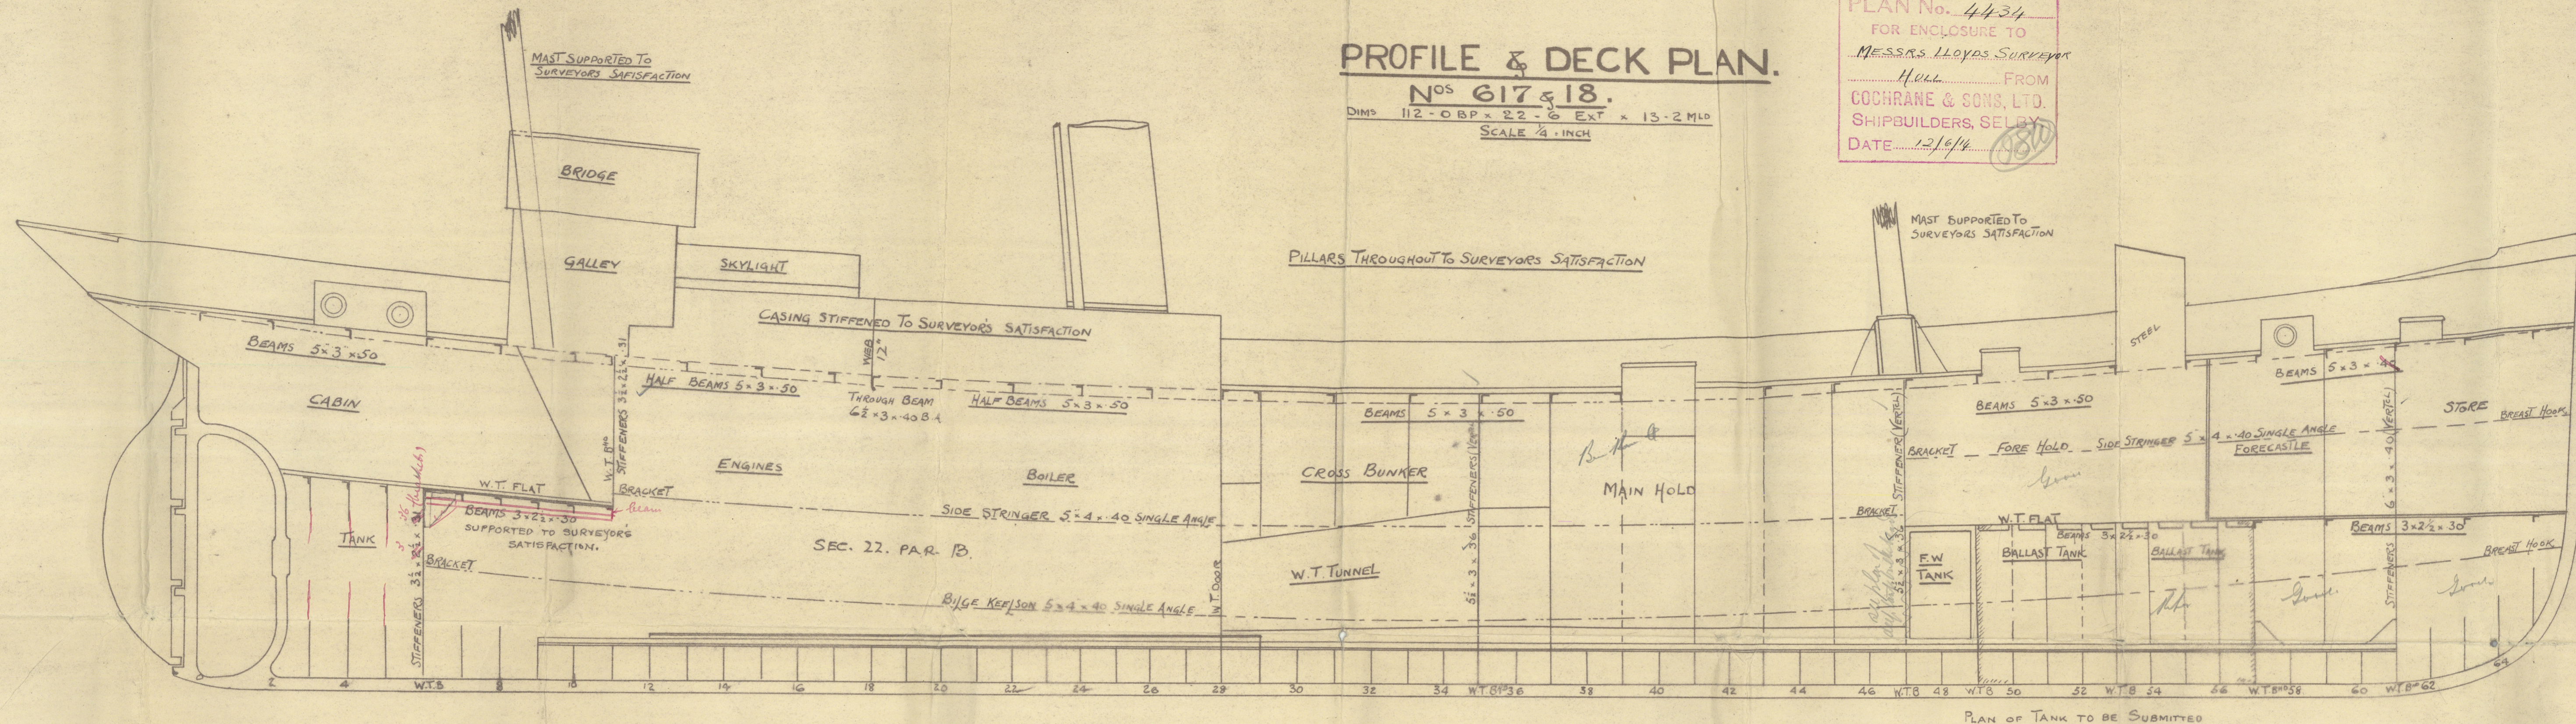

19.6.14

Colchrane's nos 617. & 618.

Profile & Deck

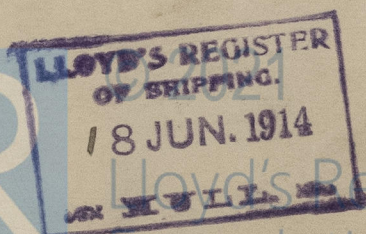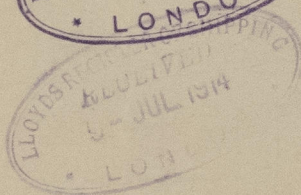

Lloyd's Register  
Foundation

008049 - 008060 - 0010


Cochranes' 20007-8

Profile Deck.

\* s/s Jamaica Hull Rpt. no.

28196

s/s Toronto Hull Rpt. no. 28222

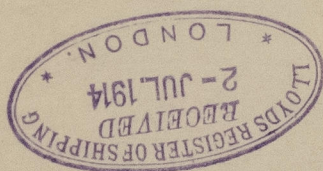

Lloyd's Register  
Foundation

008049-008060-0010