

19.6.14  
14.7.14

PLAN No. 4433.  
FOR ENCLOSURE TO  
MESSRS. LLOYD'S SURVEYOR  
HULL FROM  
COCHRANE & SONS, LTD.  
SHIPBUILDERS, SELDY.  
DATE 12/6/14 *JSW*

# MIDSHIP SECTION


STEEL SCREW FLEETERS

N<sup>o</sup> 617 & 18

DIM<sup>s</sup> 112'-0" B.P. x 22'-6" EXT x 13'-2" MLD

SCALE  $\frac{1}{2}$  INCH

To CLASS 100A1 <sup>Steam Trawler</sup> FOR FISHING PURPOSES. DECK PLATED OVER  
IN WAY OF MACHINERY SPACE. ENGINE & BOILER CASING AS  
PREVIOUSLY APPROVED

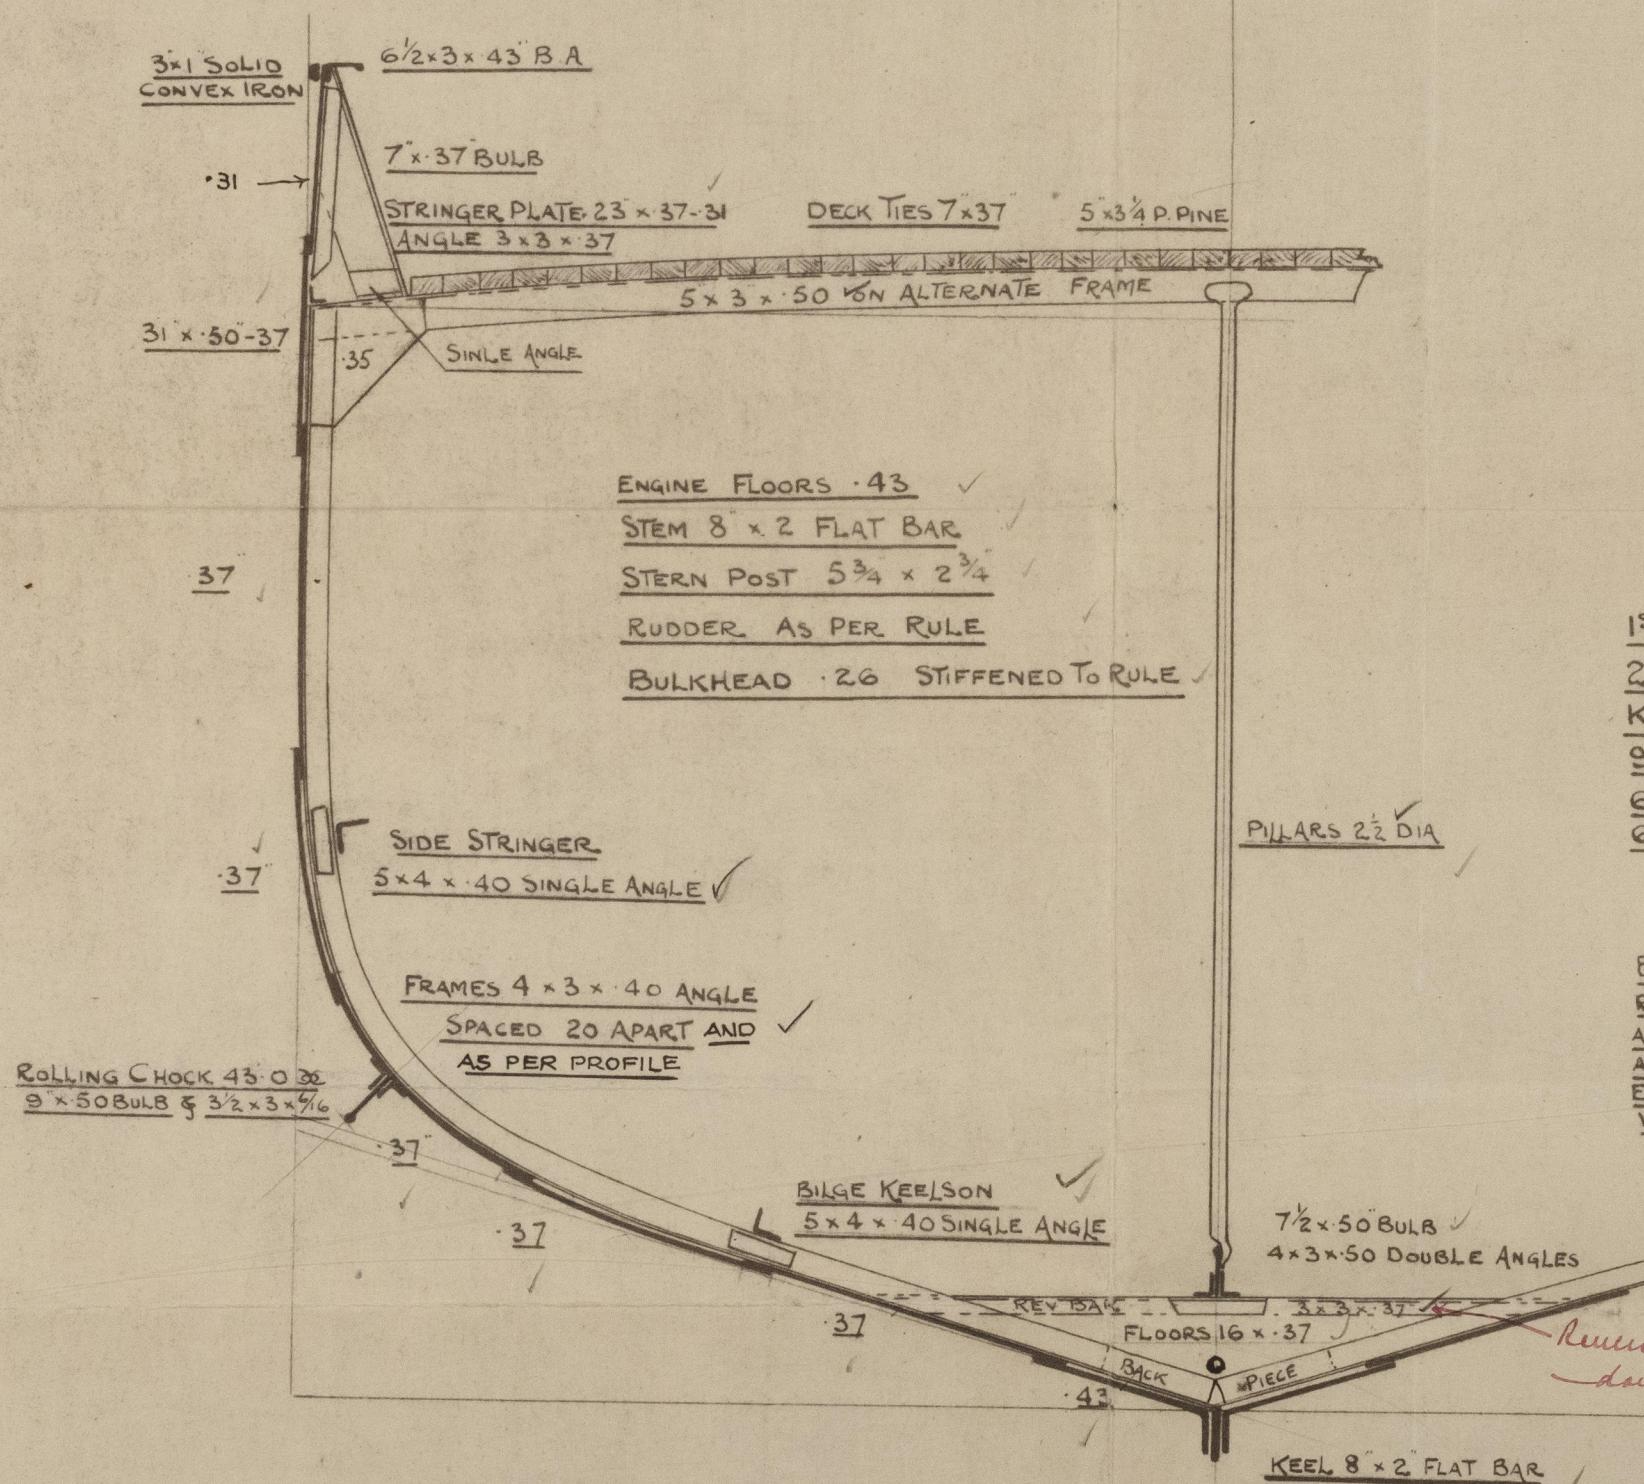

## NUMERALS

$$\begin{aligned} B+D &= 35.53 \\ L \times (B+D) &= 3979.36 \end{aligned}$$

## PROPORTIONS

$$\begin{aligned} \frac{L}{D} &= 8.51 \\ \frac{L}{B} &= 5.006 \end{aligned}$$

## EQUIPMENT

1ST BOWER ANCHOR	5 CWTs Ex STOCK	OR 6 1/2 STOCKLESS
2ND	4 1/2 ✓	" " OR 5 1/2 STOCKLESS
KEDGE	2 1/2 ✓	
90 FATHOMS	1 CHAIN	
60	5 1/2 HAWSER ✓	
60	4 WARP ✓	

## RIVETING

BUTTS OF SHELL PLATING TO BE LAPPED & DOUBLE RIVETED EXCEPT GARBOARD & SHEERSTRAKE WHICH ARE TO BE STRAPPED & DOUBLE RIVETED. ALL SINGLE RIVETED LANDINGS EXCEPT LOWER EDGE OF SHEERSTRAKE & TOP EDGE OF GARBOARD WHICH ARE DOUBLE RIVETED. BULWARKS SINGLE RIVETED.

*JSW*  
19.6.14




© 2021  
Lloyd's Register  
Foundation

008049 - 008060 - 0011




Cochran's 617 v 618

Midship Section

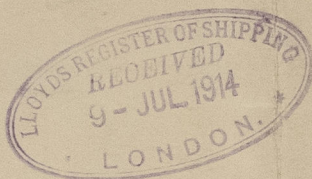

Jamaica Hull Rpt 28196  
Toronto

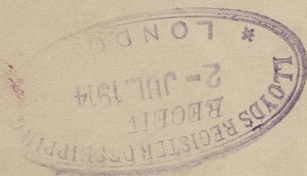

008049-008060-0011



© 2021

Lloyd's Register  
Foundation

008049-008060-0011