


SS. "Mont Agel"

PROFILE and DECK PLANS

Dimensions: 376'-0" B.P. x 52'-0" M.D. x 28'-6" to Upper Deck.

Built by:
The Greenock Dockyard, Coy., Ltd.,
GREENOCK N.B.

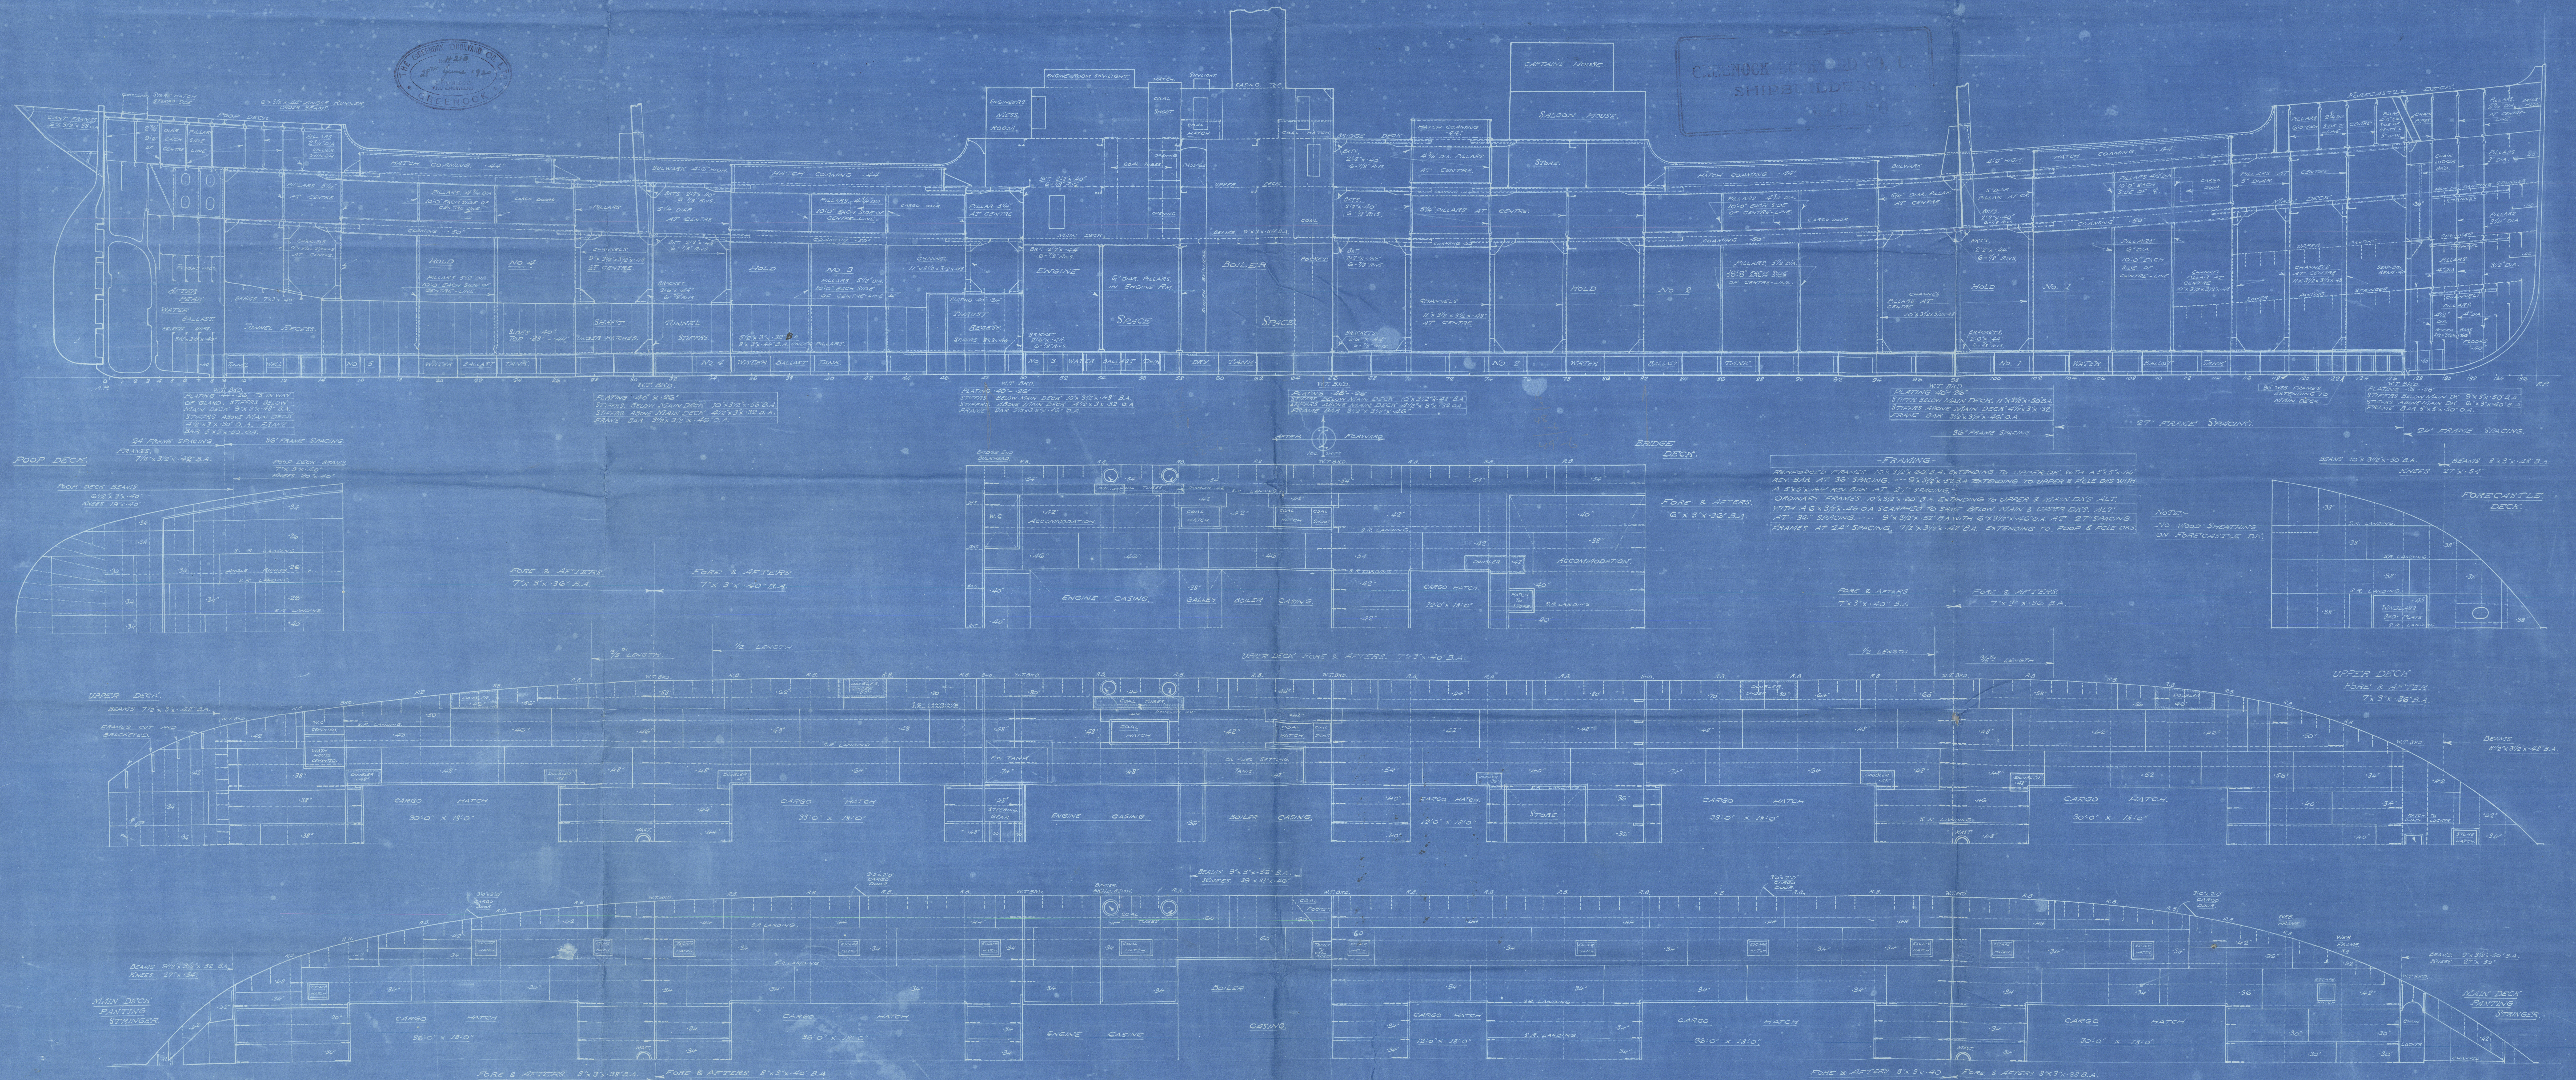

The Greenock Ship Co. Ld.

No 399

Profile & Deck Plans
as built

S. S. "Mont Agel"

GRN Rept No 17670



© 2021

Lloyd's Register
Foundation

008049-008060-0142