
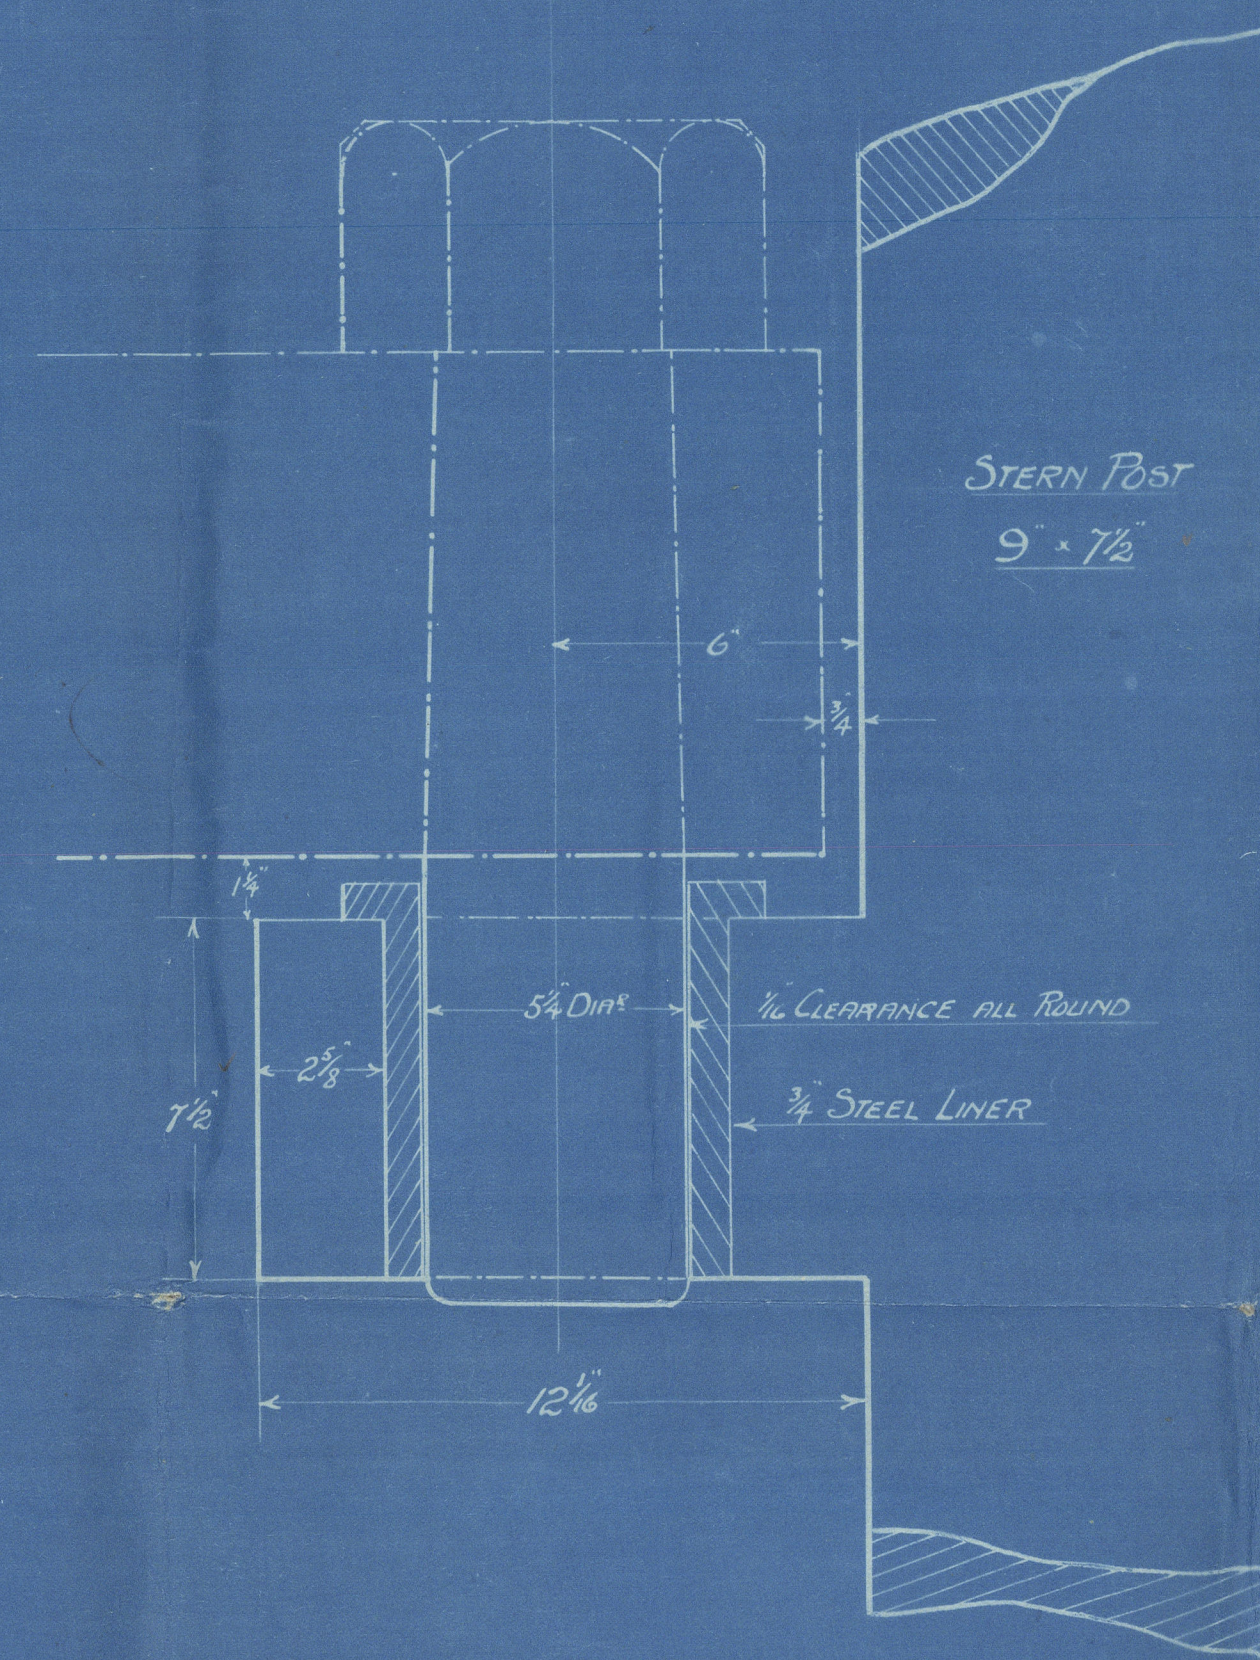



21/1/19

CHIEF ENGINEER
SHEPPARD & CO.
LONDON

SS 376-0 Steamer Plan of Sternframe. Scale $\frac{1}{2}$ " = 1 Foot. Details 3" = 1 Foot.

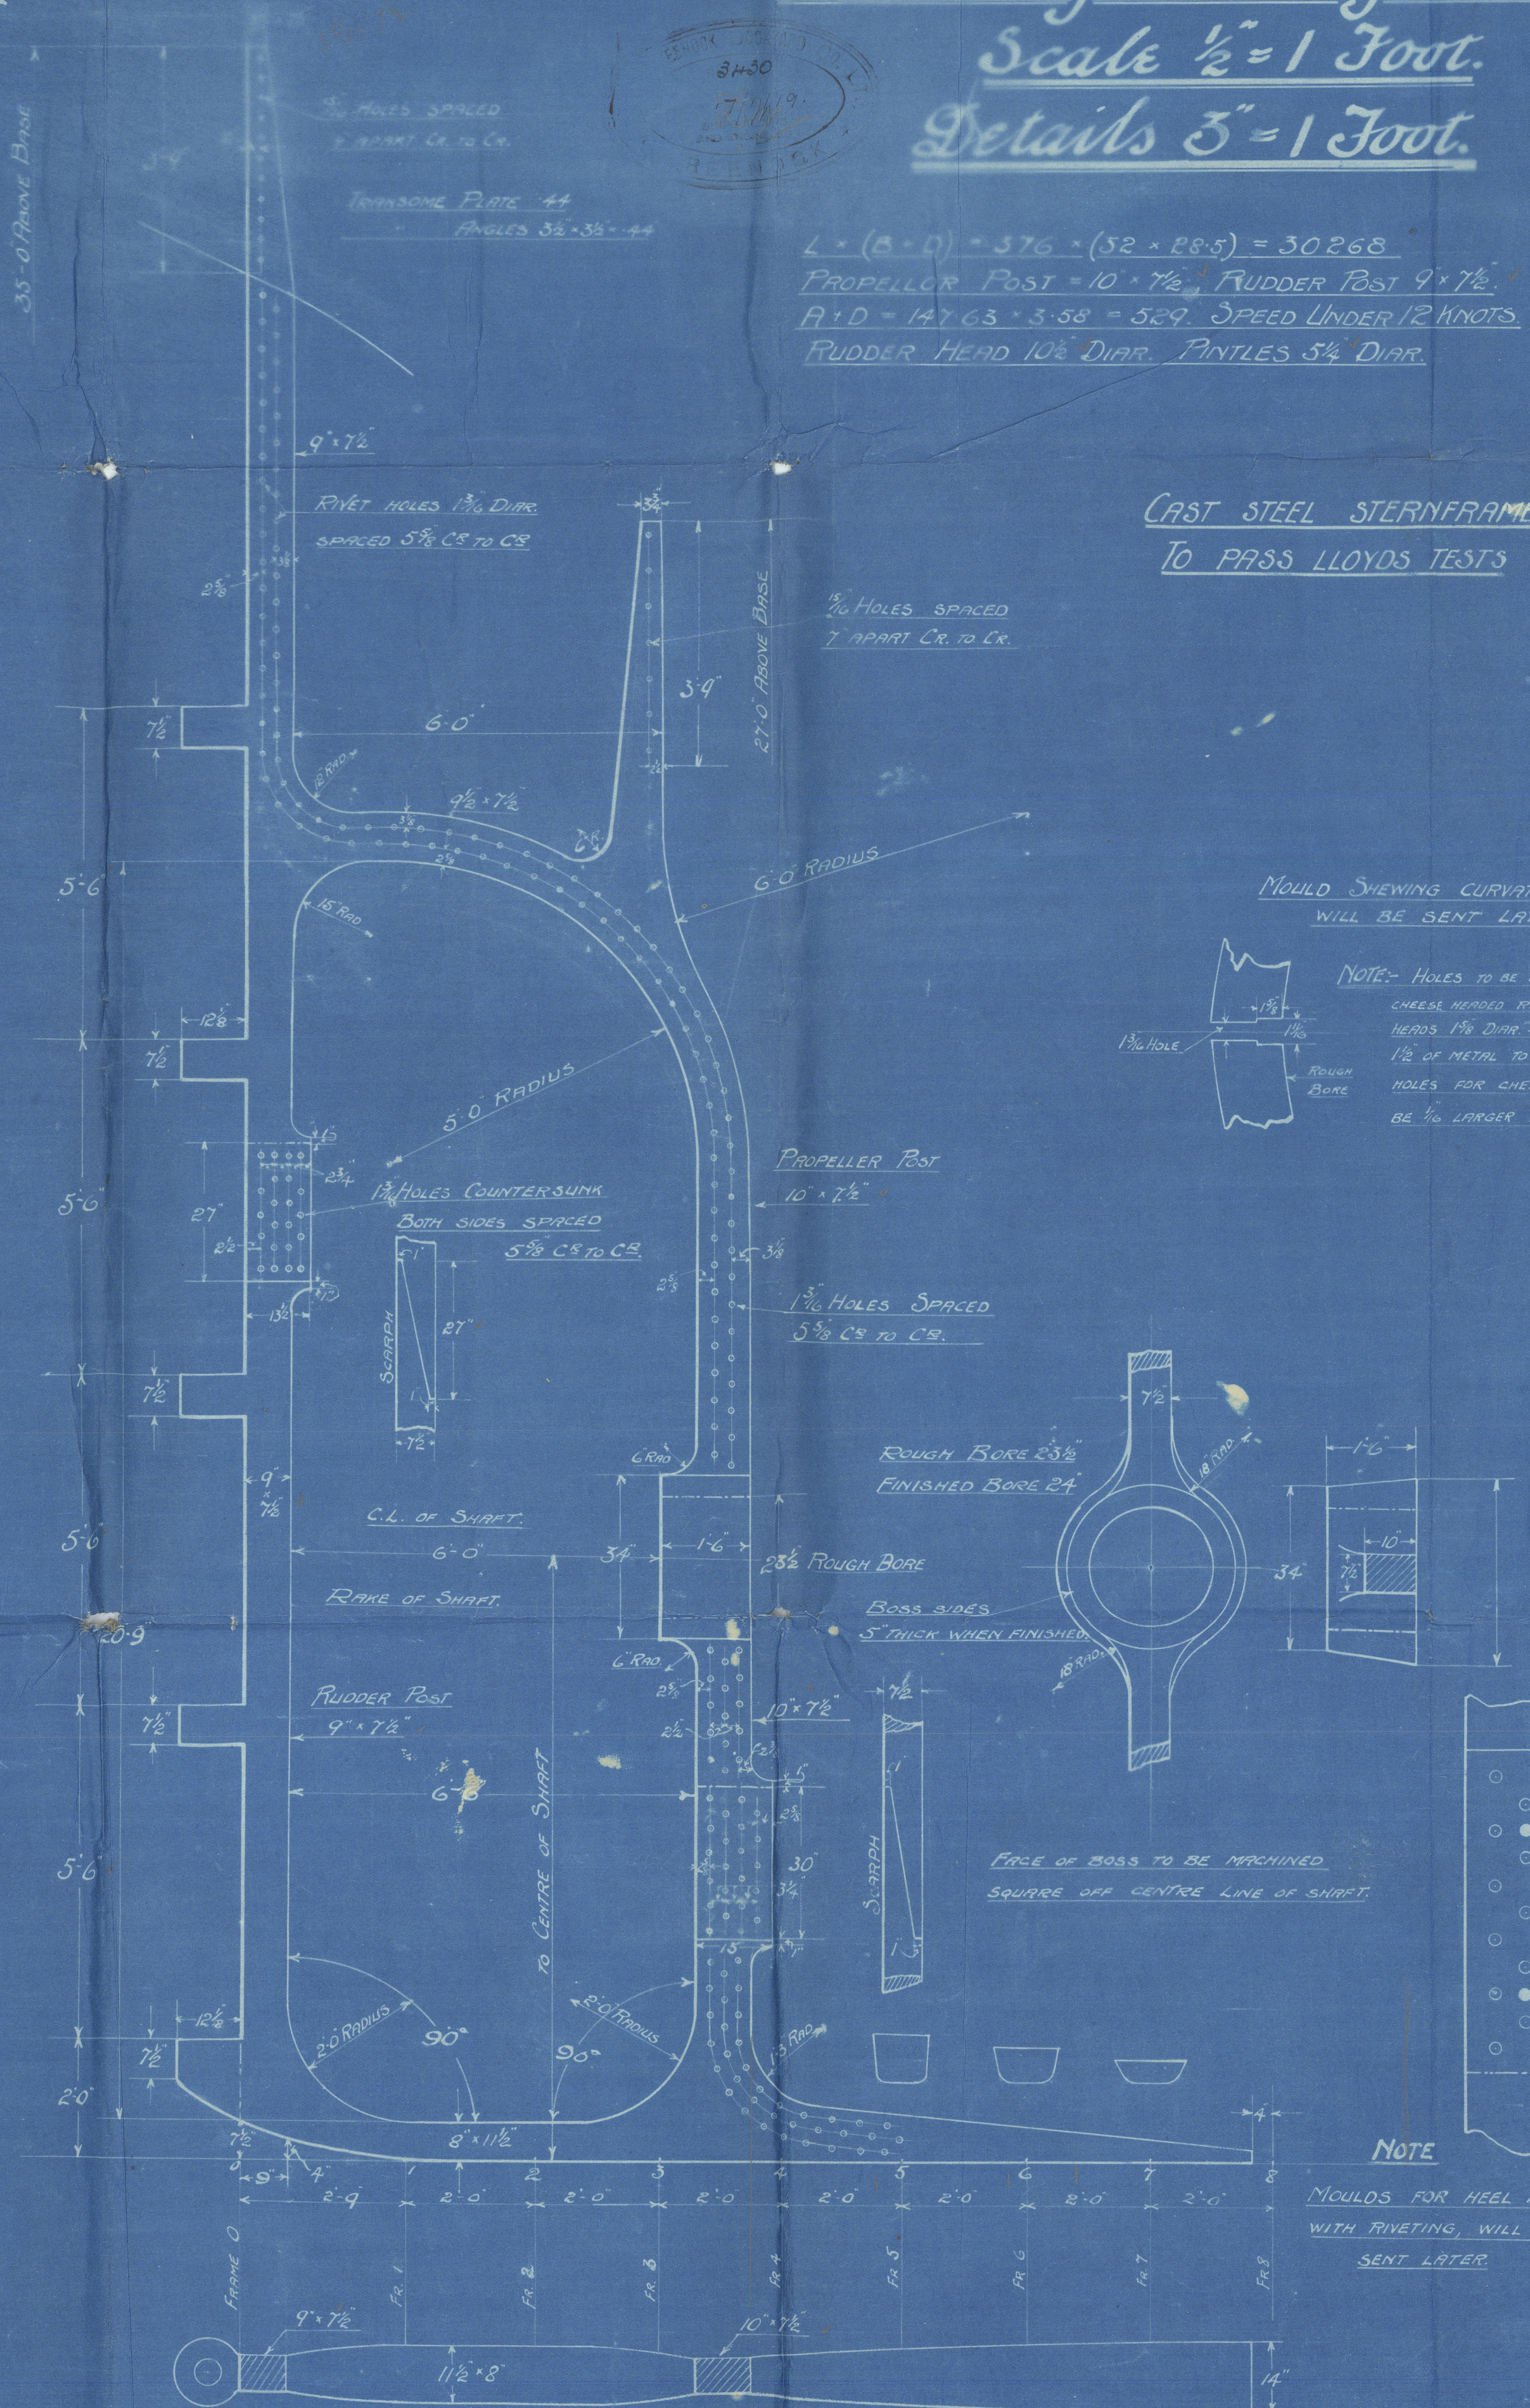

Detail of Gudgeons.

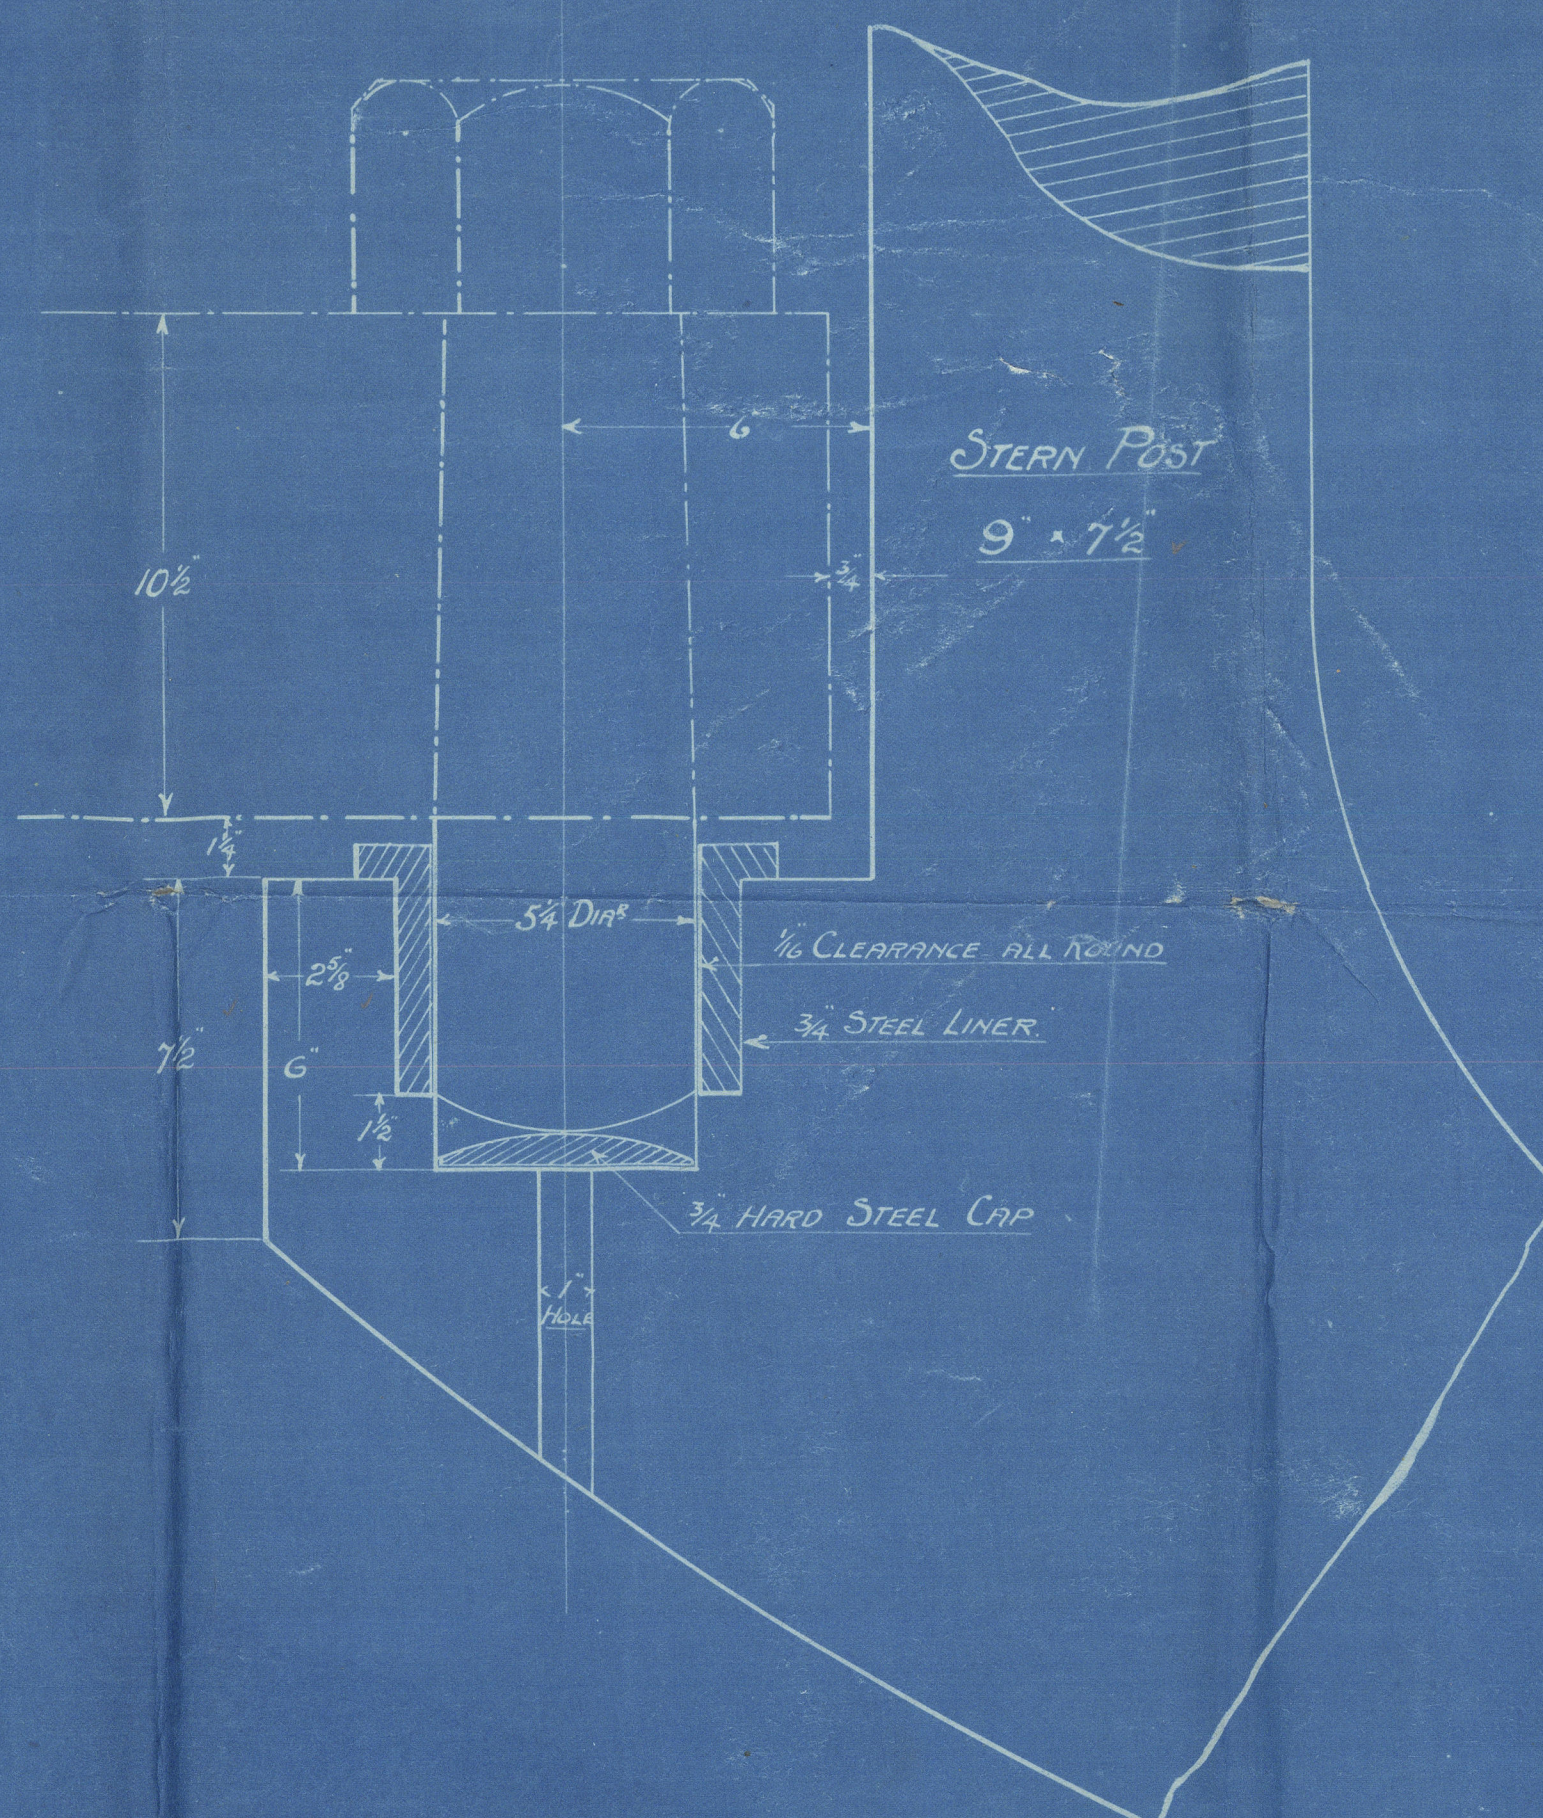

Detail of Bottom Gudgeon

174
The Greenock Dry Dock
376 ft Steamer
Plan of Stern Frame
Fig: 399.

S. S. "Mont agee"
Gr. R. Rept No 17670



© 2021

Lloyd's Register
Foundation

008049 - 008060 - 0144