


PROPOSED DECK PLANS
OF A

STEEL SCREW STEAMER TO CLASS 100A1 AT LLOYDS

SCALE $\frac{1}{8}'' = 1 \text{ FOOT}$

PRINCIPAL DIMENSIONS 232'-0" x 34'-10" x 18'-10"

BRIDGE DECK

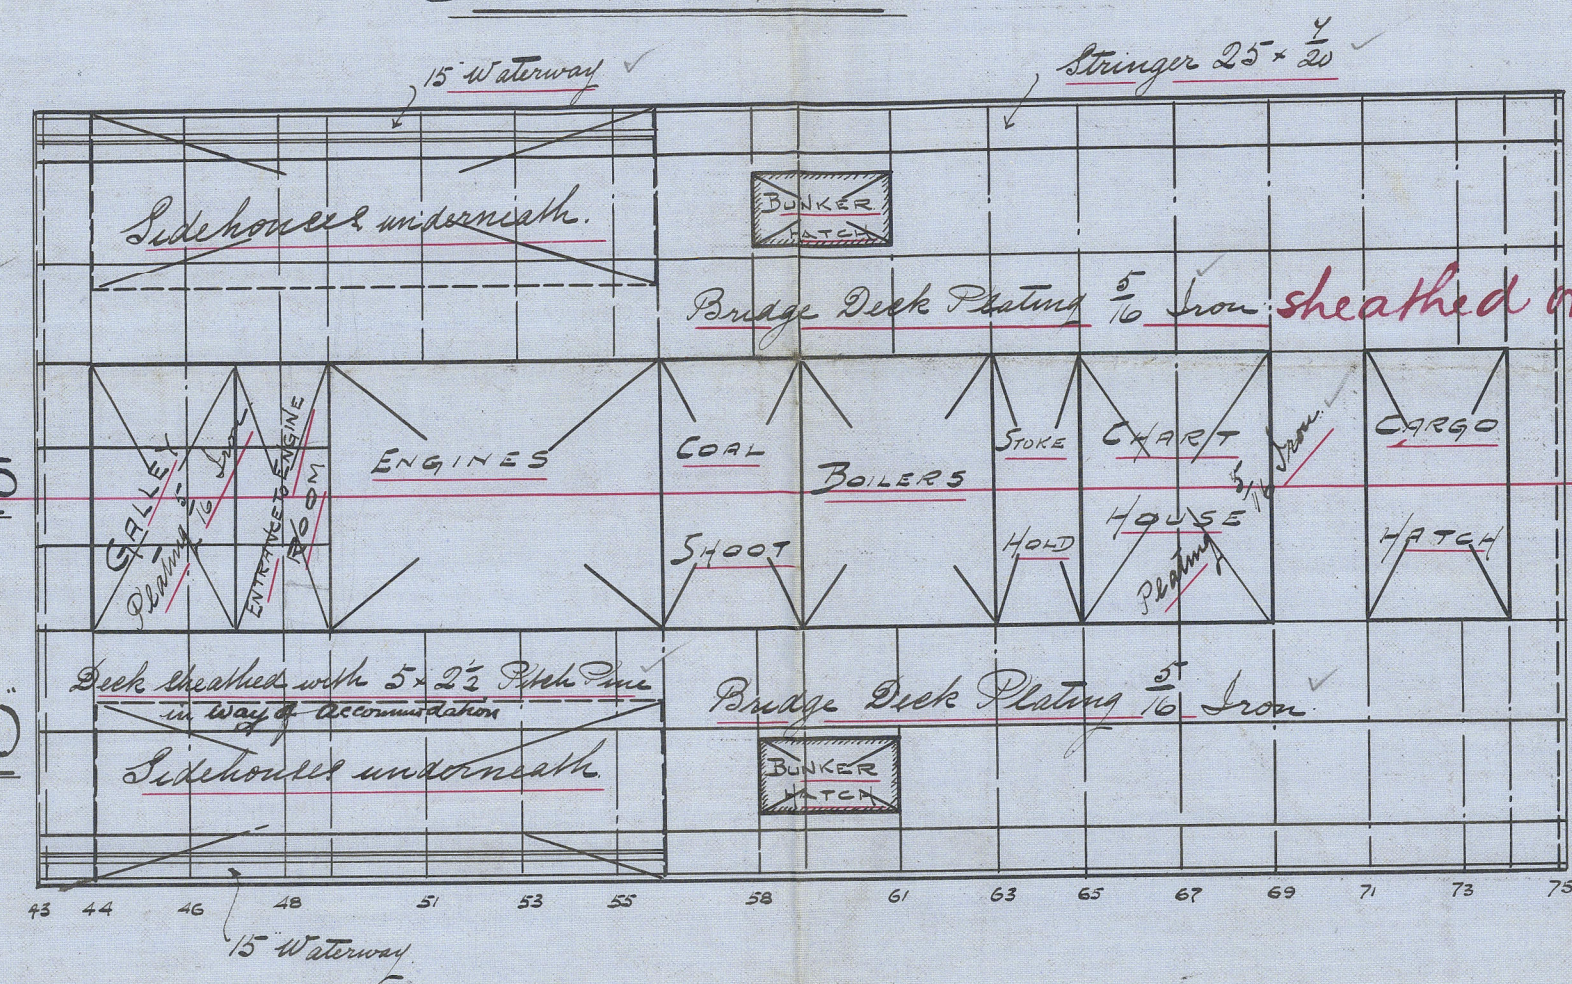


sheathed or beams to every frame


WOOD SKINNER & CO^{LD}
♦ SHIPBUILDERS ♦
NEWCASTLE ON TYNE

Drawn
Cargo
Hatch

FORECASTLE DECK

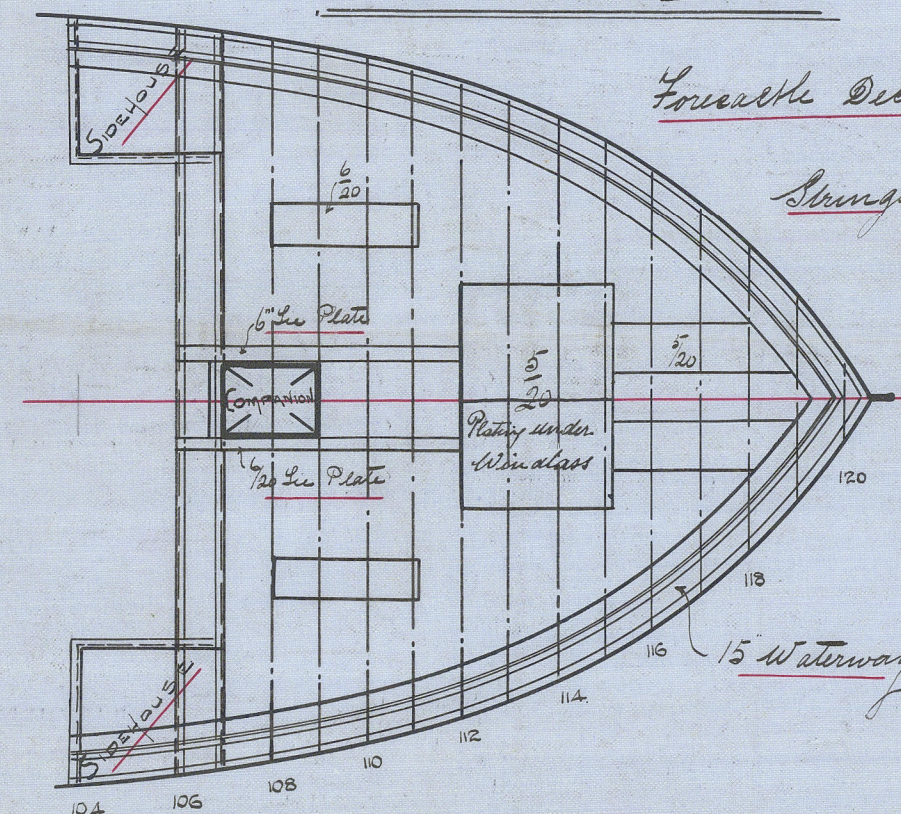

UPPER DECK

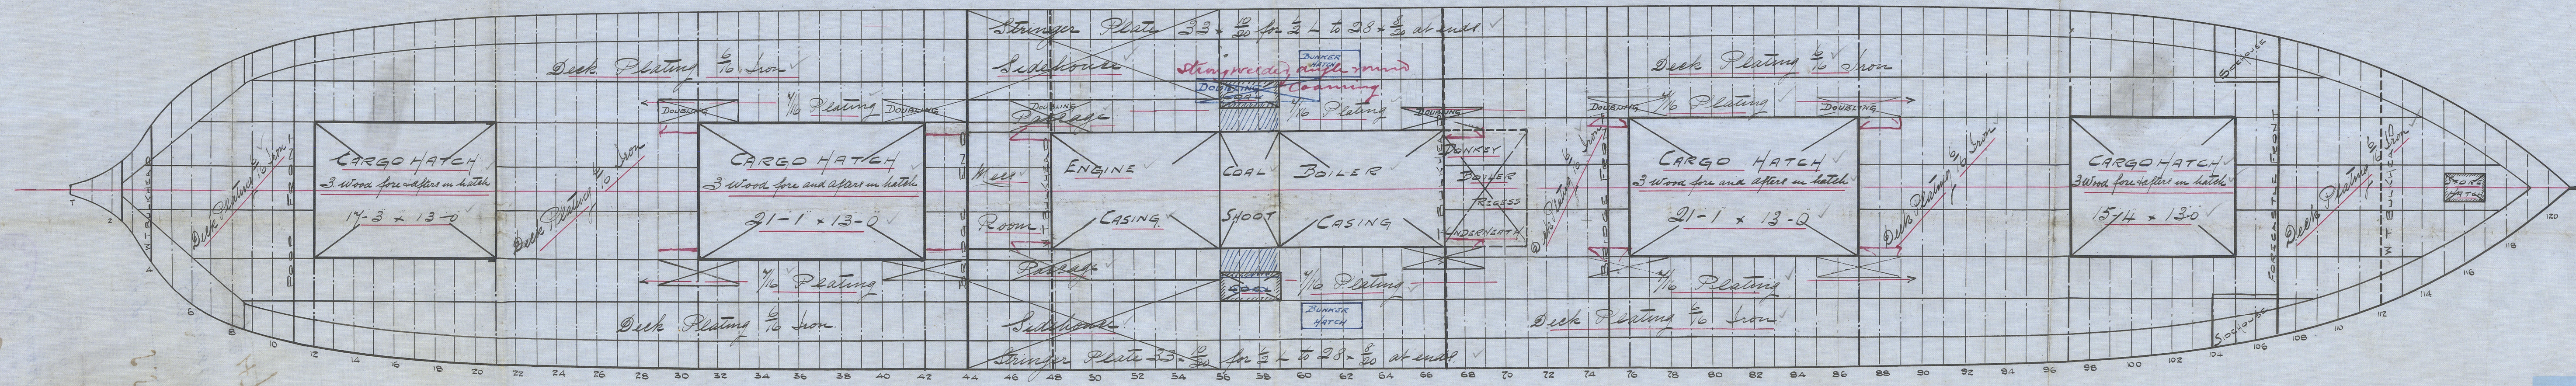

Also no. 119
(appd. 24/12/03)

N^o 118 SHIP

Newcastle-on-Tyne
Messrs. Wood, Skinner's

No. 118

Deck Plans

Also No. 119

S.S. Simone

Newcastle Report

N^o 47.036!

S.S. Jeanne

Newcastle Report

N^o 47.243!

© 2020

Lloyd's Register
Foundation

008061-008067-0131