

16.11.06

"Spray" 2.2
16.11.06
P.M.

16.11.06

LONGITUDINAL SECTION DECK AND SPAR PLAN



SCREW STEAMER N° 179

SCALE 1/8" = ONE FOOT

MASTS OF STEEL DOUBLED FROM HEEL TO PARTNERS AS SHOWN BUT LAPS

TREBLE RIVETED FROM DECK TO HOUNDS, REMAINDER DOUBLE RIVETED.

LANDINGS 2 1/2" SINGLE 8 RIVETS 3 1/2" CENTRES.

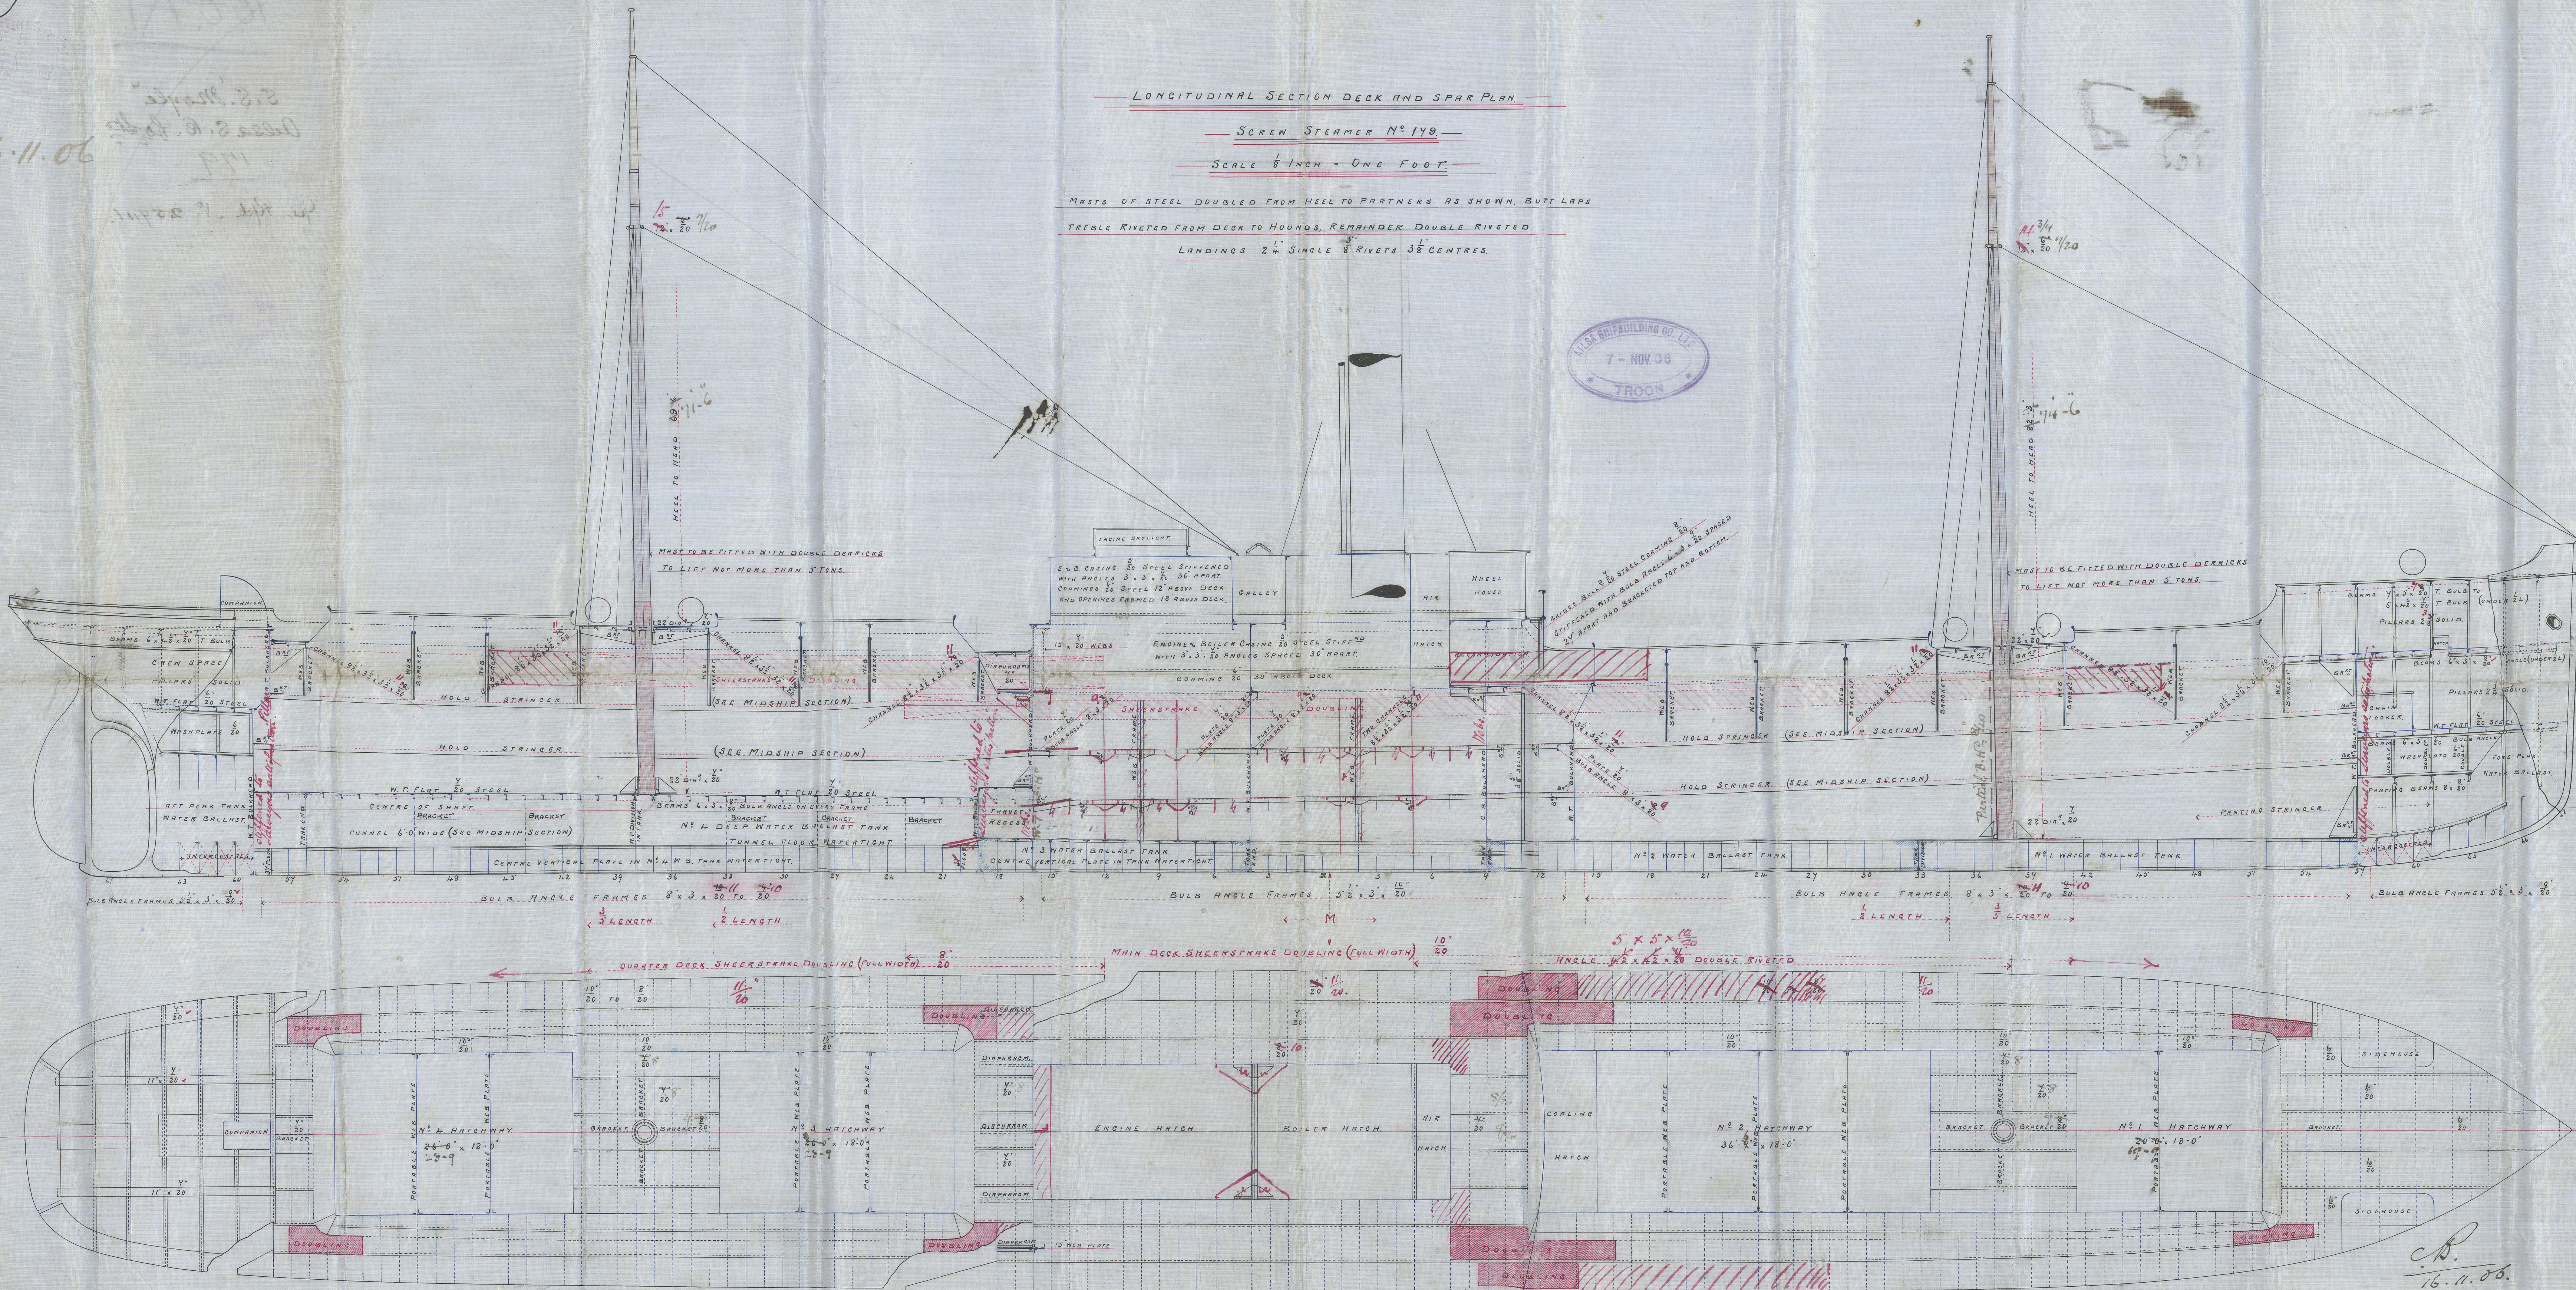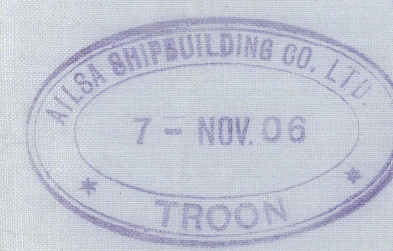

16.11.06

100. A1

S.S. "Moyle"
Aulsa S. B. Lock
179

Gls. Rpt. N^o. 25941.

© 2020

Lloyd's Register
Foundation

8068-008078-0057