

MIDSHIP SECTION.

S. S. N^o 179.

DIMENSIONS: 275'-0" B.P. x 36'-0" B.M. x 19'-0" D.M.L.D.

SCALE 1/2" INCH = 1 FOOT

TO CLASS 100 A.I. STEEL RAIL QUARD^o, POOP BRIDGE TOP F.C.E.

PROPORTIONS

DEPTHS TO LENGTH 13.84"
BREADTHS TO LENGTH 1.59"




EQUIPMENT (9)

- 2 BOWER ANCHORS 33 CWT EACH STOCKLESS } COLL^o WEIGHT 94 CWT.
- 1 STREAM 28" EX STOCK.
- 1 KEDGE 42" EX STOCK.
- 240 FATHOMS 17/6 STUD CHAIN CABLE MIN WEIGHT 344-2-22
- 45 17/6 STREAM CHAIN OR 4" STEEL WIRE
- 90 11" HEMP TOWLINE OR 3/2"
- 2 @ 90 6" HAWSER
- 2 @ 90 5" WARP

FORECASTLE DECK BEAMS 7.5 x 20 T. BULB ON ALTERNATE FRAMES.
STRINGER 26 x 20 TO 20 x 20 ANGLE 3 x 3 x 20
TIES: PLATING IN CENTRE DECK 3" PINE.

ERECTIORS
QUARTER DECK 34'-0" x 4'-5" x 2' 456.0
BRIDGE 54'-0" x 4'-5" x 12' 604.0
FORECASTLE 32'-0" x 4'-5" x 12' 360.0
POOP 20'-0" x 5'-3" x 12' 142.0
TOTAL ERECTIORS = 1896.0

NUMERALS
DEPTH 19.45'
BREADTH 18.00'
CIRTH 32.20'
1st N^o 41.95' x 273.5' 19678.5 - 2nd N^o
+ FOR ERECTIORS 1896.0
21574.5 = EQUIP^o N^o

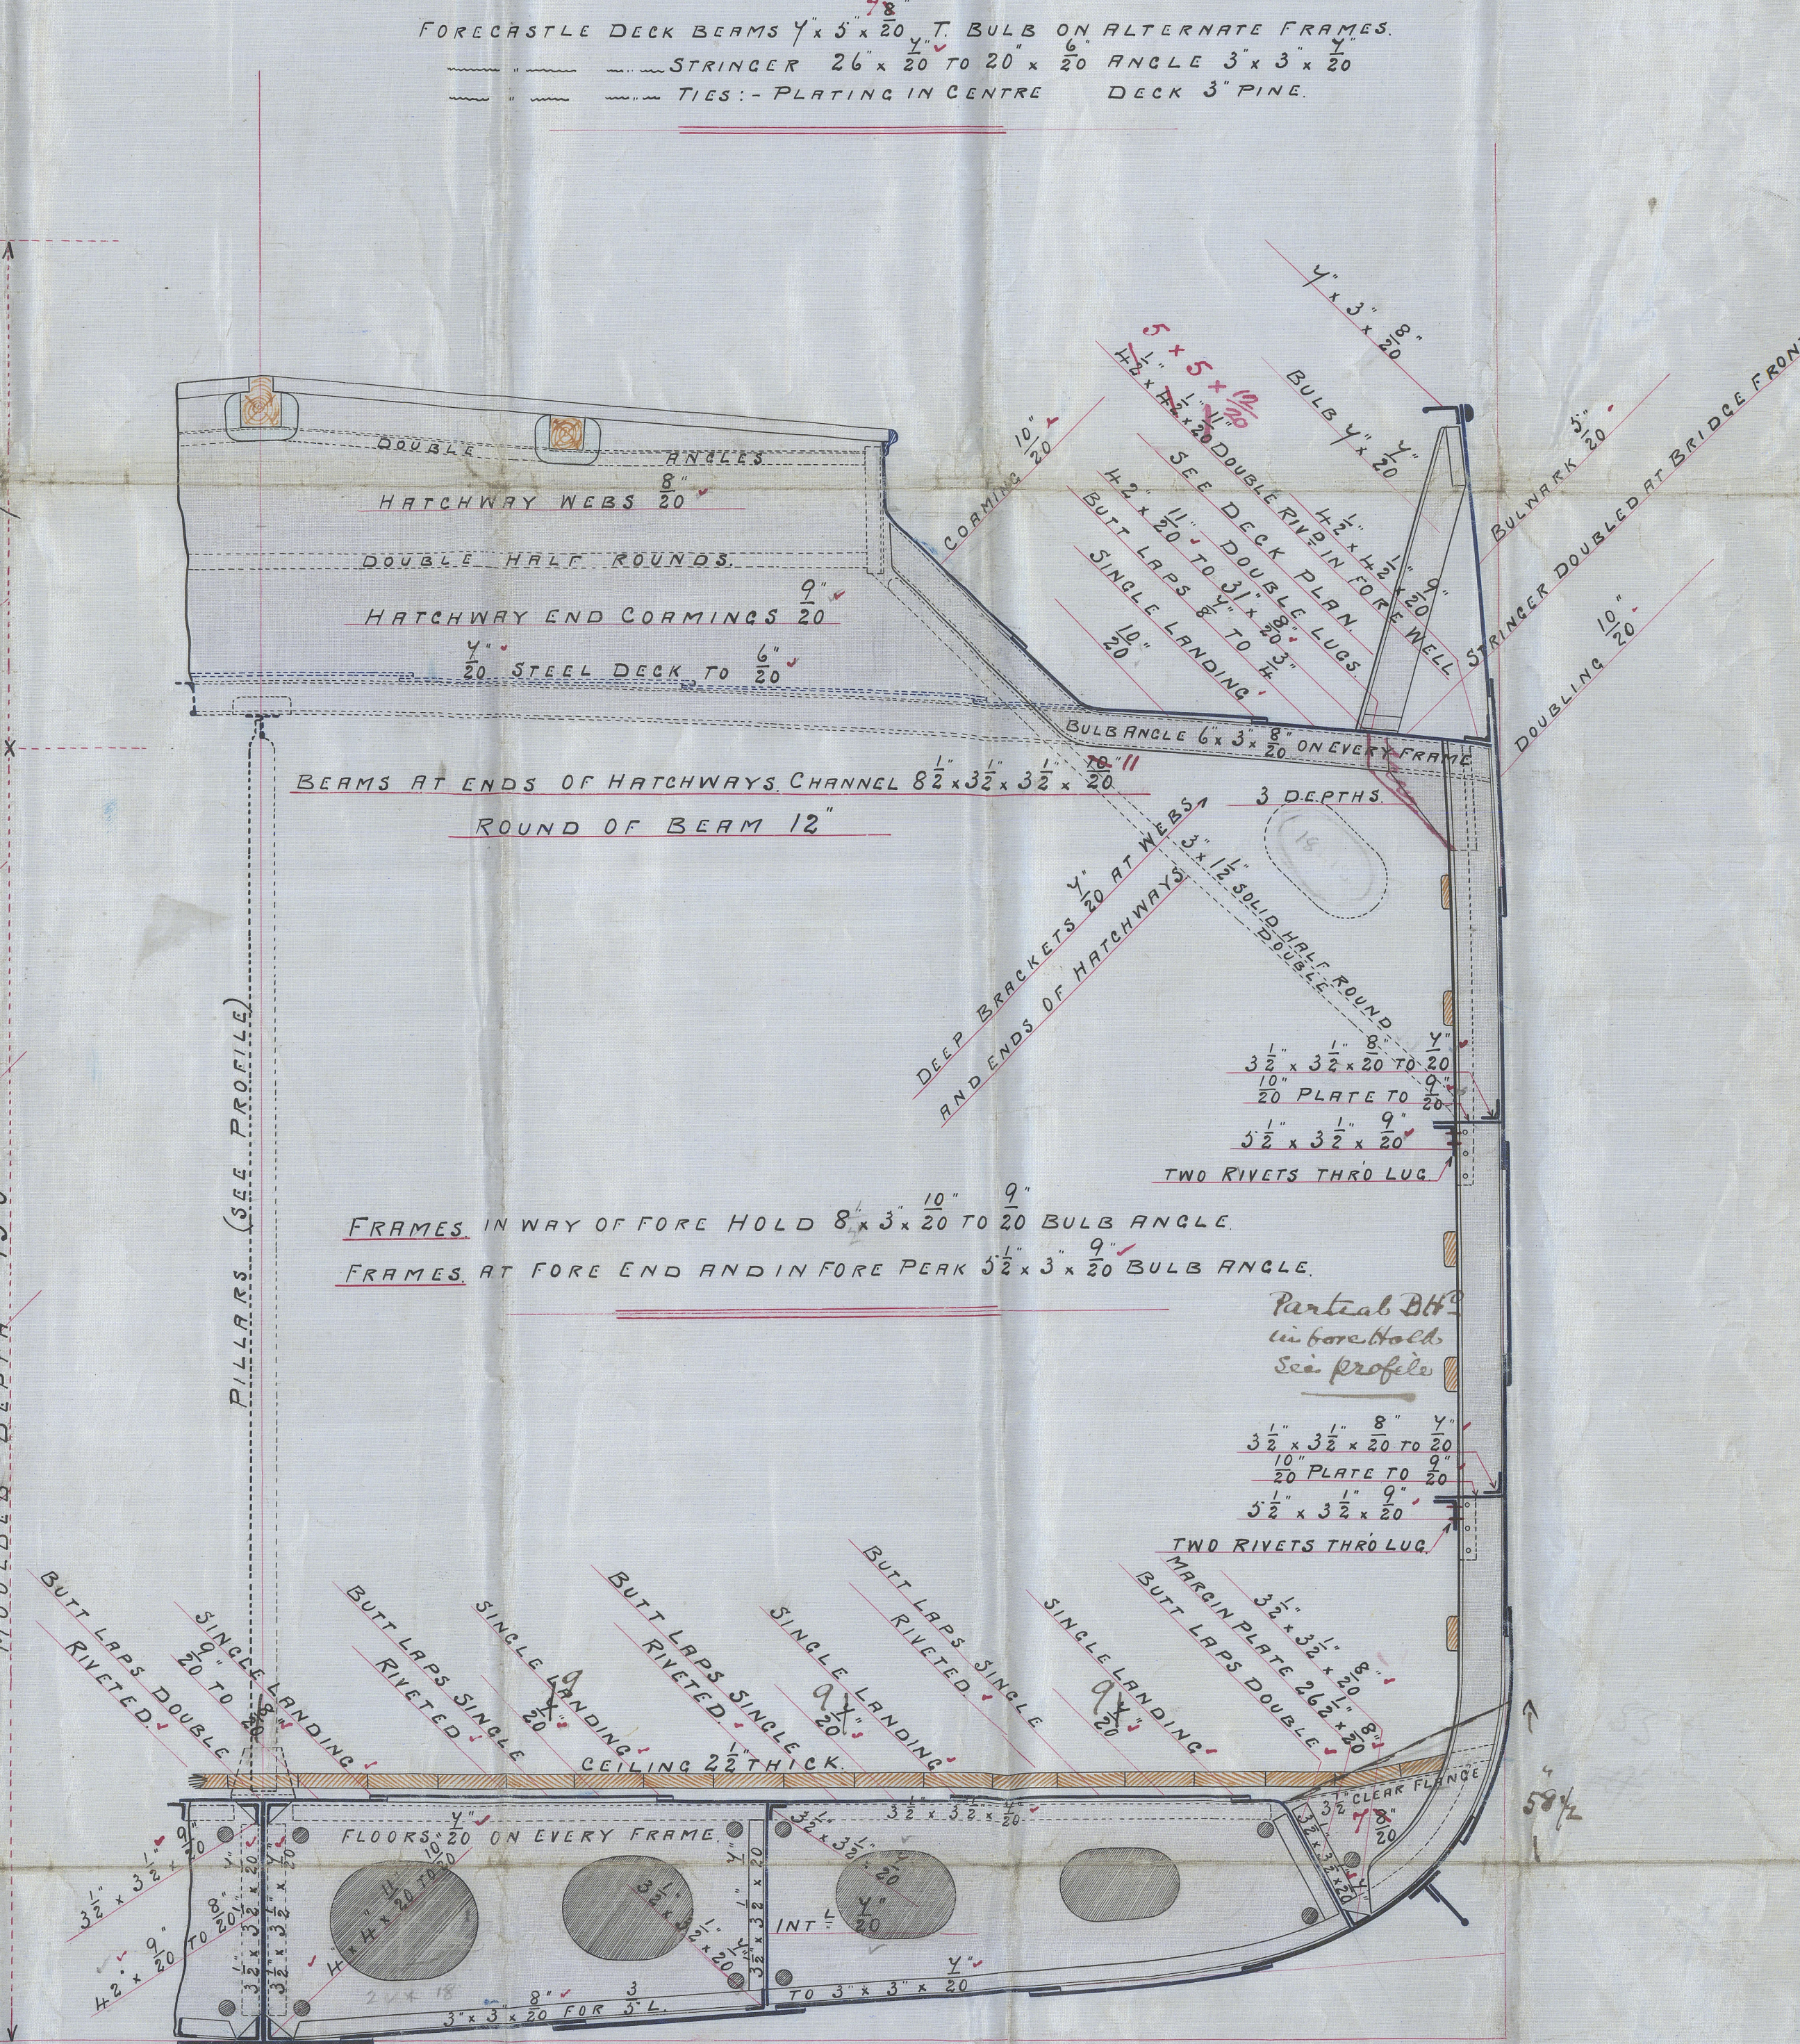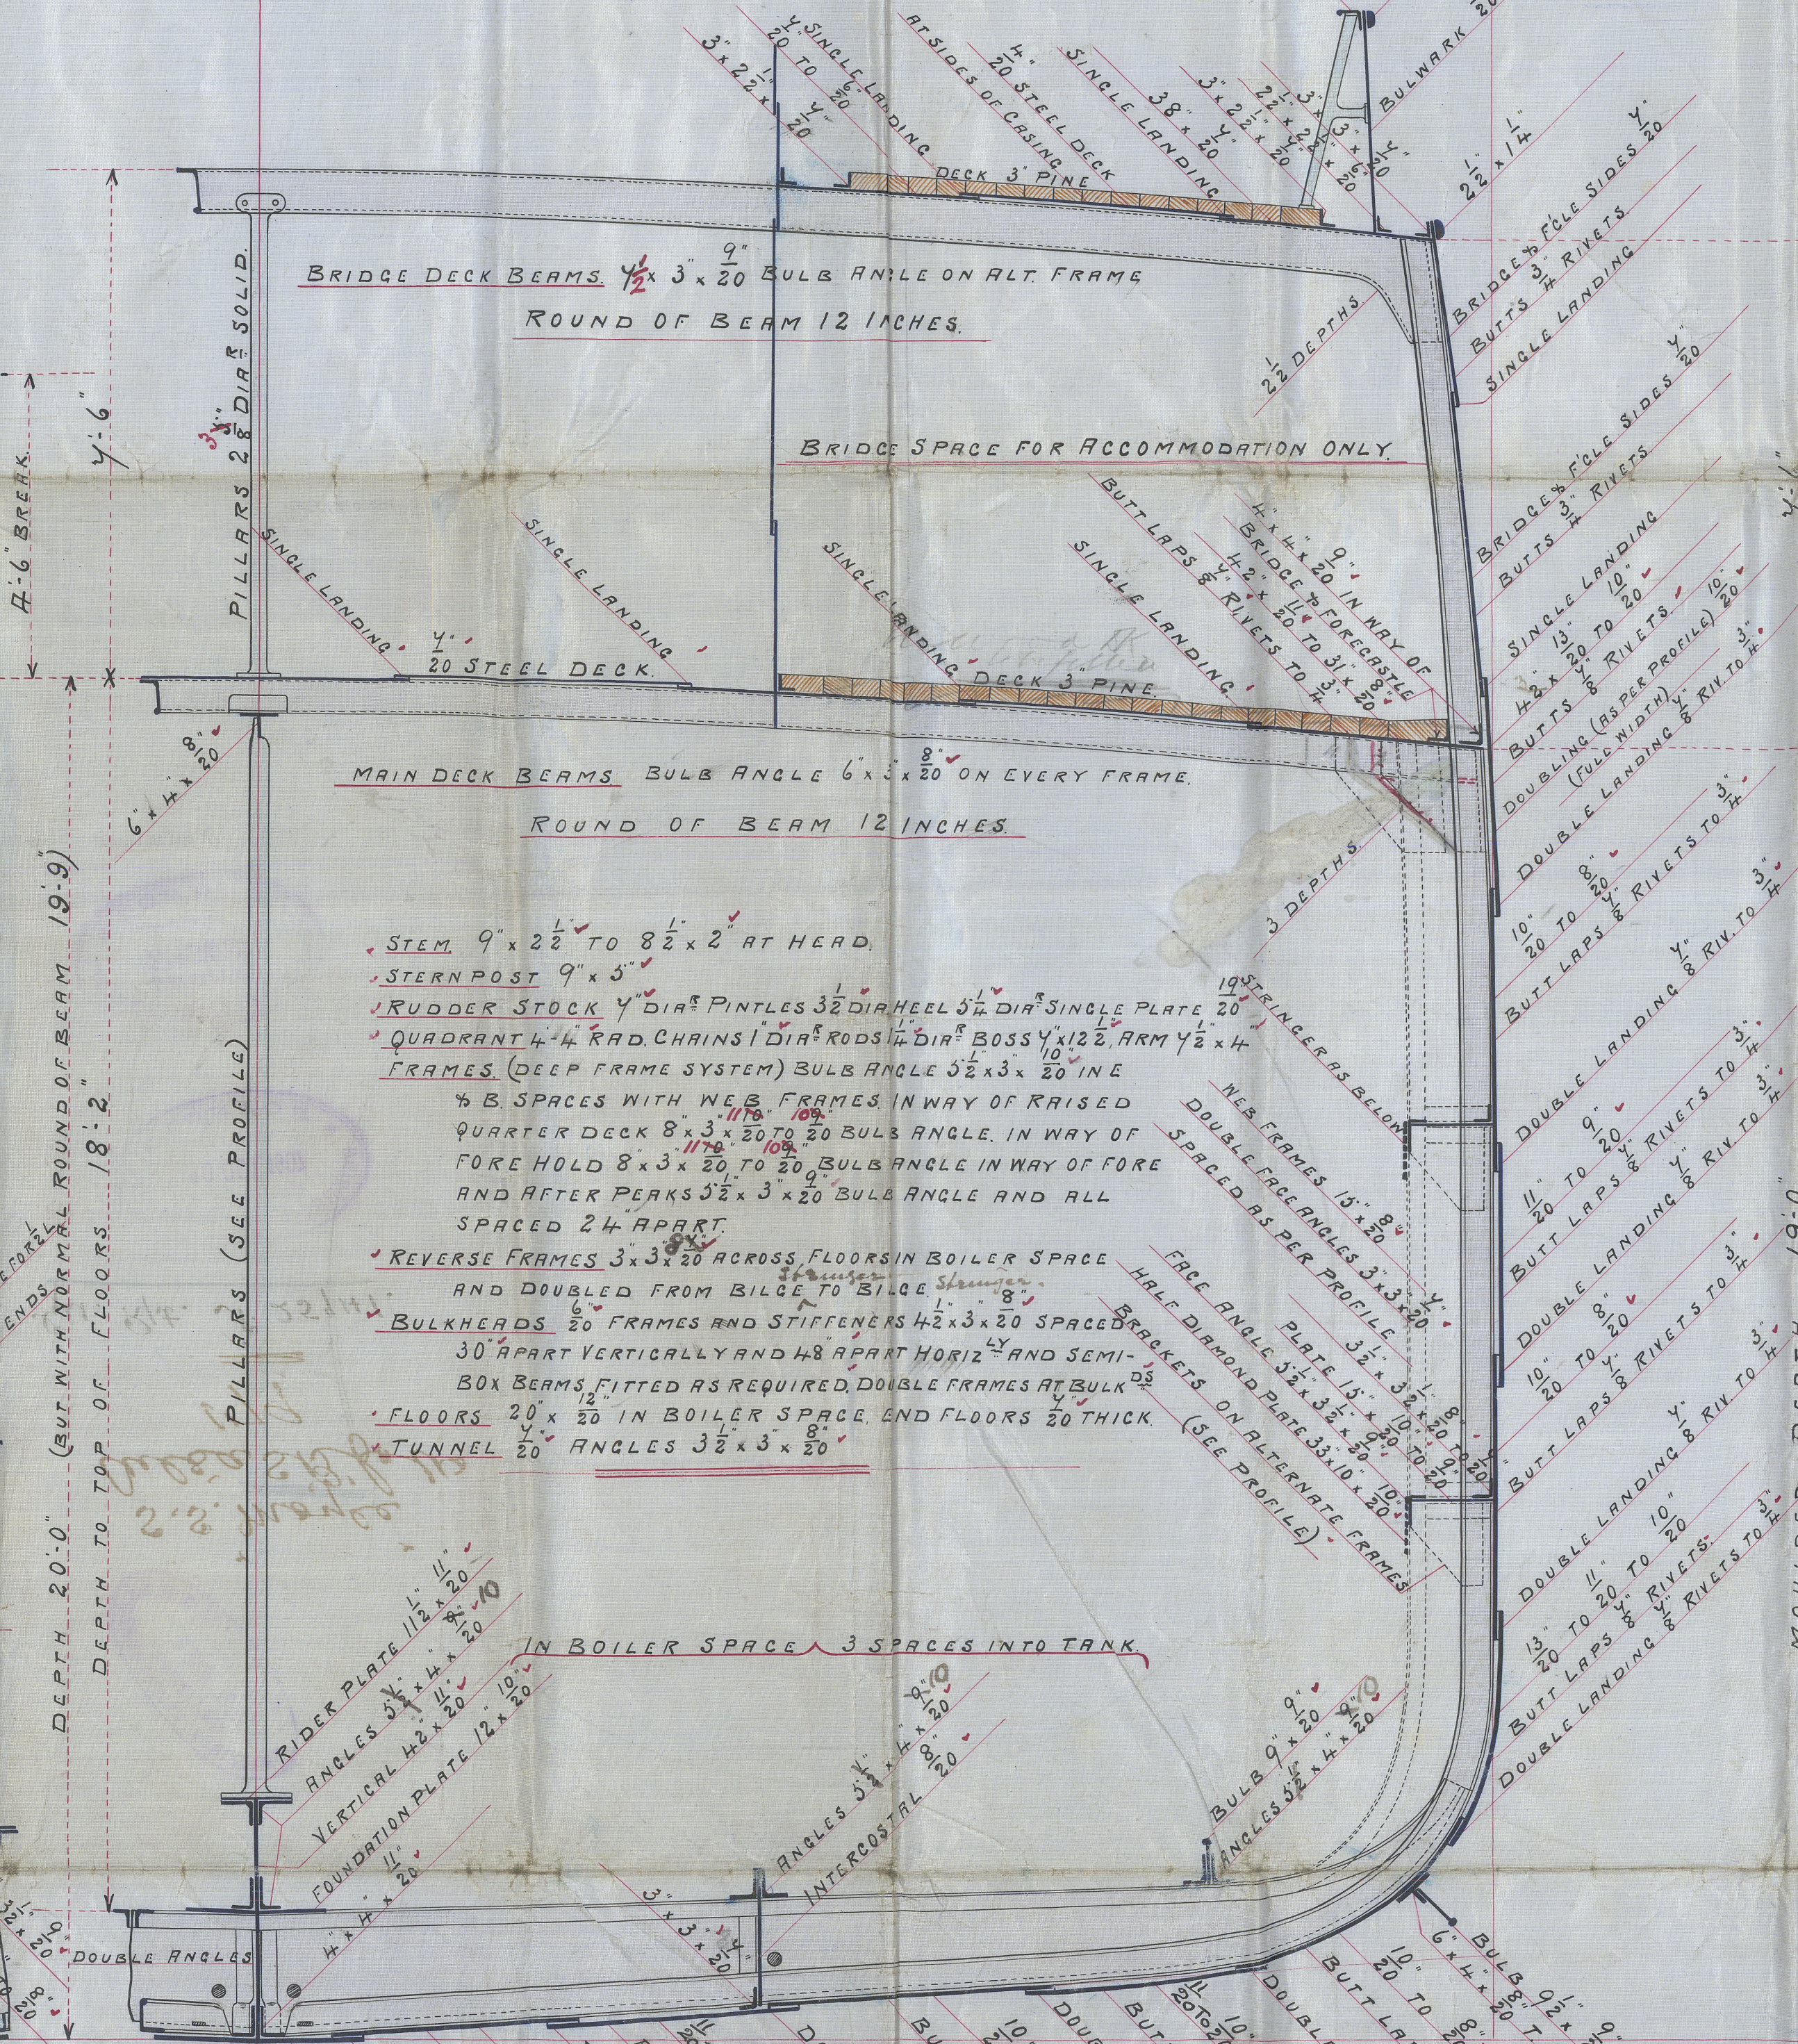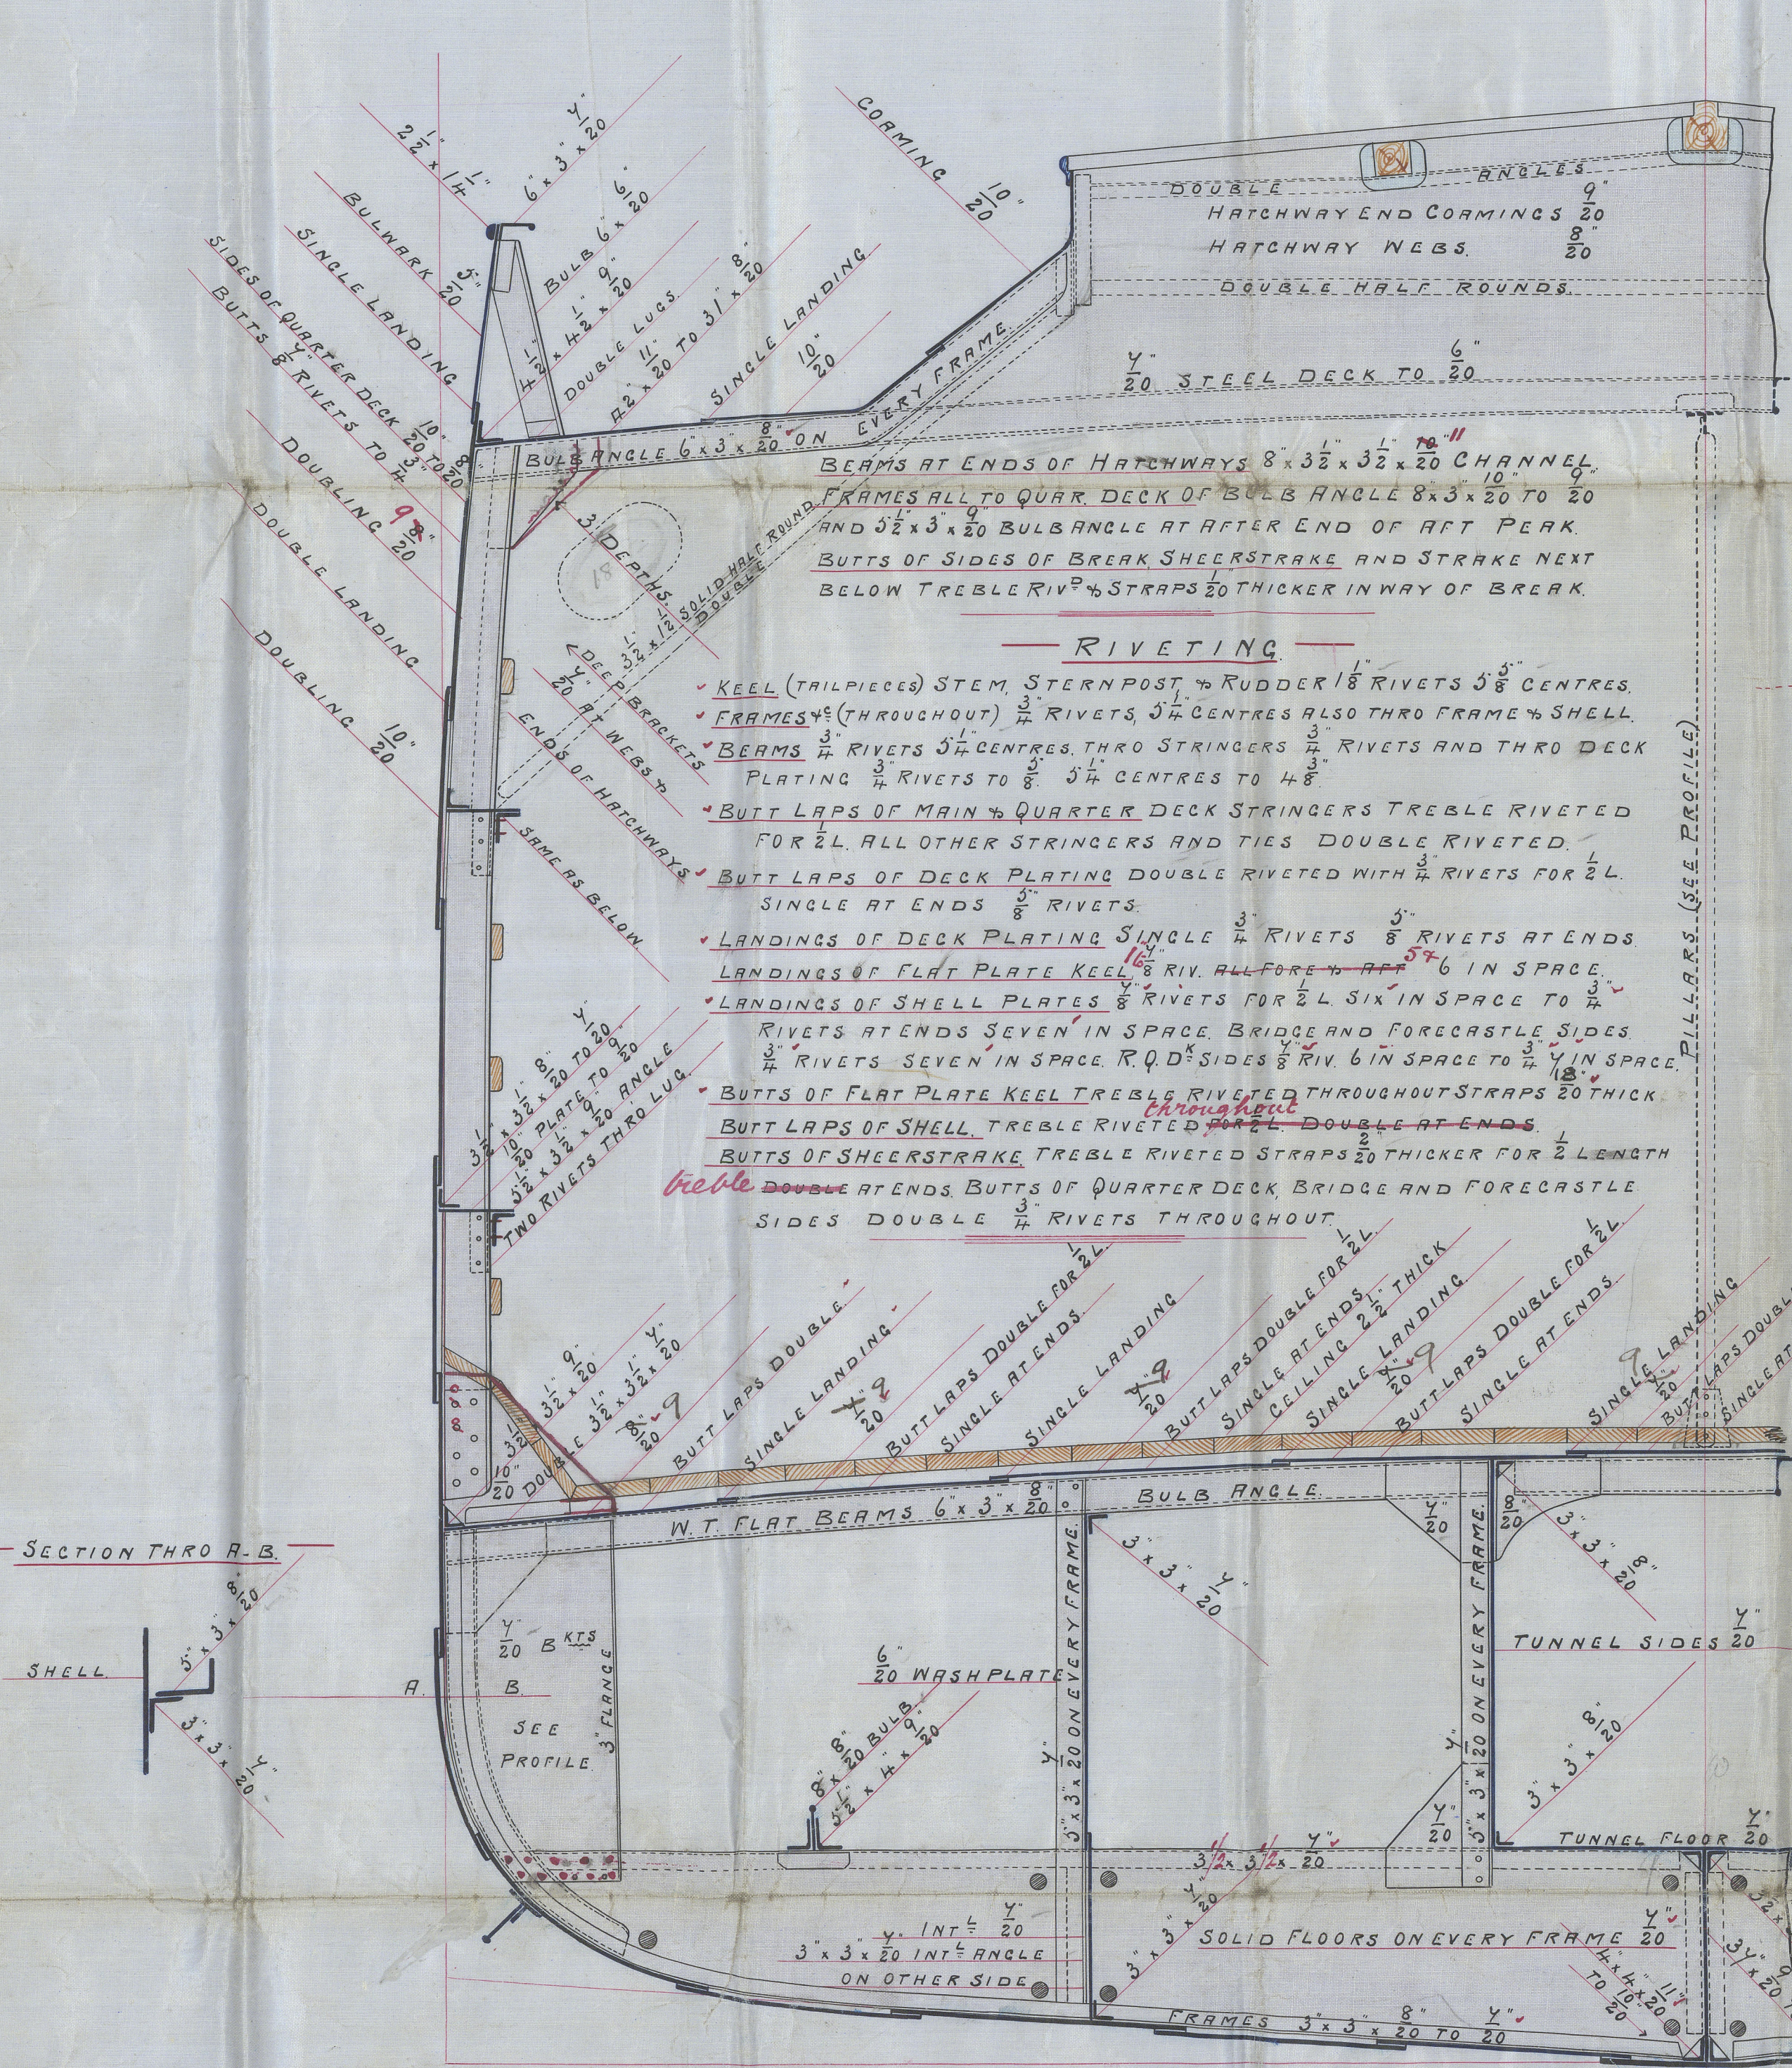

NOTE: RIVETS THROUGH FRAMES AND SHELL IN FORE AND AFT PEAK TANKS 6 DIA APART CENTRE TO CENTRE.

SECTION IN WAY OF QUARTER DECK.

SECTION IN WAY OF BOILER SPACE.

SECTION IN WAY OF ENGINE SPACE.

SECTION IN WAY OF MAIN DECK.

S.S. Moyle
Alisa S R folio
179

Gen. Rpt. N° 25941.

R

© 2020

Lloyd's Register
Foundation

002068-005079-0058