

INTERCOSTALS IN WAY OF STRUT
TO SURVEYORS SATISFACTION.

5" x 5" x $\frac{3}{4}$ " ANGLES
1" DIA RIVETS 1 $\frac{1}{16}$ " GAGES

18 RIVETS

$\frac{3}{4}$ " BEVEL ON EDGE
OF STRAP PLATE
 $\frac{1}{8}$ " RIVETS

IVETS

RIVETS

1" DIA RIVETS, 1 1/16" HOLES

PLATE BRACKETS
FOR STERN TUBES
JOB NO 429

SCALE 1" = 1 FOOT.



1- OFF AS DRAWN FOR STAR^D
1- OFF To OPPOS HP " PORT.

~~N. 13~~
~~13/10/14~~

Henning & Ferguson
No. 429.
Propeller Brackets

- T.S.S. "KAIONE." -

GLASGOW REPORT No. 38380

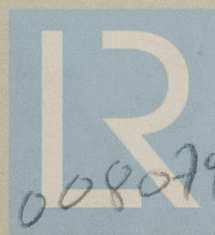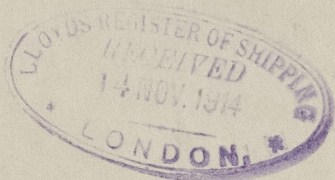

© 2020

Lloyd's Register
Foundation

008079-008086-0040