





FLEMING & FERGUSON. L<sup>rs</sup>

MIDSHIP SECTION.


T.S.S. "KAIONE"

No. 429.

Vessel as built.

hull.

GLASGOW REPORT No. 38380

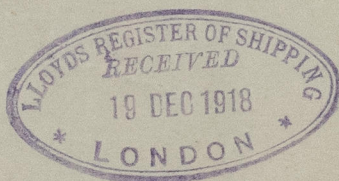

© 2020

Lloyd's Register

008079-008086-0041  
Foundation