

T. S. FERRY

165' X 28' X 11'-3"

GENERAL ARRANGEMENT PROFILE

SCALE 1/8" = ONE FOOT




For guidance

Dimensions finally arranged. 165' x 30' x 12'

Load draft 8' 6" max

Bulkheads & deck openings as shown.

Montrose 3 Aug 1922

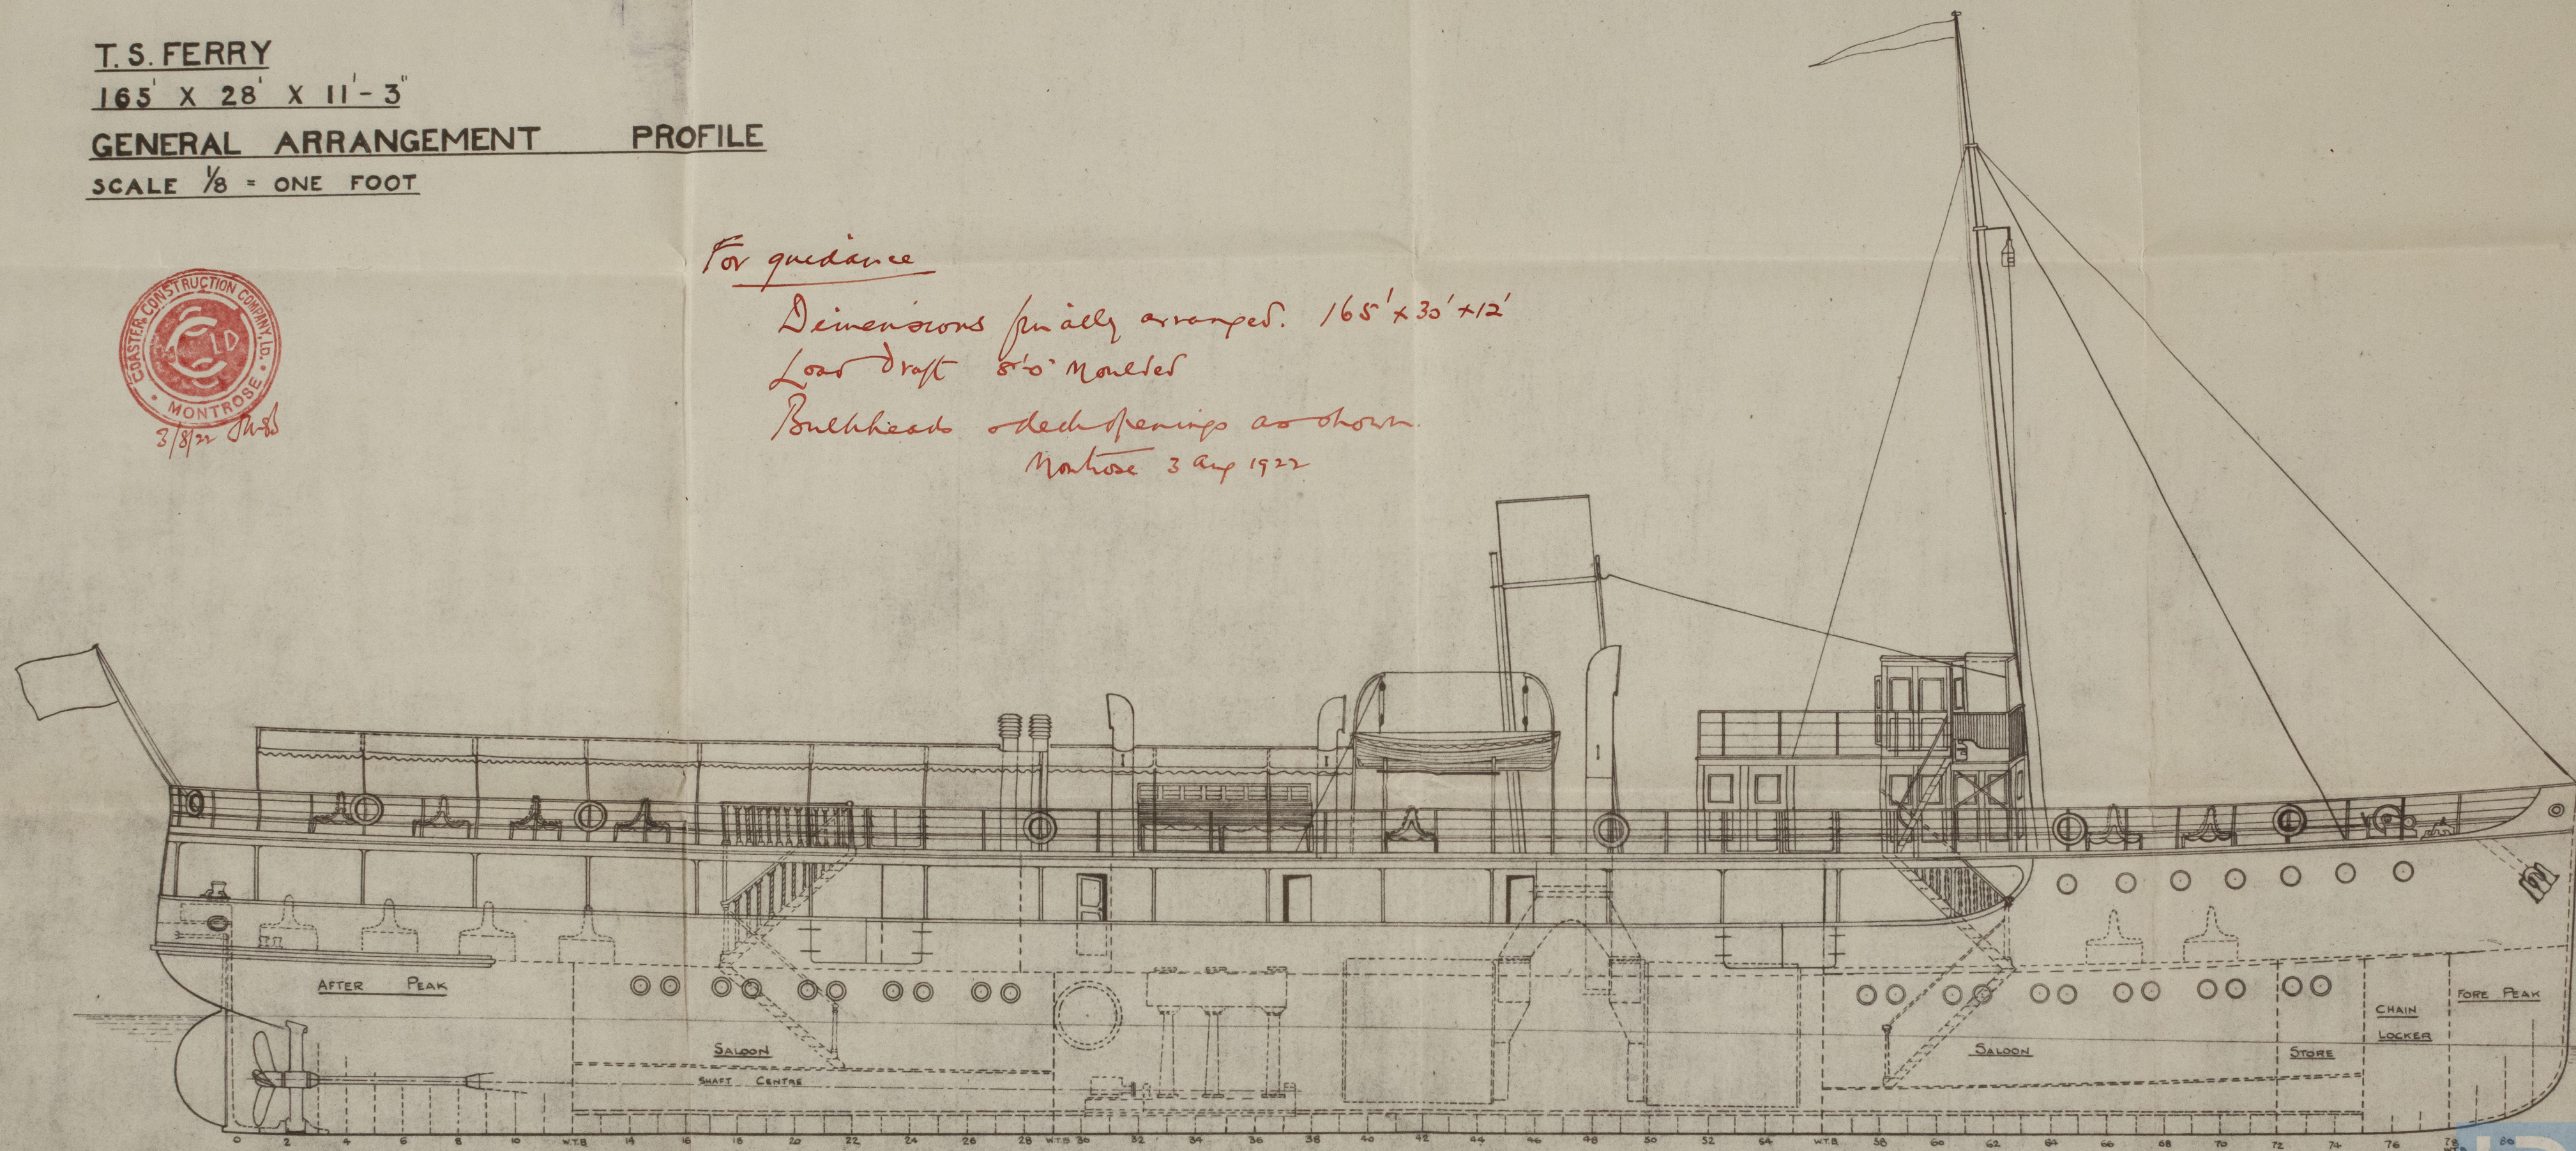

*car
k 8 m*



© 2021

Lloyd's Register
Foundation

008087-008095-0003

Messrs. Hoaster Construction Co. Ltd.

C/A Profile - No. 114.

V. S. Ferry for Eastbourne

Council of New Zealand.

~~Gen. Box 3762~~

"Muritai"

Verified copy



© 2021

Lloyd's Register
Foundation

008087-008095-0003