

T.S. FERRY N° 117

165' X 28' X 11'-3"

GENERAL ARRANGEMENT

DECKS

SCALE 1/8" = 1 FOOT

Plans sent
11/8/22




For guidance

*Dimensions of hull correct
165' x 28' x 11'-3"*

*Deckhouse Deck Opening as
shown*

Montrose 31 Aug 117

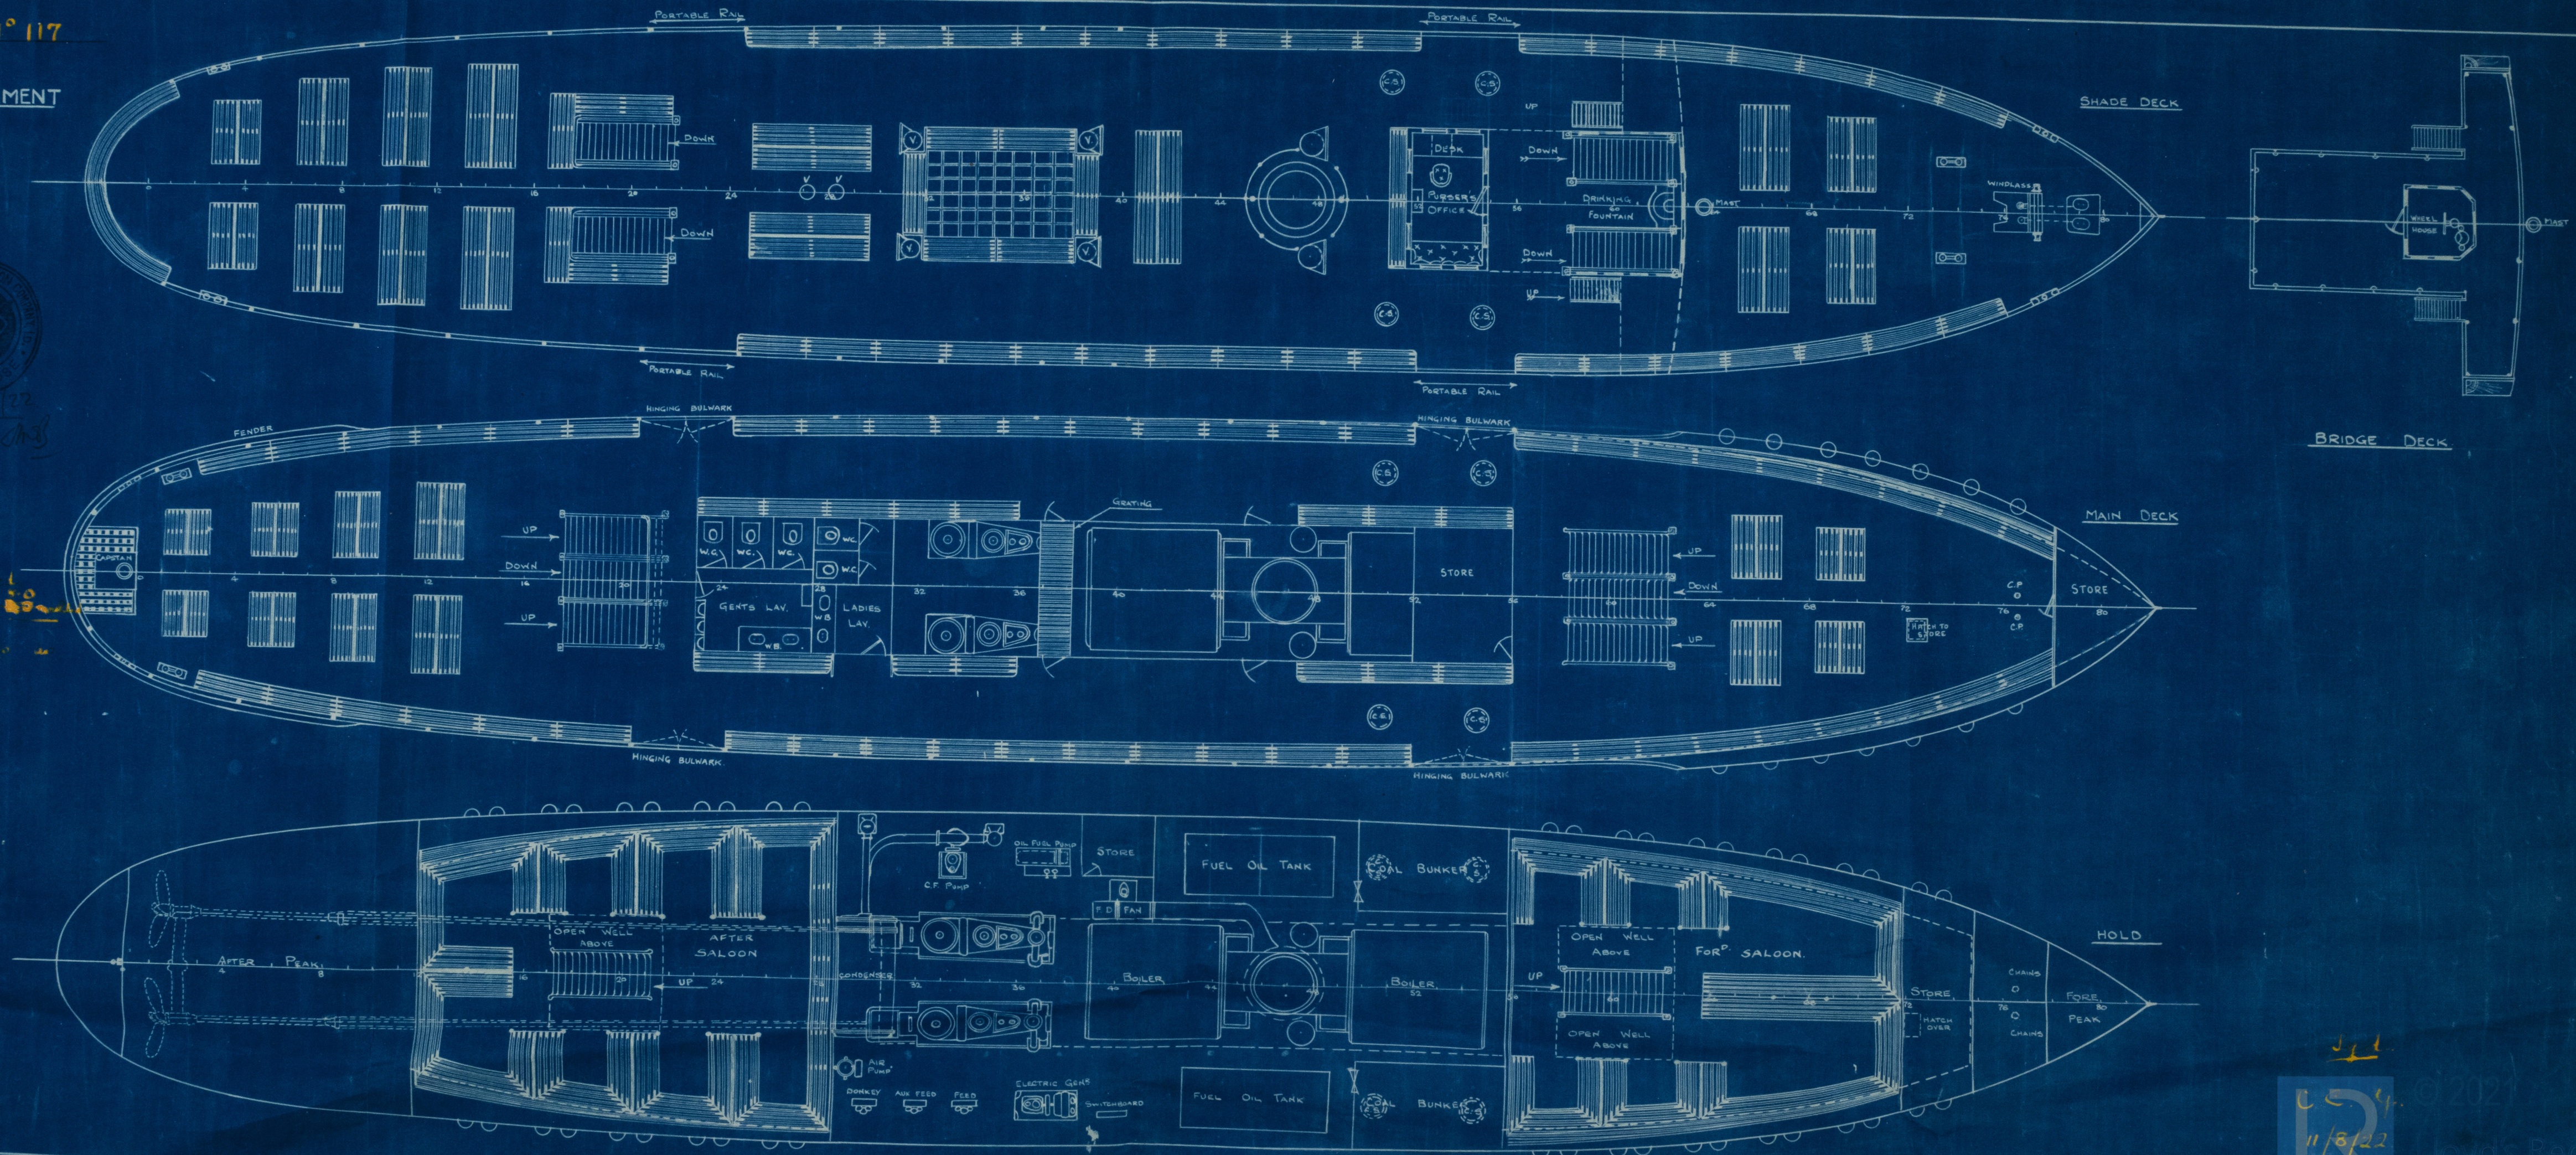

11/8/22

Copy of Plan as approved by Lloyd's registered 11/8/22

Coastal Construction Co Ltd
No 117.

General Arrangement of
becks.

T. S. S. "MURITAI"

DUNDEE RPT. No 8420.

No 5



© 2021

Lloyd's Register
Foundation