


3/8/22

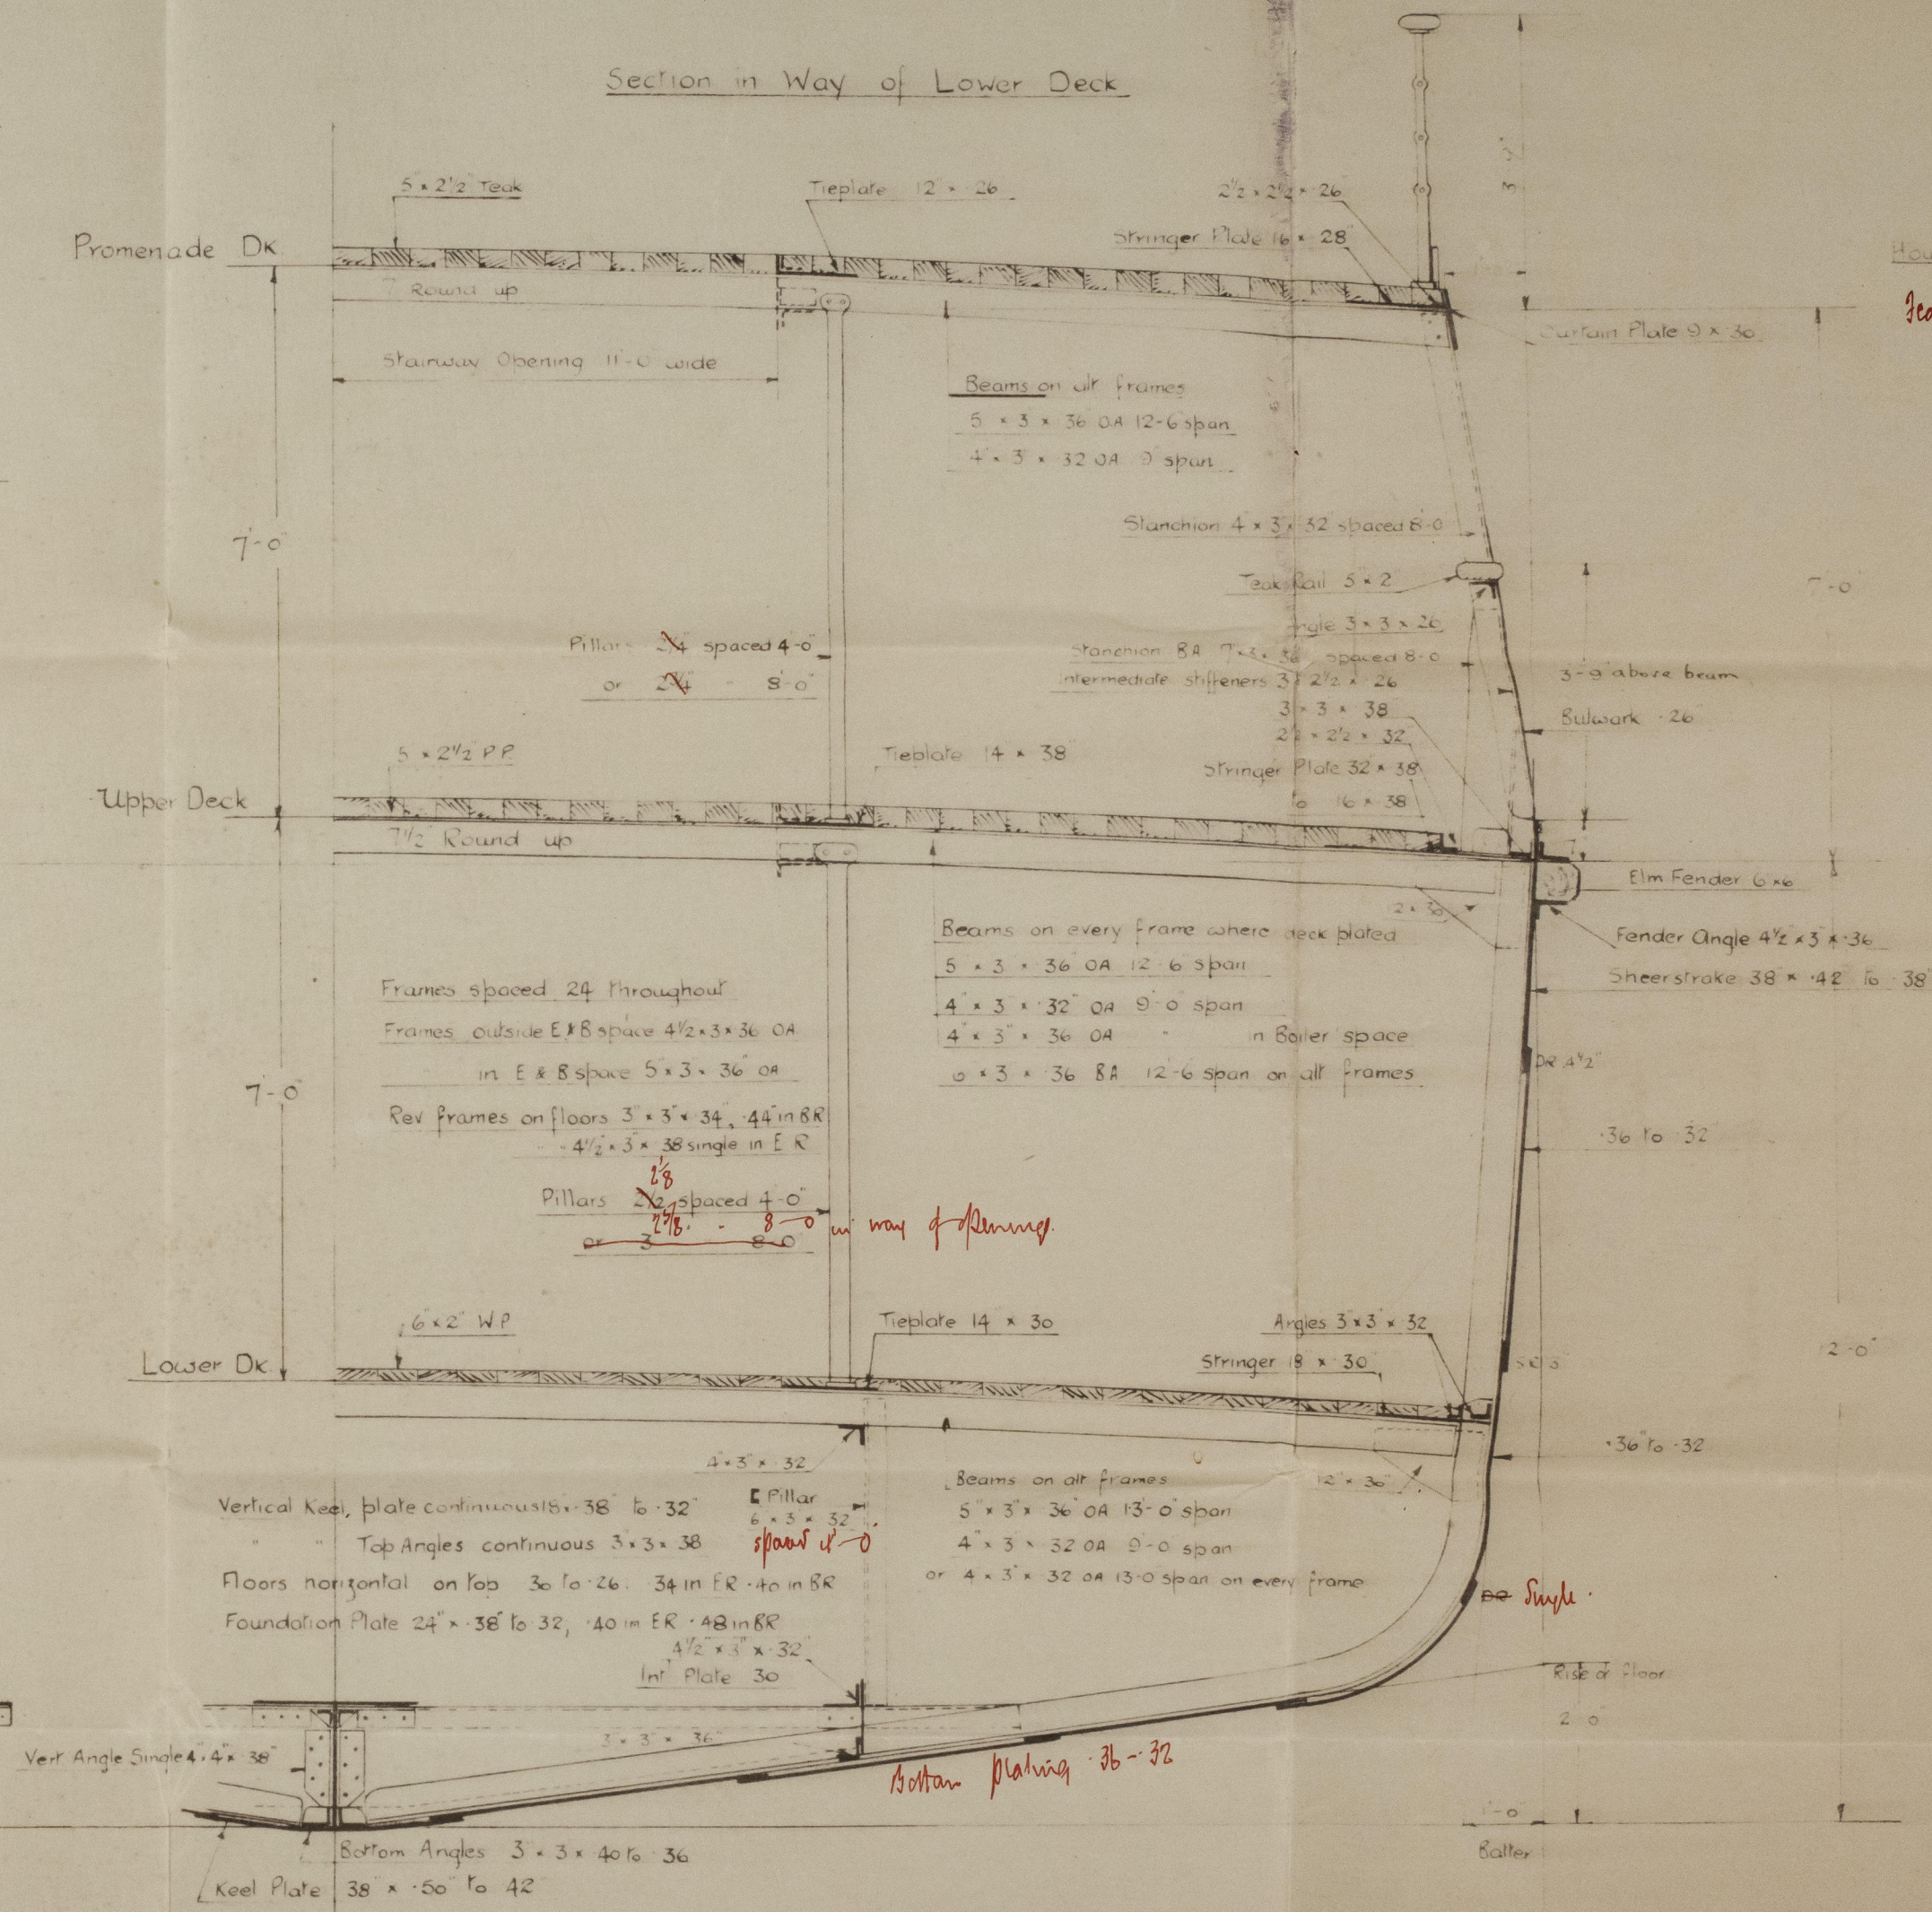

<u>Cable</u>		
195	20 fathoms	1 3/16" Stud-chain
60	"	2 3/4" Steel wire
75	"	3" Hemp Towline
90	"	6" Hawser

CCG
118. v.

Coaster Construction Bldg.

Midship Section.

10114.

V. S. Ferry for Eastbourne Council

of New Zealand.

Gen. No. 3762

"Muritai"

Unfired steel

008087-008095-0006



© 2021

Lloyd's Register
Foundation