

12.3.06.

MIDSHIP SECTION

STEEL SCREW TRAWLER

S.S. NO 365

DIM 125'0" x 22'0" x 12'9" DEPTH M^{LD}
SCALE 1/2" = 1 FOOT

TO CLASS 100 A.I. AT LLOYDS FOR FISHING PURPOSES
ENGINE & BOILER CASING AS PREVIOUSLY APPROVED
DECK PLATED IN WAY OF E & B CASING

LLOYDS NUMBERS


| | |
|-------------|---|
| 1/2 BREADTH | 10.95 |
| 1/2 GIRTH | 20.0 |
| DEPTH | 13.20 |
| | 44.15 1 ST N ^O |
| | 123.75 RULE LENGTH |
| | 54655625 2 ND N ^O |

PROPORTIONS

| | |
|------------------|-----|
| DEPTHS to LENGTH | 3.3 |
| BREADTHS | 5.6 |

EQUIPMENT

| | |
|--|------------------------------|
| 1 ST POWER 5 1/2 CWTs EX STOCK | 1 Steel Anchor Yards fitted. |
| 2 ND " 5 " " " " | " " " " " " |
| 3 RD " 2 3/4 " " " " | " " " " " " |
| 105 FATH ³ 1 1/8 DIA SHORT LINK CABLE | |
| 60 " 6 " HAWSER | |
| 60 " 4 1/2 " WARP | |

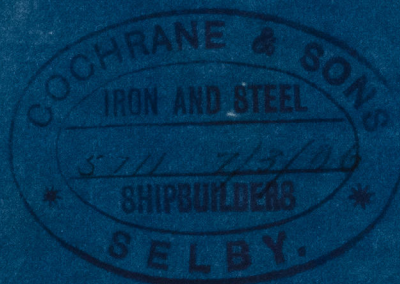


C.B.
12.3.06.



Cochrane & Sons
N^o. 365.

Midship Section

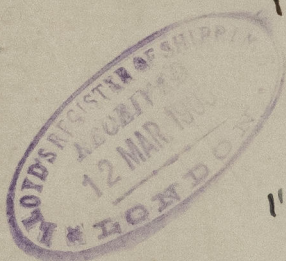


"FOSSUR"

ex

2/5 "Vesper"

Hull Report No.

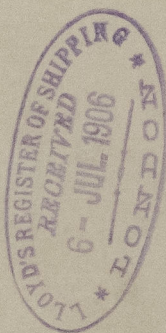

© 2021

Lloyd's Register
Foundation

008087-008095-0129