

PRAKOON

8 DEC. 1925

Approved
See also 7 10 15

MIDSHIP SECTION

T. S. S. No 791


SCALE 1/2" = 1 FOOT.

DIMENSIONS:
LENGTH 190' 0" B.P. x 34' 0" MLD x 12' 0" MLD TO UPPER DECK.
TO MEET REQUIREMENTS OF CLASS B.S.*

Dranght 10' 6" Child.

EQUIPMENT		
2 BOWER ANCHORS	STOCKLESS	17 1/2 CWTs EACH
1 STREAM "	EX STOCK	15 1/2 "
1 KEDGE "	"	8 1/2 "
210 FATHOMS 1 1/4" STUD LINK CHAIN CABLE		
60 " 3/4" STEEL WIRE STREAM OR 1 1/4" STREAM CHAIN		
80 " 2 7/8" "		
90 " 6 1/2" MANILLA		
30 " 5 "		
HAWSER AND WARP		

RIVETING NOTE:
STEM: 7/8" RIVS SPACED 4" CR TO CR.
STERNPOST: 1" RIVS SPACED 4 1/2" CR TO CR (SEE PLAN).
FRAMES: THROUGH FRG. & SHELL 3/4" RIVS 5/4" APART CR TO CR.
IN AFT PEAK & 1 1/2" FORD 3/4" RIVS 5/4" CR TO CR.
REV. FRG. & FLOORS: 3/4" RIVS 5/4" CR TO CR. IN E.R. & FORD 4/8" CR TO CR.
BOILER ROOM: 3/4" RIVS 5/4" CR TO CR.
BEAMS: 5/8" RIVS 3/4" CR TO CR. ON ALTERNATE FRAMES.
5/8" 4 1/2" " " " " EVERY FRAME.
STRINGER PLATES: TO HAVE D.B. BUTT STRAP 8" 5/8" RIVS.
FORE & AFT LANDINGS OF OK PLATING SINGLE RIVETED.
BUTTS OF SHELL PLATING AT SIDE FROM TURN OF BILGE LAPPED & ER.
FORE & AFT SHELL BOTTOM BOTTOM BUTTS TO BE FLUSH & BUTT STRAPS FITTED, SHELL LANDINGS O.R.
BUTTS OF KEEL PLATES TO BE FLUSH & BUTT STRAPS FITTED.
CR GIRDER D.R. THROUGHOUT.
RIVETS THRO FLOOR REV BAR BACK LUGS & HORIZ PLATE TO BE SPACED NOT MORE THAN 4 DIAS. CR TO CR.
BUTTS OF HORIZ PLATES DOUBLE RIVETED FORE & AFT.

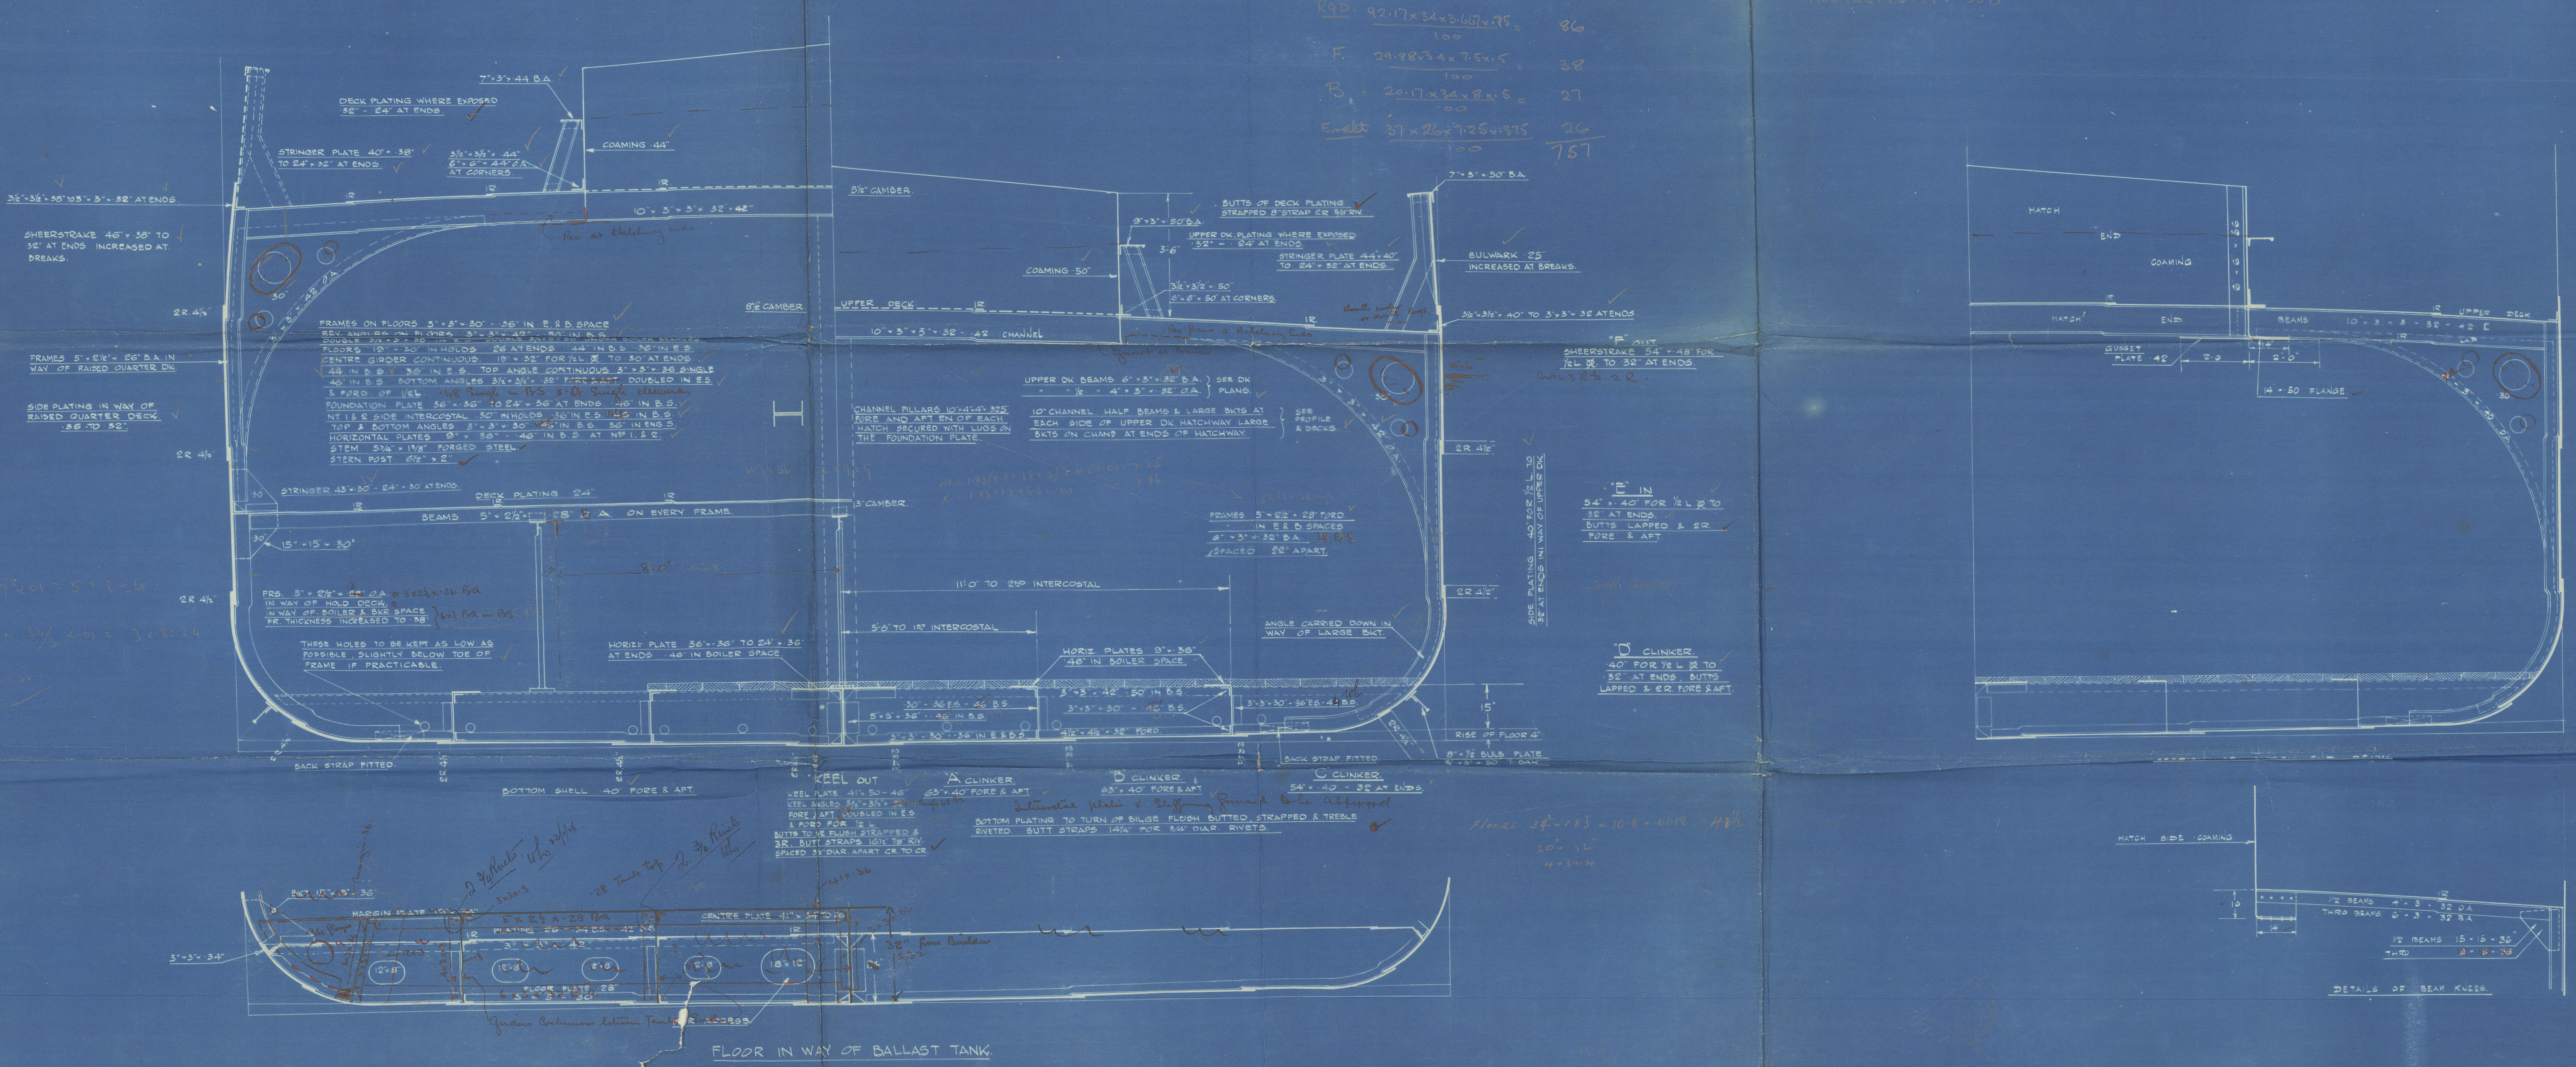

1
Midship Section

Lithgows Ltd

791.

9-12-25

T.S.S. "Arakoon"

T. 6. 24-2-26.



© 2020

Lloyd's Register
Foundation

008096-008100-0104

Lithgows

491

190' x 34' x 12'

MW. Section

T.C. 24/2/26
Bag.

Lithgows 151

491

Mid. Section

9.12.25.



© 2020

Lloyd's Register
Foundation

008046-008100-0104