
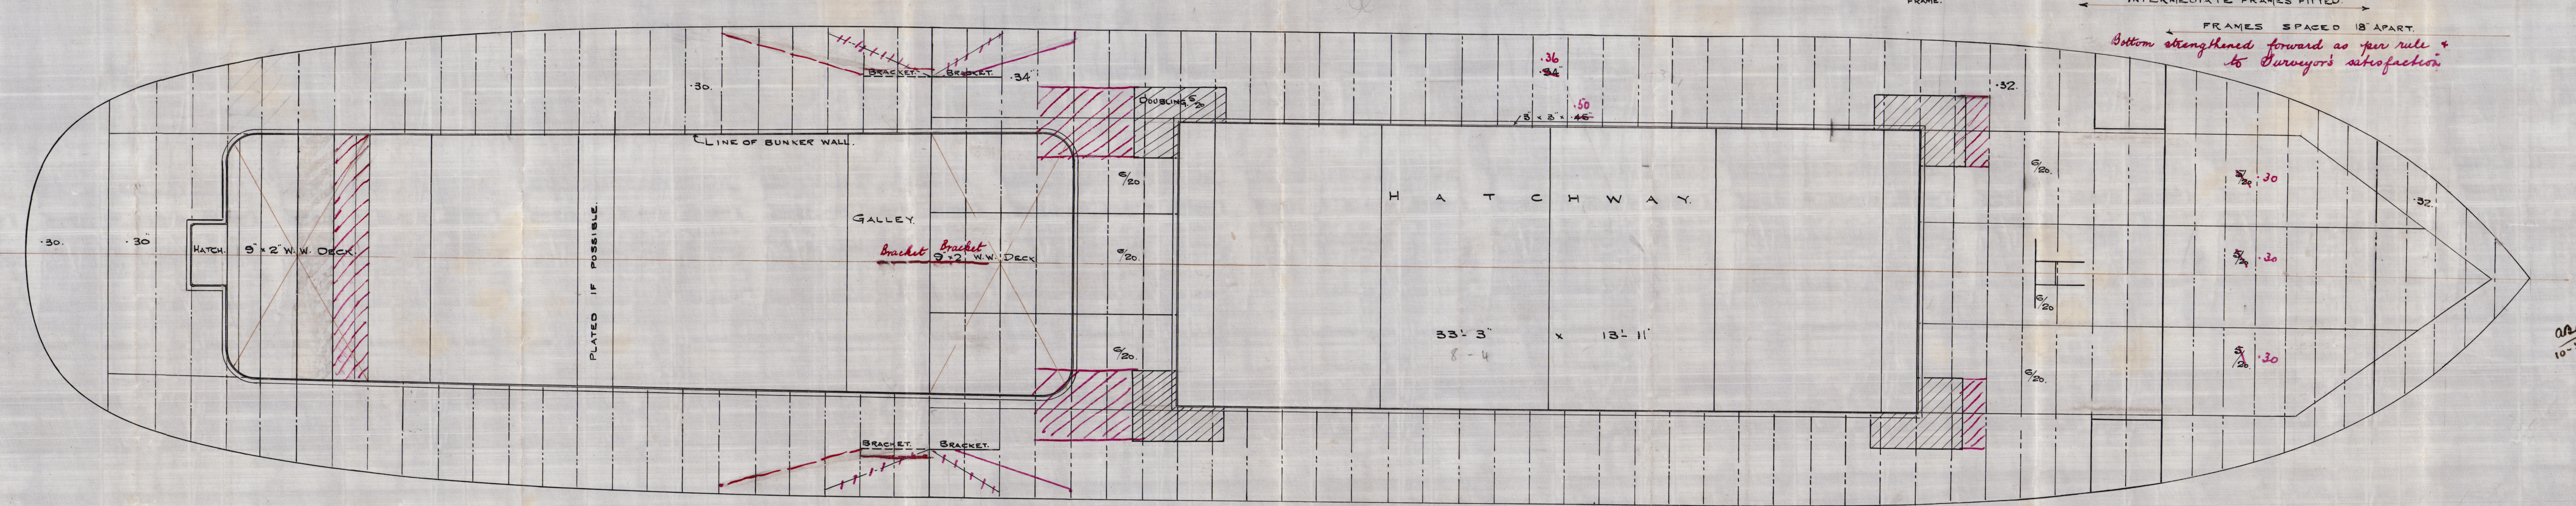


14-5-12
14-5-12

14-5-12

Nº 541
PROFILE & DECK PLAN
STEEL SCREW STEAMER
DIMENSIONS: 118'0" B.P. x 23'6" EXT. x 9'3" MLD.
SCALE 1/4" = 1 FOOT.

PLAN No. 1483
FOR ENCLOSURE TO
Messrs Lloyd's Surveyors
HULL FROM
COCHRANE & BONS
SHIPBUILDERS, LTD.
DATE 7/5/12. R.R.

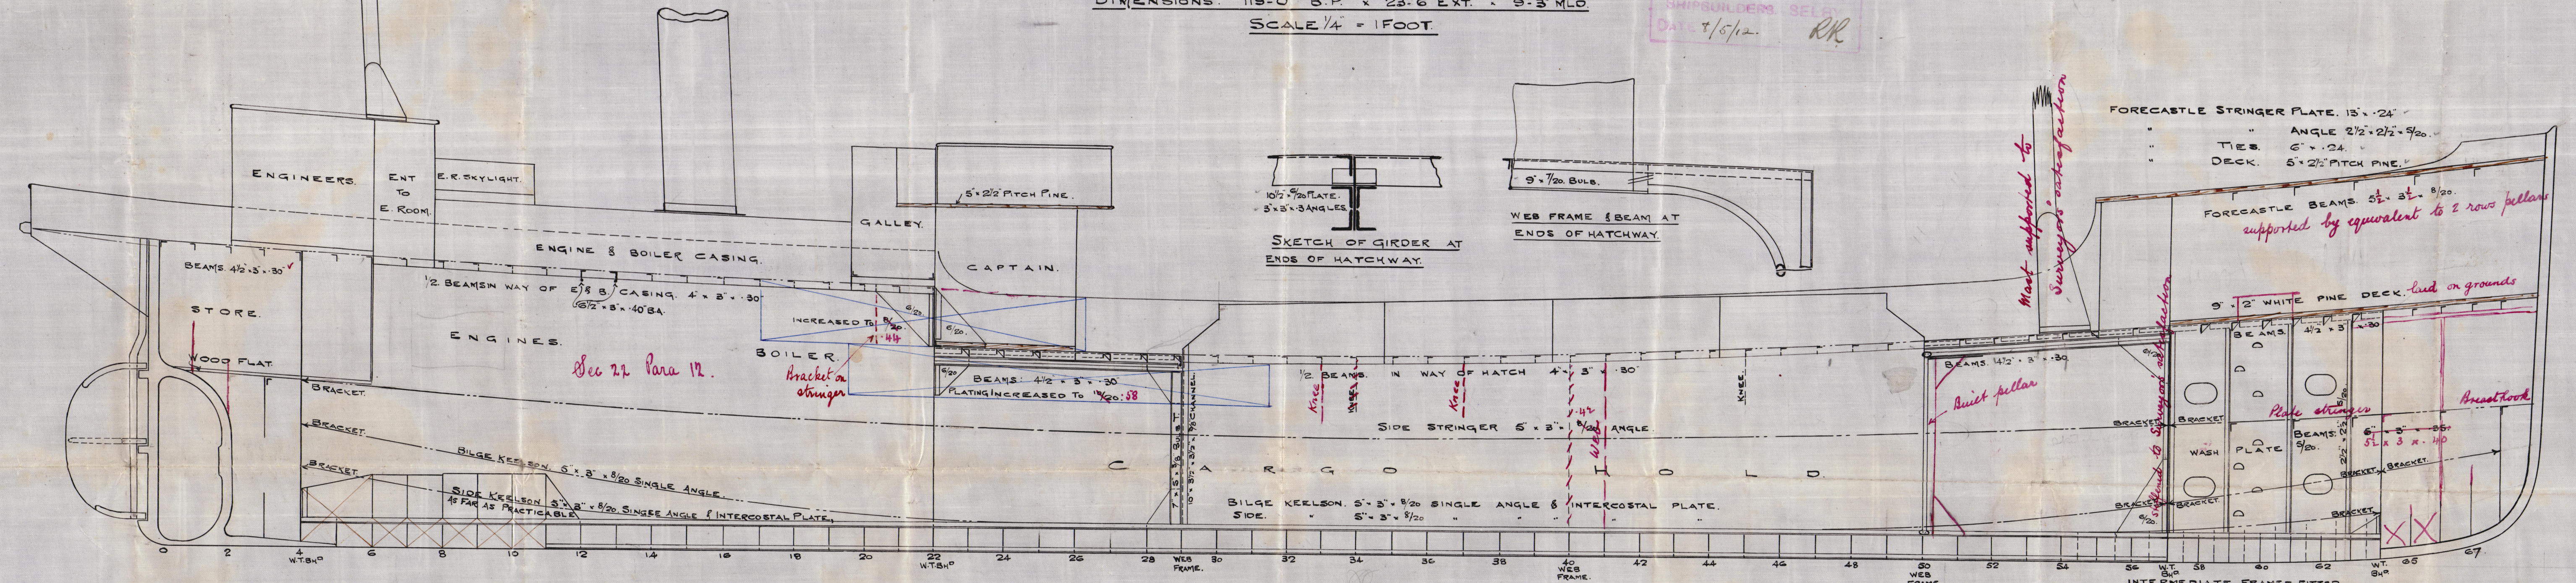

LLOYD'S REGISTER
OF SHIPPING
10 MAY 1912
HULL, 100

Cochrane & Sons
Profile & Deck Plan
No. 541

1/2 Byir Hull Report No: 25684

FRI. NOV. -8. 1912

2.

