



TO CLASS 100.A.1. AT LLOYDS.

LONGITUDINAL ELEVATION S.S. N° 118.

SCALE 1/8" = 1 FOOT.

N° 118 SHIP.

13.5.05
25.5.05
1.6.05

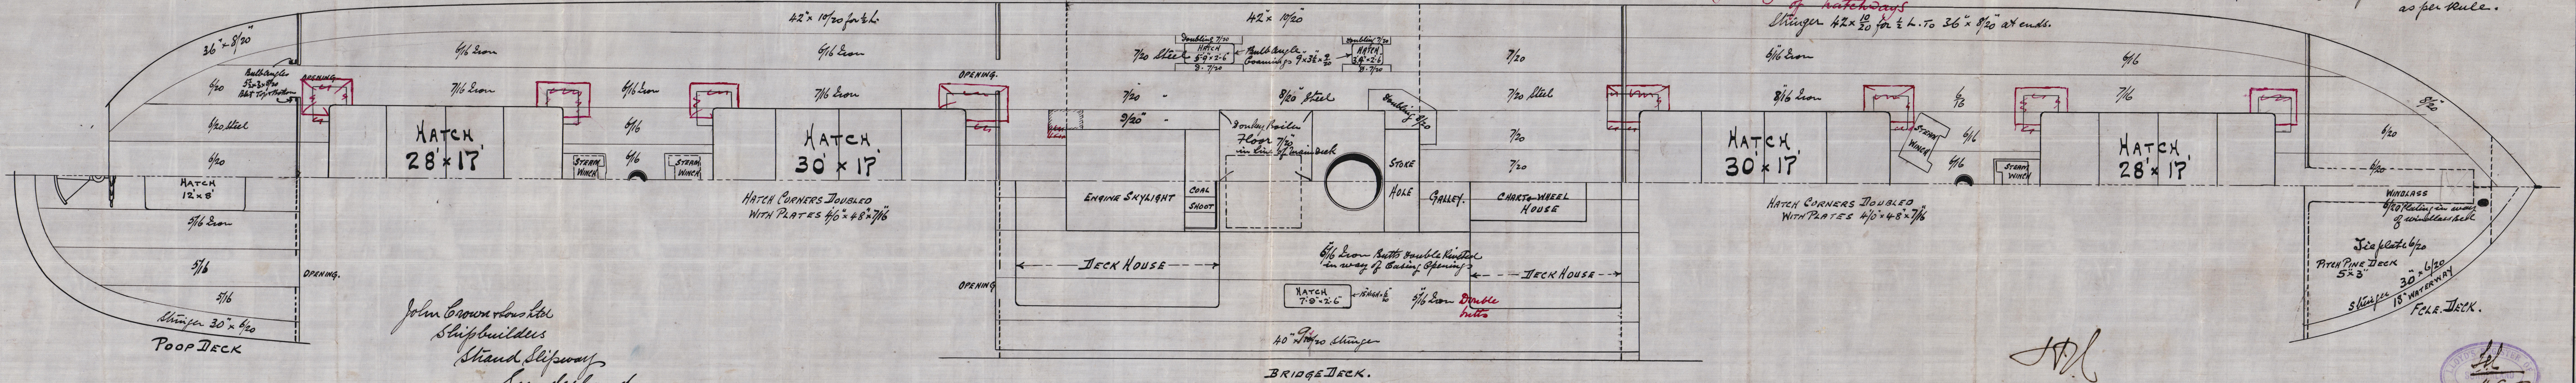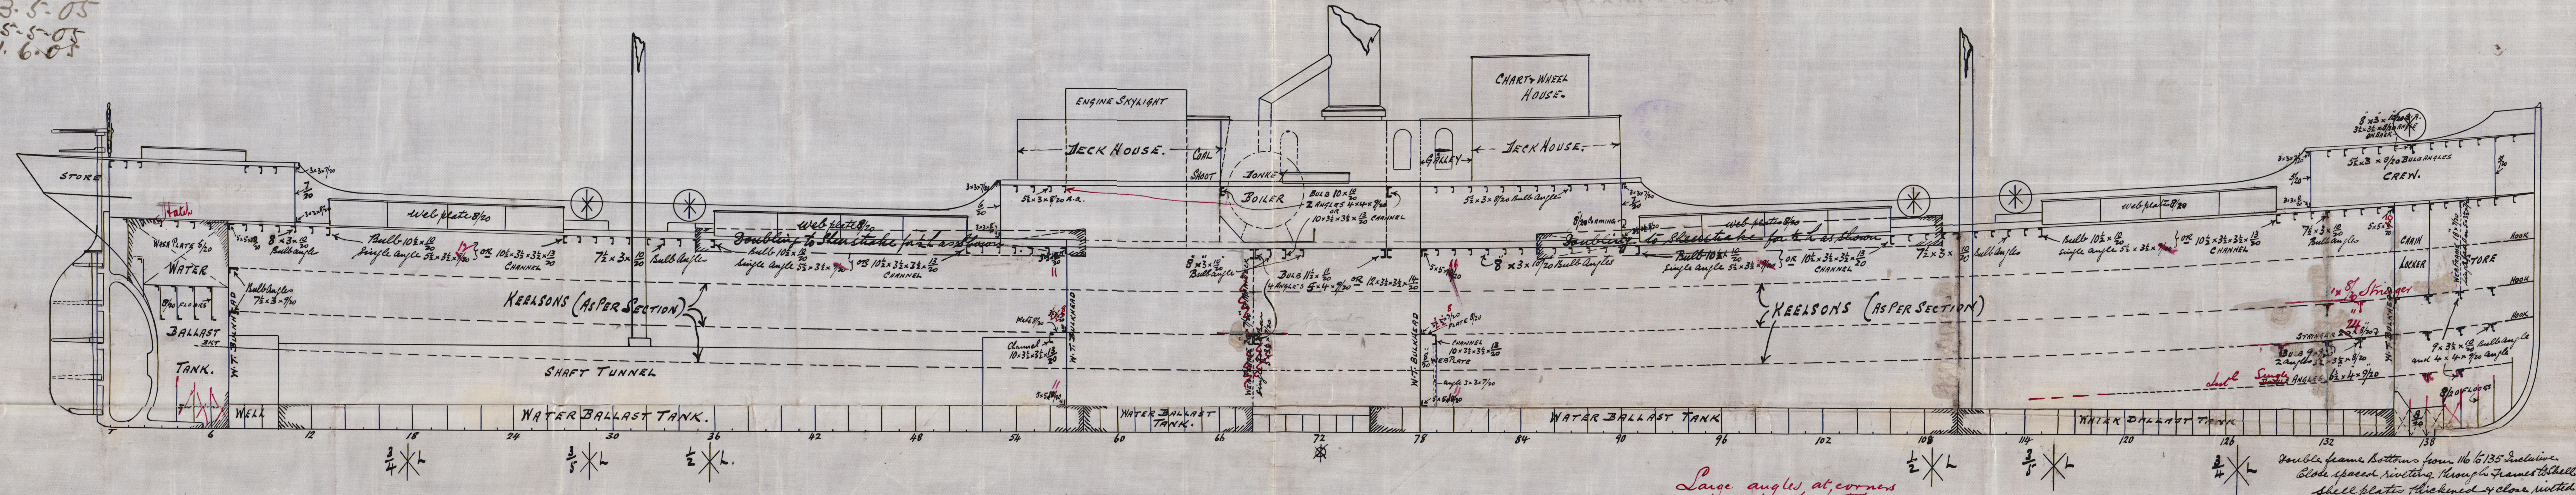

John Brown & Co. Ltd.
Shipbuilders
Glasgow
Sunderland
May 5/05.

12/5/05
25.5.05



Messrs John Brown & Co

Profile

No 118

S.S. "TRAFALGAR"

Sld. F. & No. 22400

008101-008114-0272

