
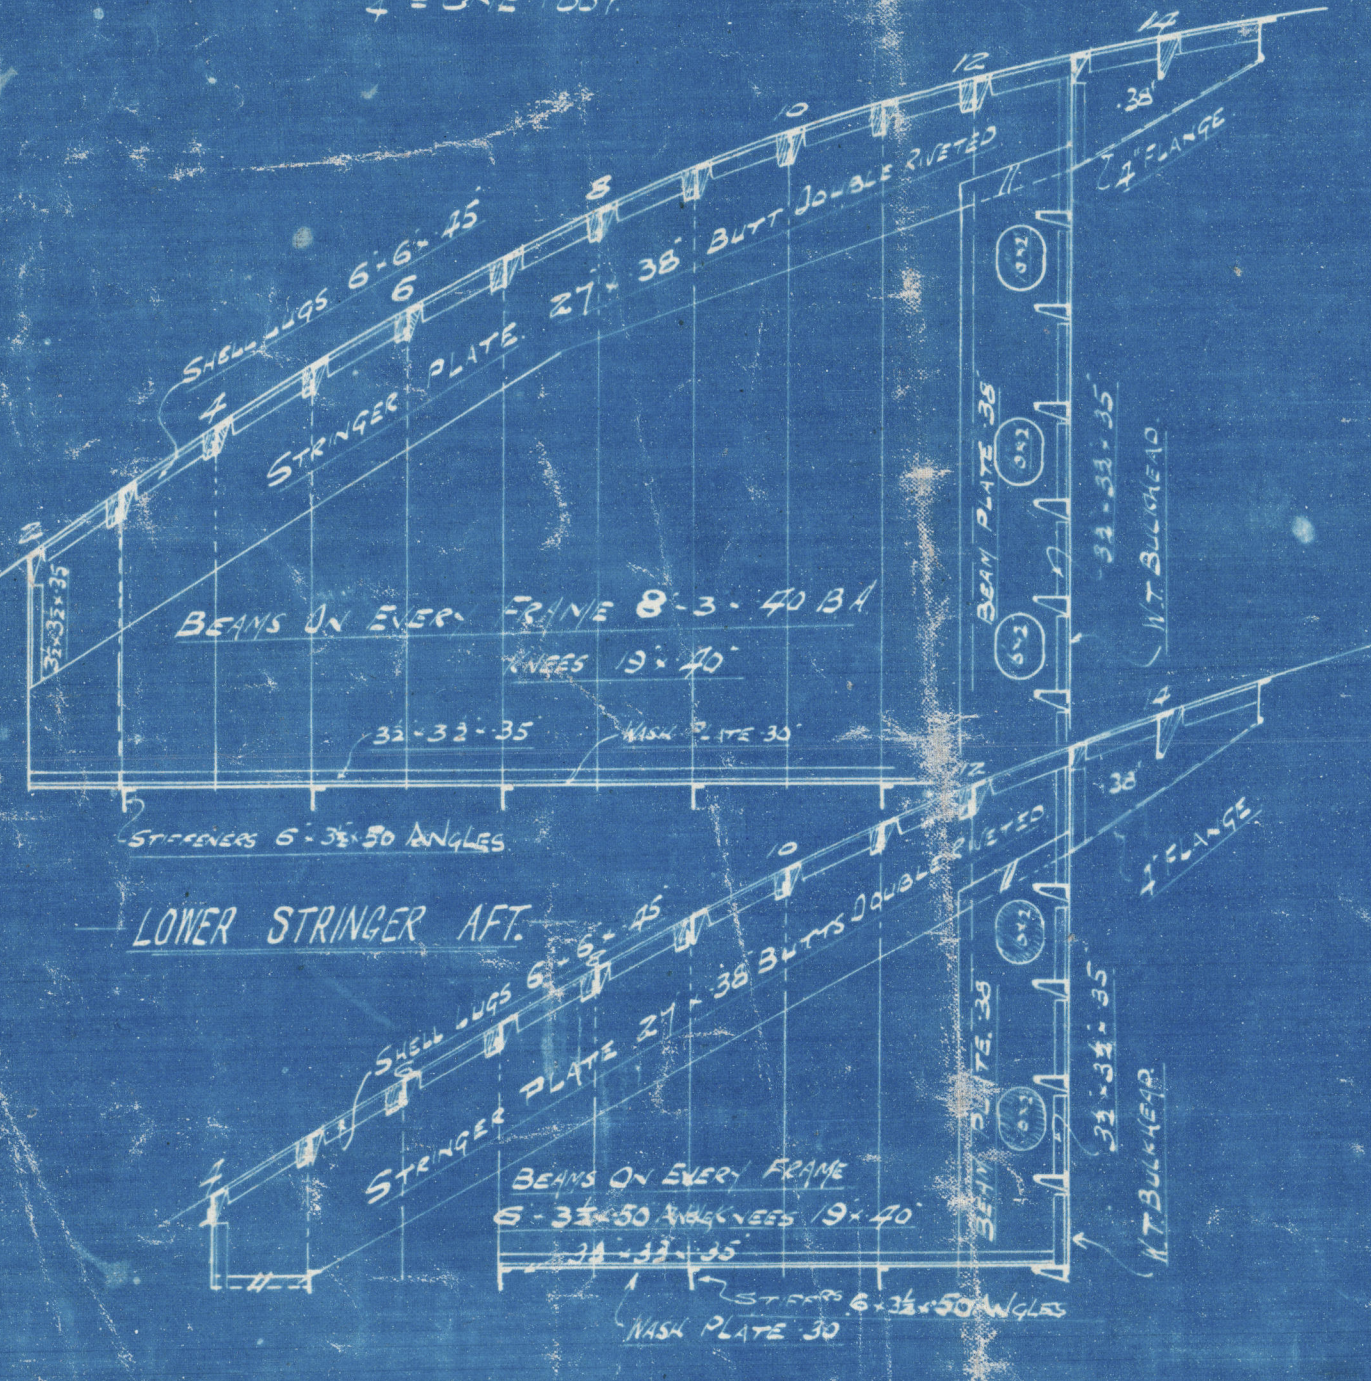


LENGTH 3.P 285.0
 BREADTH M.O. 41.9
 DEPTH M.O. 24.25
 SCALE 3" = 0.125 FT.

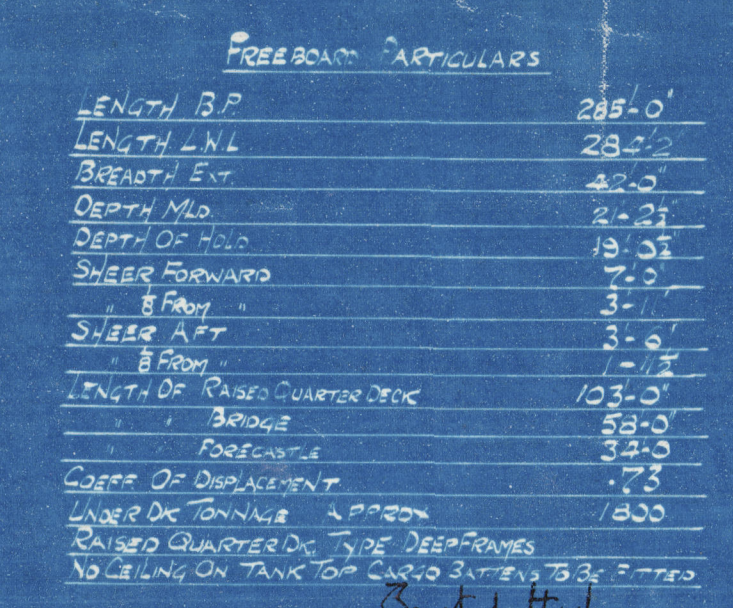

Bridge Sk extended
within line of
hatchway coamings

Standard Ship } C. Hill & Son
D. Type } Nos 127 & 8

Profile and Decks

See Ammunition Pools. General Arrangement
Plans of Water tight bulkheads & Deck

127 1/2 War Muster

1st Entry No 10192

128 1/2 War Repair

1st Entry No 10219

Jemine


Dis 3/15

D 63/B



© 2020

Floyd's Register
Foundation

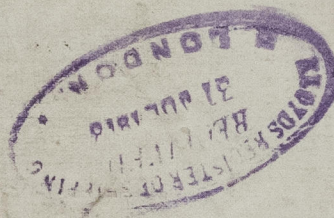



5210-121800-511800



© 2020

Lloyd's Register
Foundation

LLOYD'S REGISTER OF SHIPPING
RECEIVED
LONDON

5210-121800-511800



© 2020

Lloyd's Register
Foundation