




GENERAL ARRANGEMENT.

STANDARD VESSEL TYPE D

LENGTH 205'0" BREADTH 42'0" DEPTH 14'0" 2 1/2"

SCALE 3/8" = 1'00"

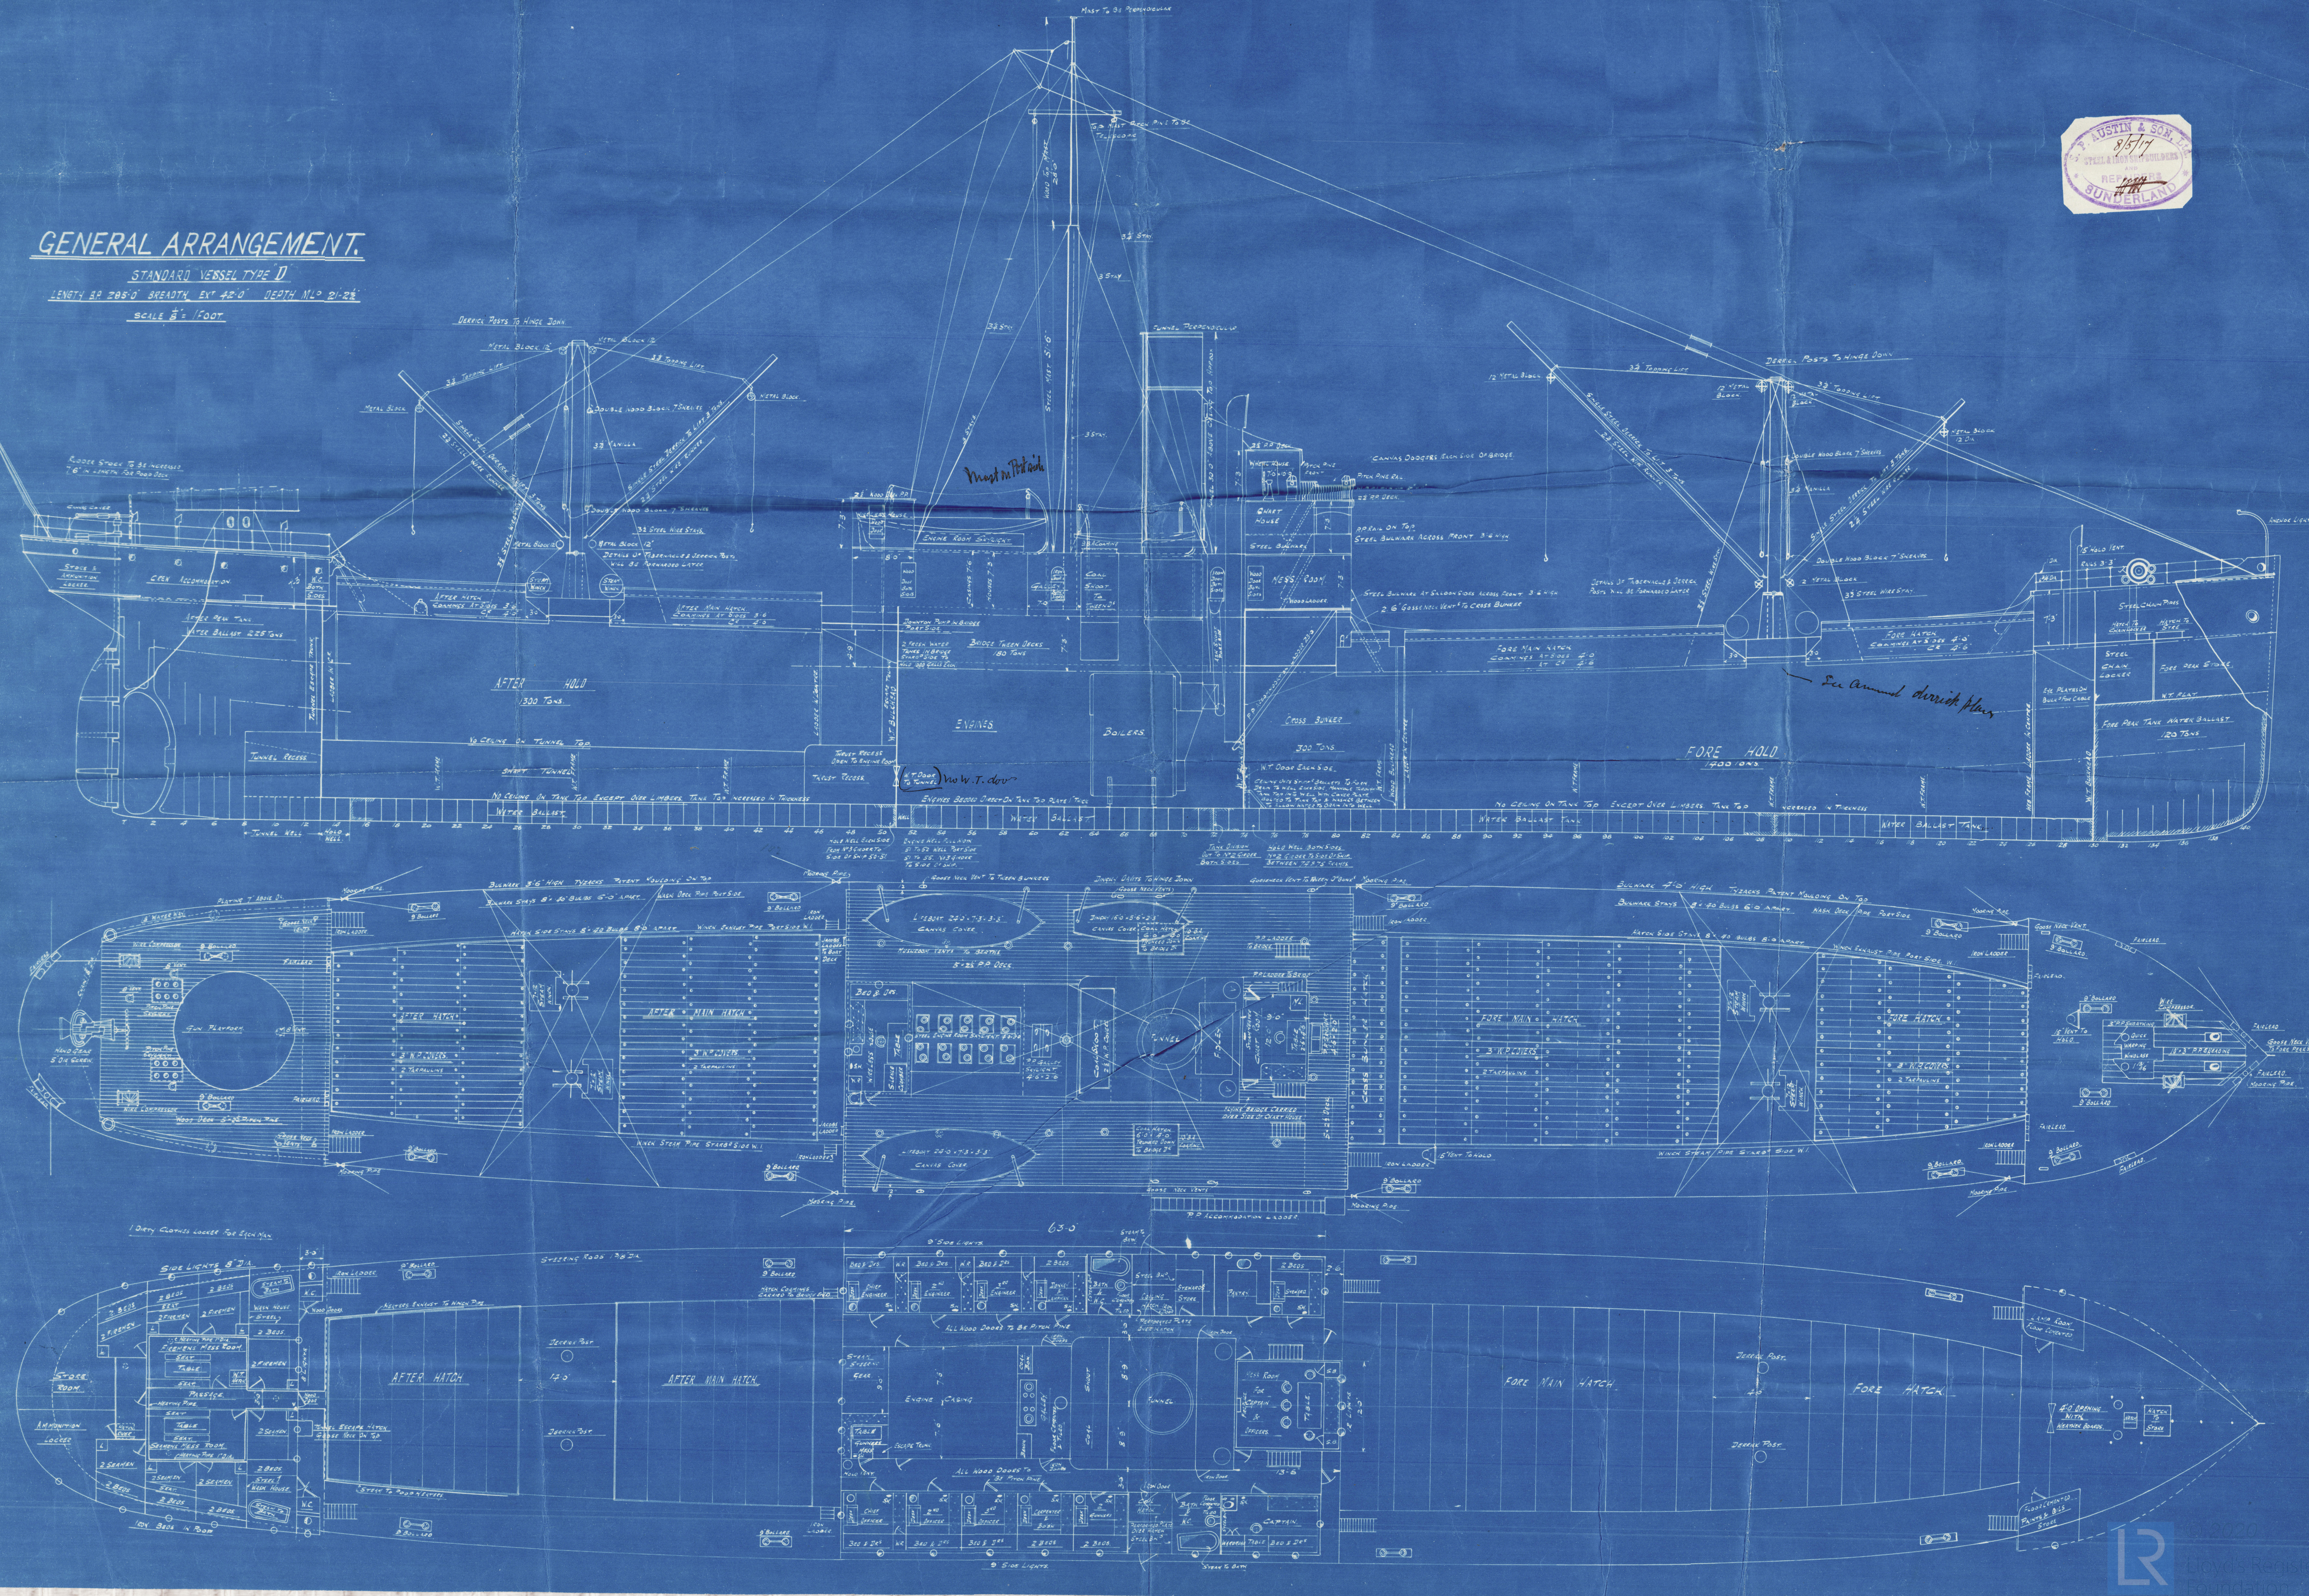



Standard Slips D Type
C. Hill & Son No 12748

Amended General arrangement
See Derrick Plan amended
& Mast position " 3.6.18

No 127 1/2 War Muster
1st Entry Report No 10192

No 128 1/2 War Papers
1st Entry No 10219

Janine
DS.193

8.5.17

