


ALTERATIONS				
NO.	DATE	DESCRIPTION	APPROVED	BY
1	1-6-45	REVISED BR. PK. BEAMS, ADDED BLWK. DETAIL & CHANGED NOTES OF MAIN PK. & KEEL PLATING.		

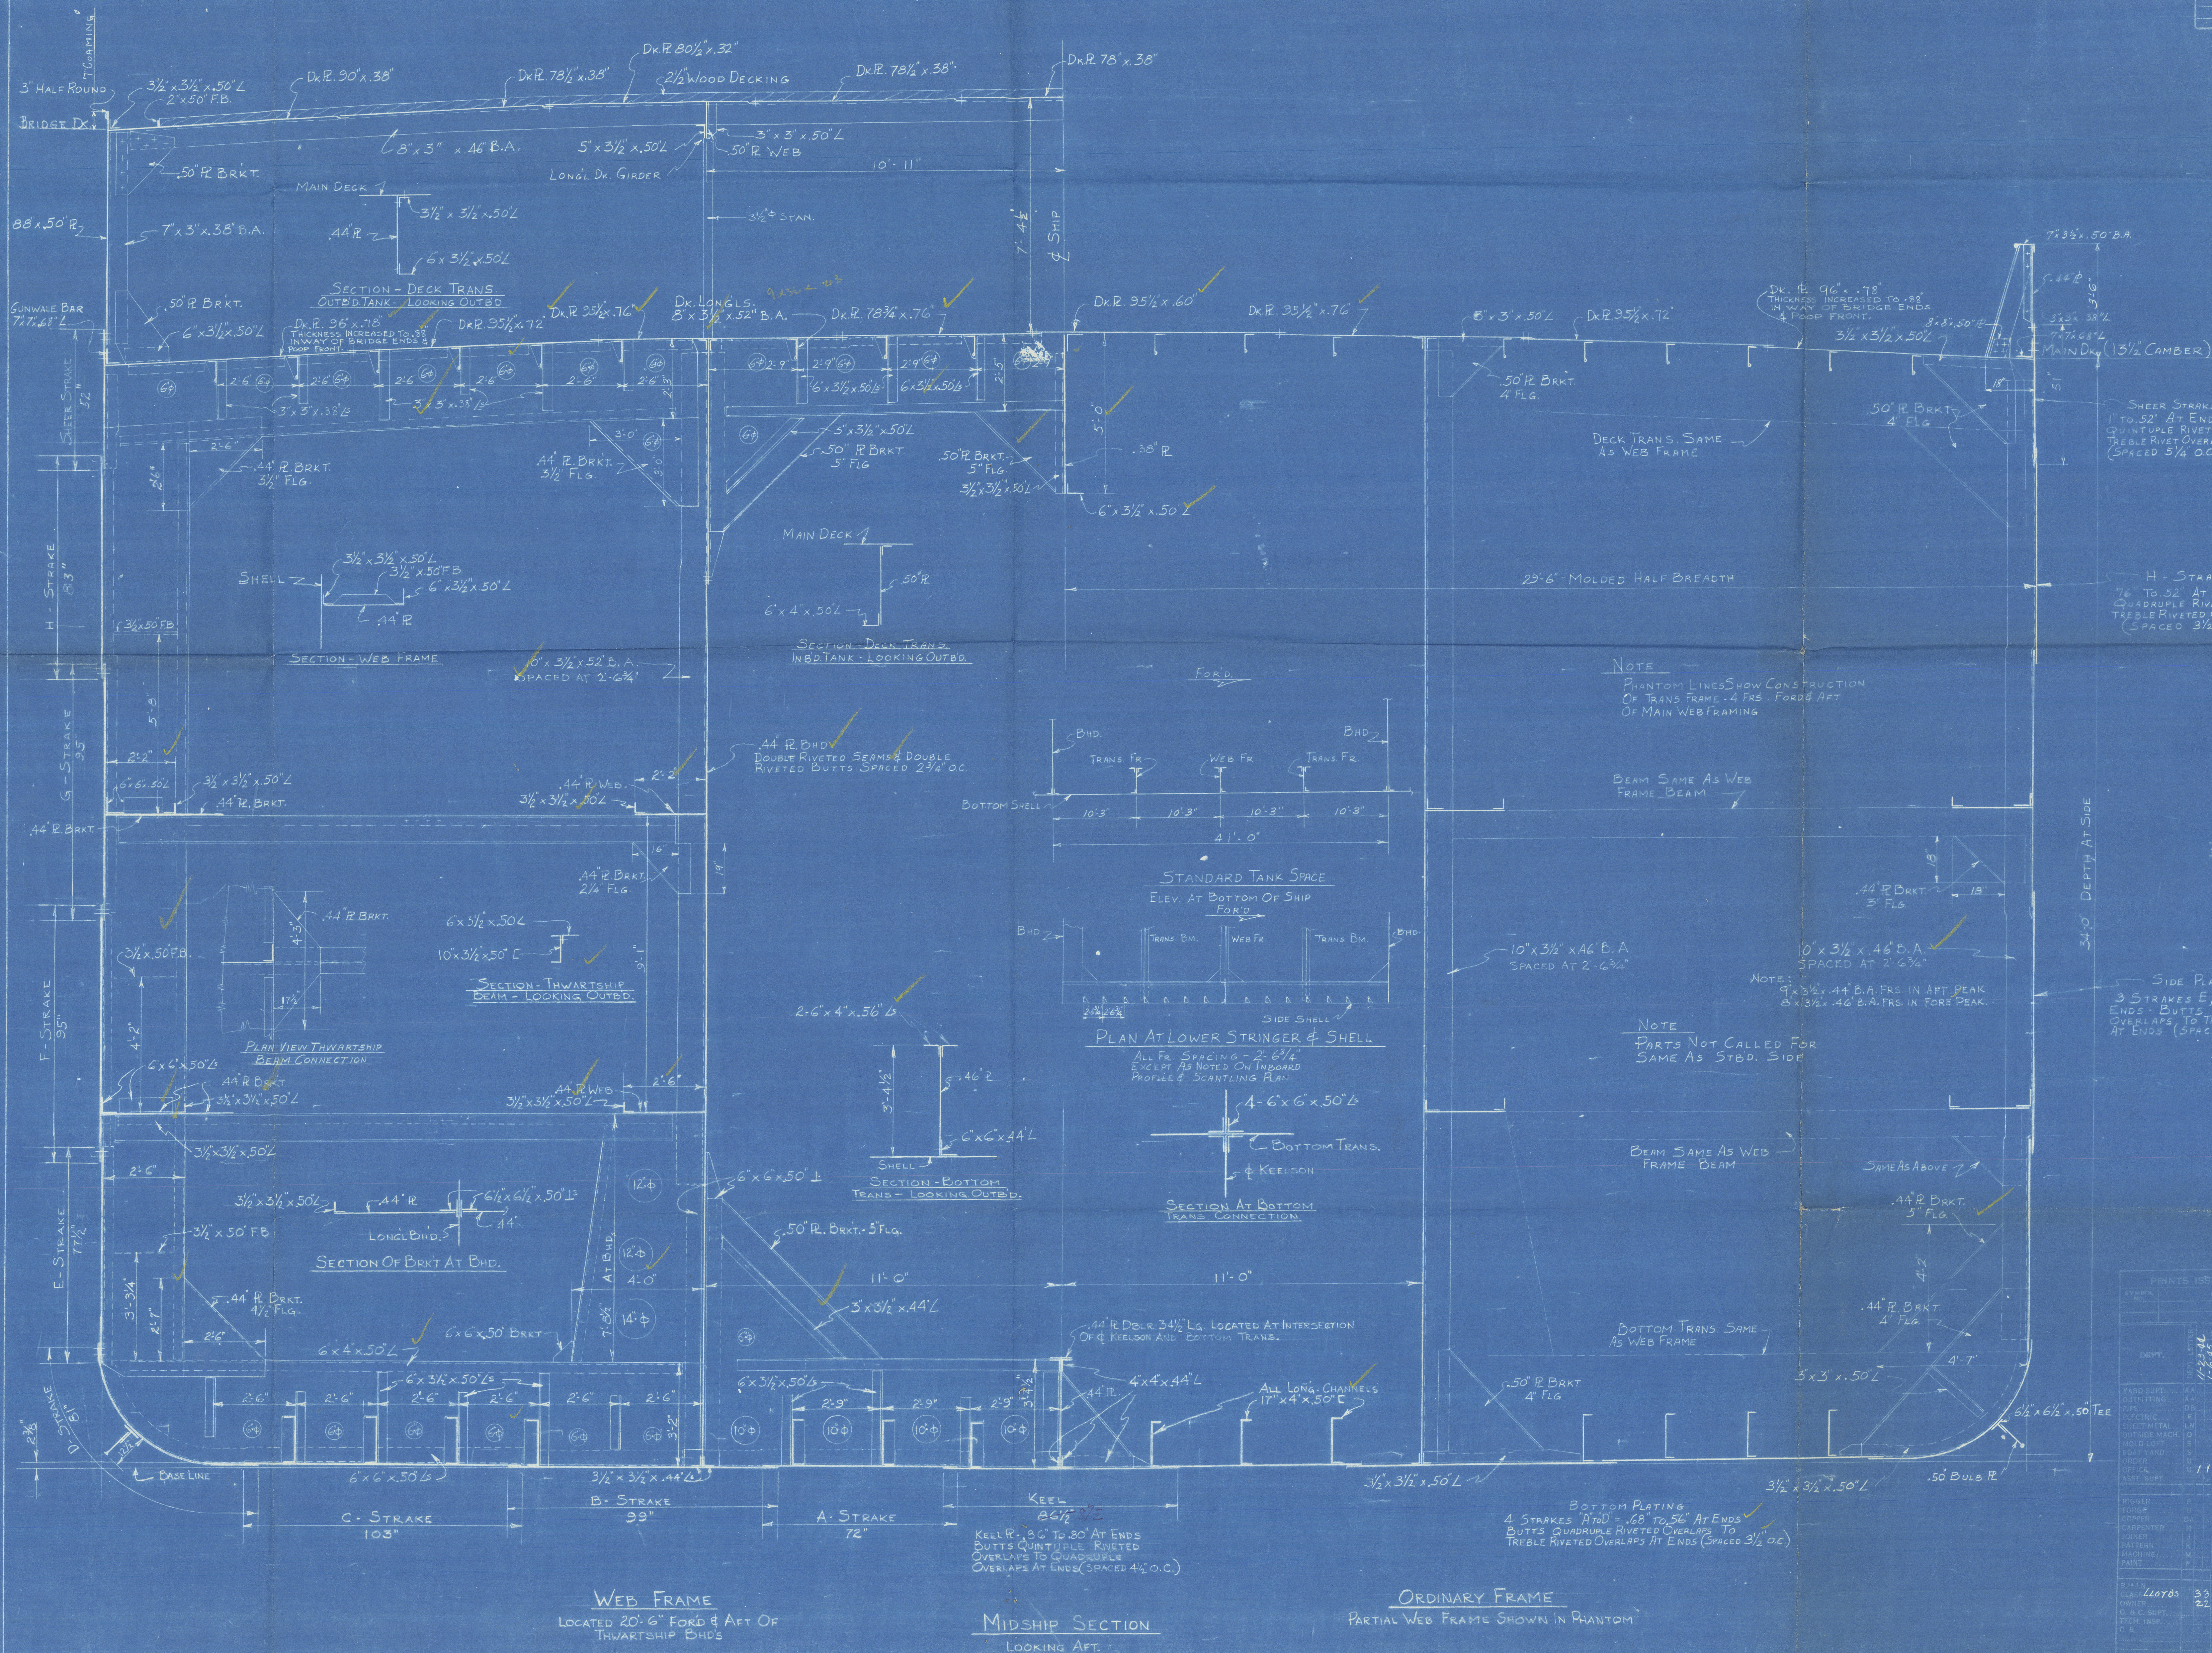

#### DIMENSIONS

LENGTH	460'-0"
BREADTH	59'-0"
DEPTH	34'-0"
CAMBER	13 1/2"

#### H - STRAKE

76" TO 52" AT ENDS - BUTTS  
QUADRUPLE RIVETED OVERLAPS TO  
TREBLE RIVETED OVERLAPS AT ENDS  
(SPACED 3 1/2" O.C.)

#### NOTES

ALL MEASUREMENTS ARE TAKEN FROM SHIP  
ALL SHELL LAPS DOUBLE RIVETED  
8 TIERS OF RIVETS BETWEEN FRAMES  
SPACED APPROX. 3 1/2" O.C.  
MEASUREMENTS TAKEN BY DRILLINGS OR  
THICKNESS AT EDGES.

#### REFERENCE PLANS

32049 - INBOARD PROFILE & SCANTLING PLAN  
32041 - DECK PLANS - FORECASTLE, BRIDGE, & POOP BHDS.

M. V. LAVORO

PRINTS ISSUED TO:		DATE ISSUED	
NO.	NAME	NO.	NAME
1	YARD SUP.	11/23/45	
2	OUTFITTING		
3	PIPE		
4	ELECTRIC		
5	STEEL DETAIL		
6	OUTSIDE MACH.		
7	WELD LOT		
8	COAT YARD		
9	ORDER		
10	WELD SUP.		
11			
12			
13			
14			
15			
16			
17			
18			
19			
20			
21			
22			

CONTRACT JQ-1440-68

BETHLEHEM STEEL COMPANY  
SHIPBUILDING DIVISION  
BALTIMORE YARD BALTIMORE, MD.

MIDSHIP SECTION

Drawn by: F.H.  
Checked by: J.H.  
Scale: 1/2" = 1'-0"  
Date: 11-18-44

DRAWING NO. 32024 ALT.-120