

PROFILE & DECK PLAN.

Nº 482.

DIMS 130'-0" x 22'-6" EX x 12'-9" M^{LO}

SCALE $\frac{1}{4}'' = \text{ONE FOOT}$


PLAN No. 4725
FOR ENCLOSURE TO
Messrs Lloyd's Surveyors
Hall
FROM
COCHRAN & SONS,
SHIPBUILDERS, SEASIDE
DATE 25/10/10 R.R.

C.B.
27.10.18

Profile & Deck Plan -
Cochrane & Sons

No 482

3/4 Vonollet. Hull Rpt No. 23718

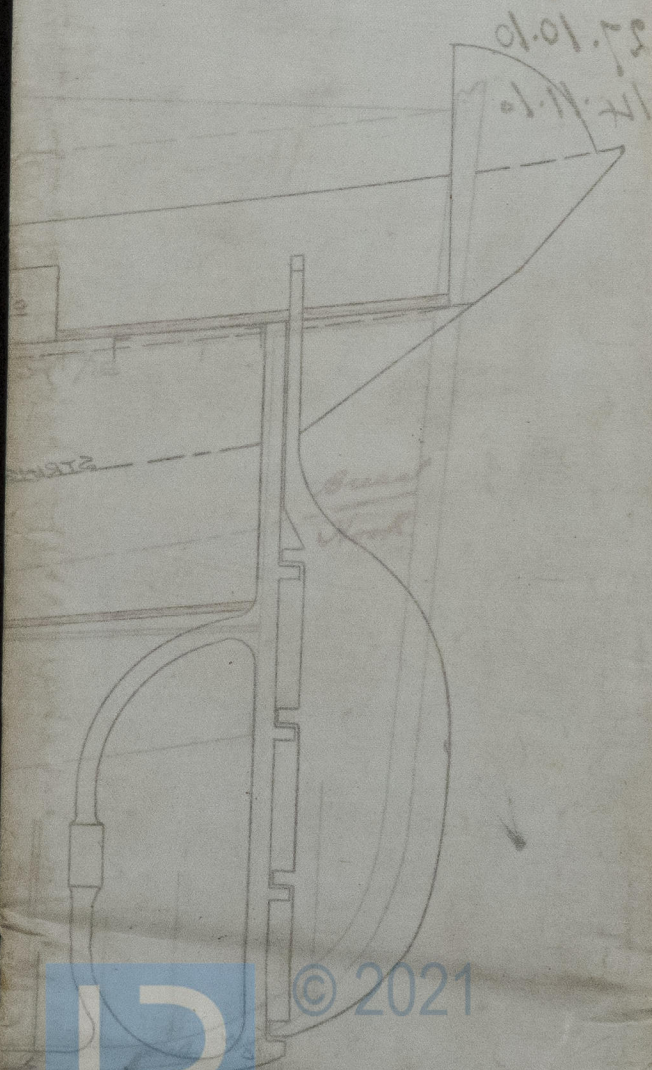

© 2021

Lloyd's Register
Foundation

048129-008136-0083