

Misses Lloyds Surveyors
Hull

MIDSHIP SECTION

STEEL SCREW TRAWLER

Nº 482.

DIMS 130'-0" x 22'-6" x 12'-9" M.L.P.


SCALE $\frac{1}{2}$ " = ONE FOOT

- TO CLASS 100 A1 AT LLOYDS FOR FISHING
- PURPOSES, ENGINE & BOILER CASING AS PREVIOUSLY
- APPROVED, DECK PLATED OVER IN WAY OF ENGINE
- AND BOILER CASING.

27.10.10
14.11.10

25/10/10

RR

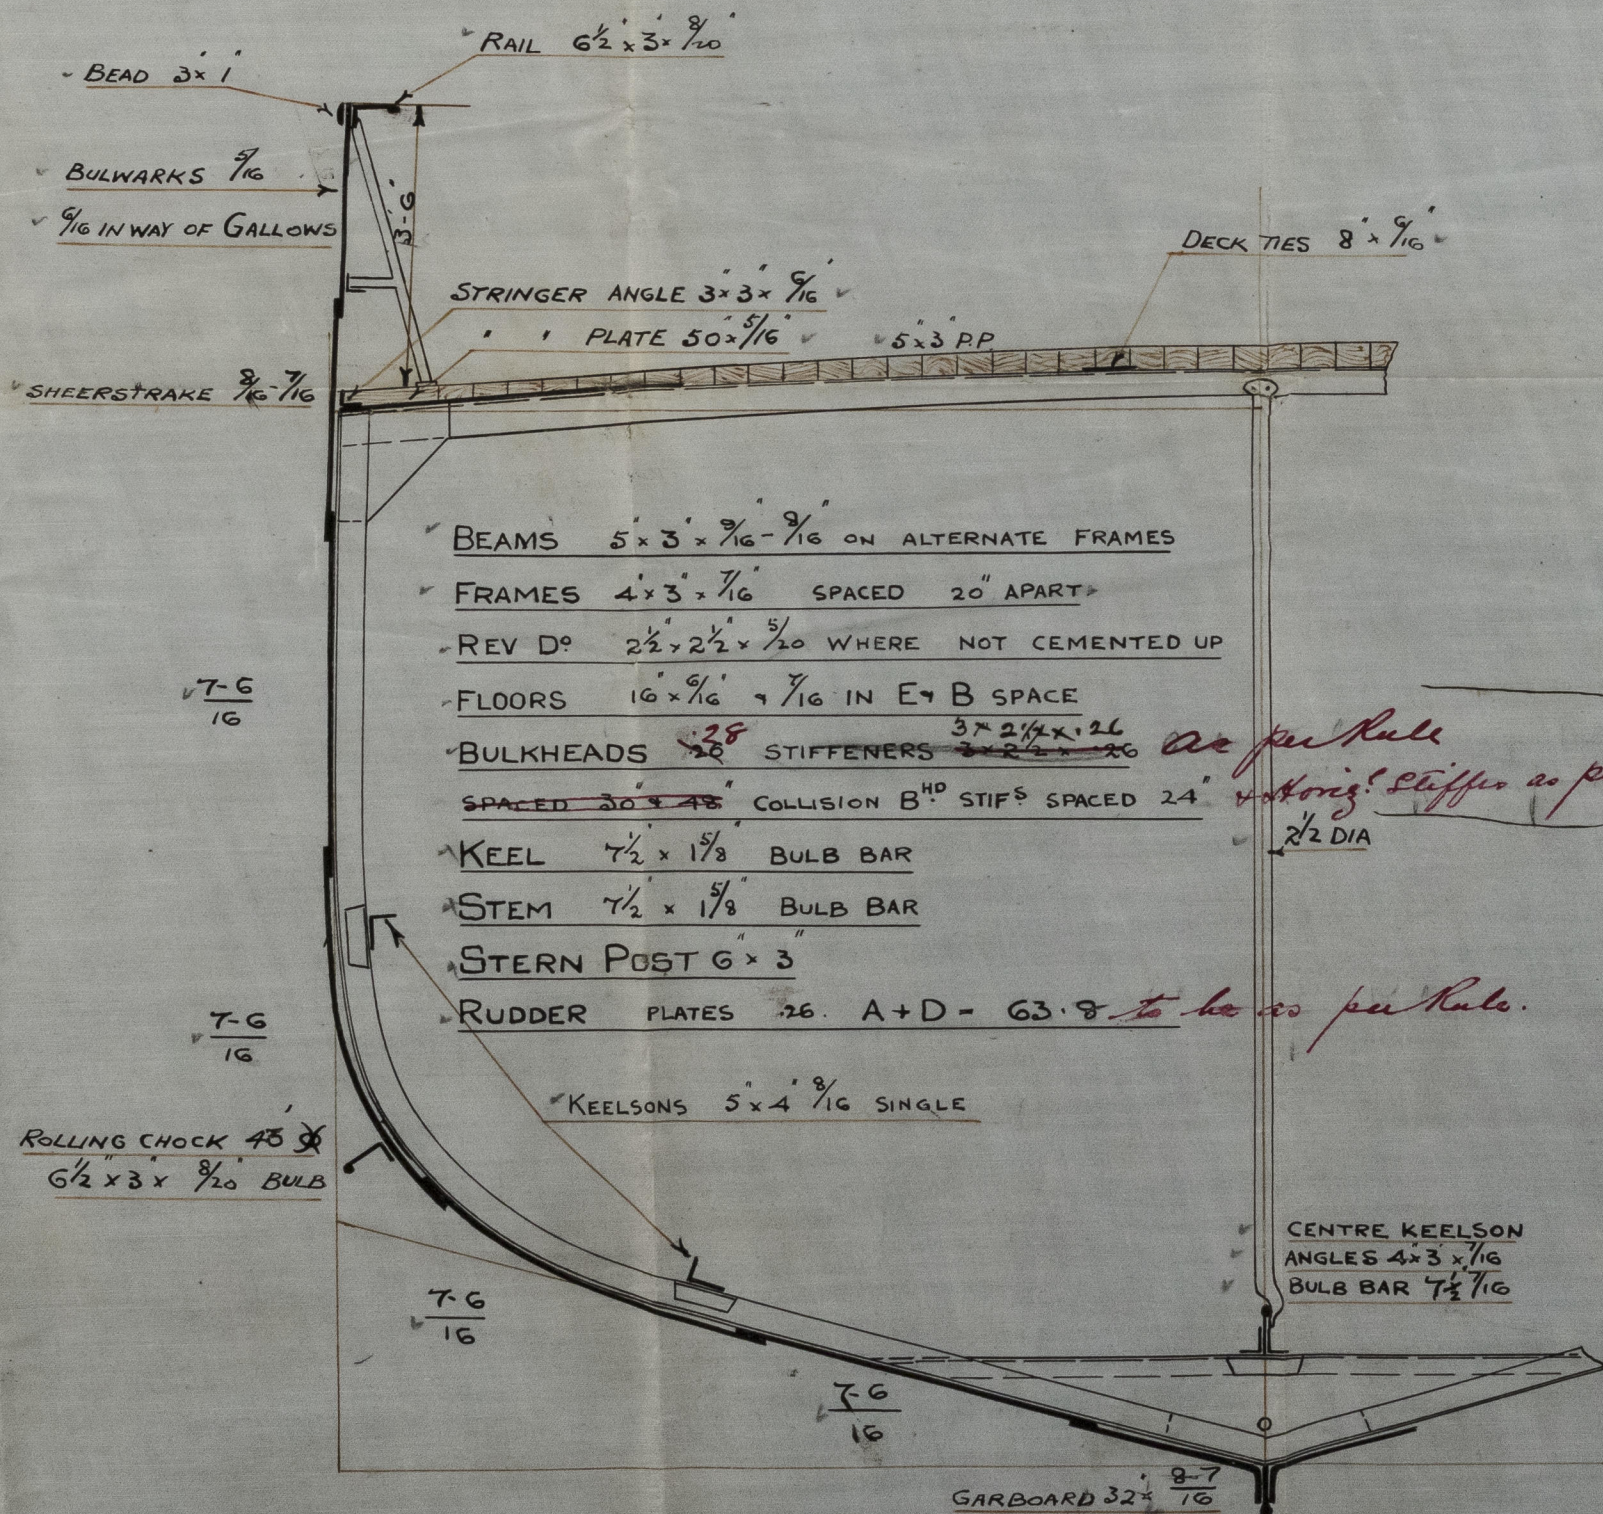

NUMERALS

B+D = 35.12 ✓

L x (B+D) = 4565.60 ✓

PROPORTIONS

$\frac{L}{D}$ = 10.19 ✓

$\frac{L}{B}$ = 5.8 ✓

EQUIPMENT

1ST BOWER ANCHOR	5 3/4 CWTs EX STOCK.
2ND " "	5 1/4 " " "
KEDGE ANCHOR	3 " " "
105 FATHOMS	1 1/2 CABLE.
60 "	6 " HAWSER.
60 "	5 " WARP.

RIVETING

- BUTTS OF GARBOARD & SHEERSTRAKE STRAPPED
- DOUBLE RIVETED, REMAINDER OF SHELL
- LAPPED & DOUBLE RIVETED BULWARKS
- SINGLE RIVETED.

27.10.10.

© 2021

Lloyd's Register
Foundation

008124-008136-0084

- Midship Section -
Boehman & Sons

No 482

1/2 Vonollet Hull Rpt No. 23718

original copy to be made
Hull

AK






© 2021

Lloyd's Register
Foundation

008129-0076-0084