


22 DEC 1922

Approved  
See Oct 11/22

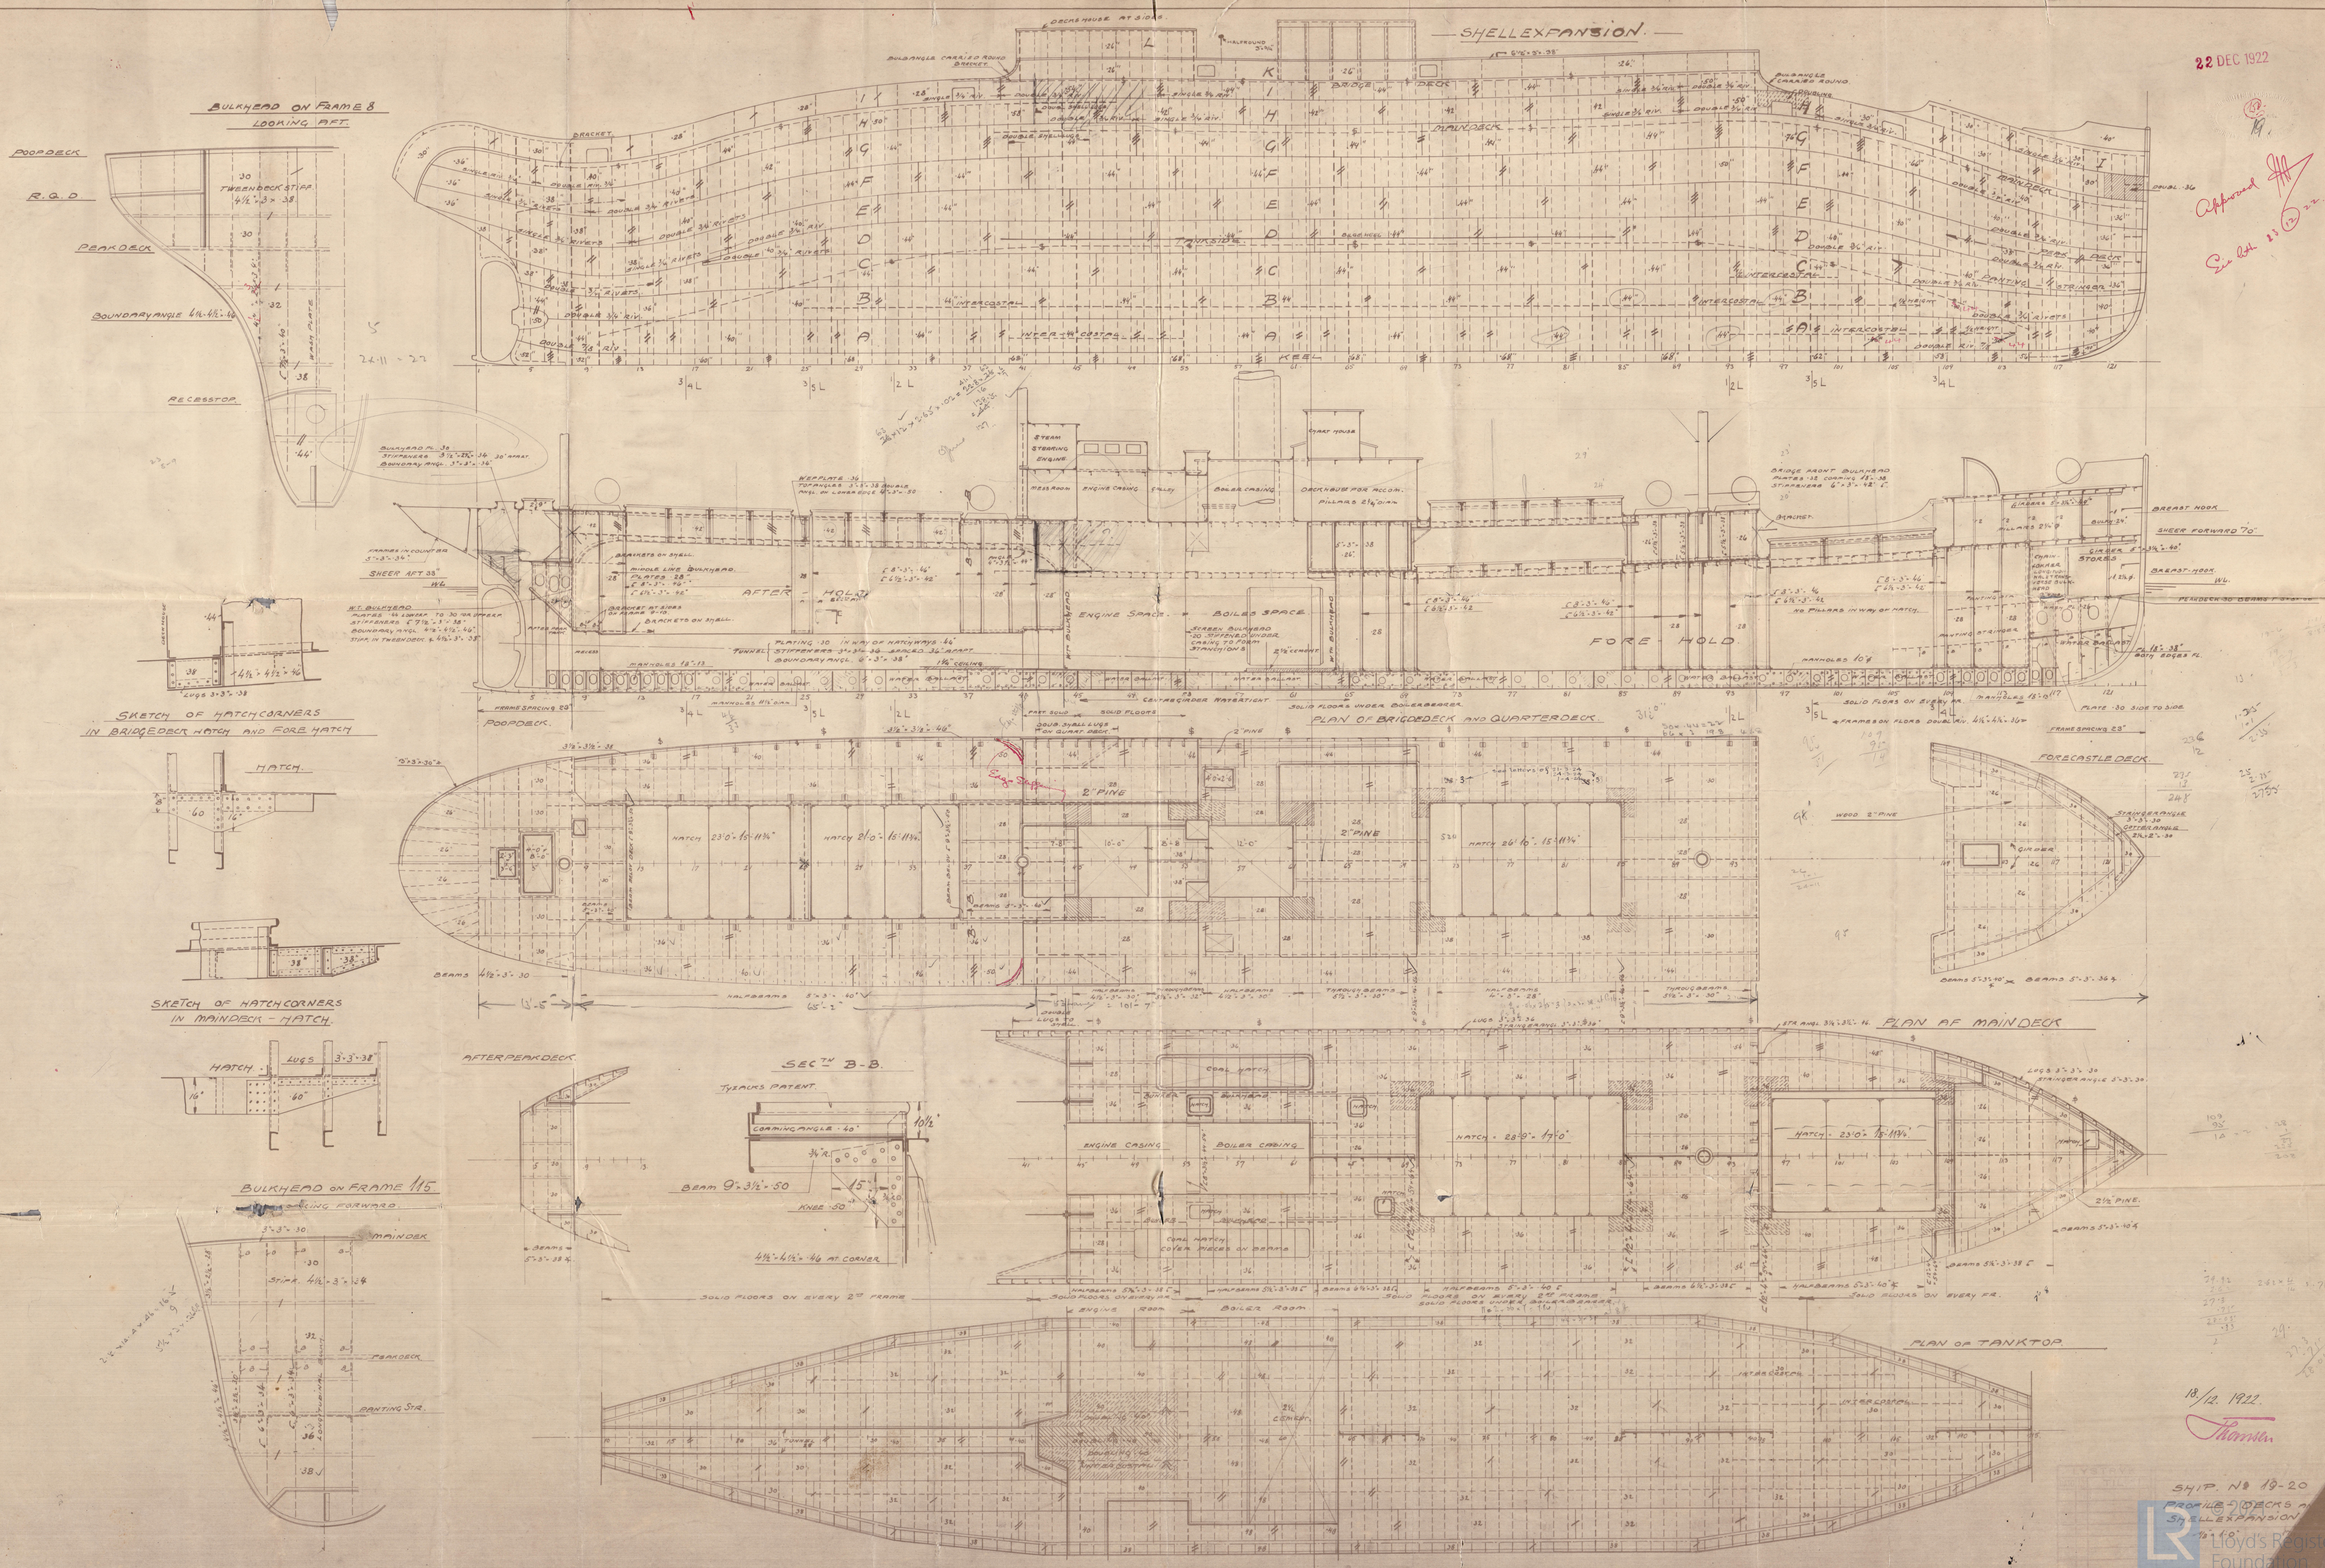

18/12. 1922

Thomson

SHIP NO 19-20  
PROFILE OF DECKS & SHELL EXPANSION  
Lloyd's Register Foundation

008129-008130-0110



Makskov Skibsvaerft  
No 19-20  
Profile decks + shell

Box

TC 21- 2 23

Makskov. Skibsvaerft  
No 19-20

profile + decks

735 + 36 x 15'9"

now "Alice Lonn" 23.12.22

19. "ALICE" \*

20. "FREYA"



© 2021

Lloyd's Register  
Foundation

00812 008136-0110