

SHIP N° 19-20

MIDSHIP SECTION.

SCALE 1/2" = 1'-0"

LENGTH AS PER RULES 235'-0"
 BREADTH MOULDED 36'-0"
 DEPTH MOULDED TO MAINDECK 15'-9"
 HEIGHT OF RAISED QUARTERDECK 3'-11"
 HEIGHT OF BRIDGE AND FORECASTLE 7'-0"
 TYPE: SINGLEDECK WITH R. Q.U.D. POOP, LONG BRIDGE AND FORECASTLE.
 CLASS: THE BRITISH CORPORATION B.S.W. STEEL.
 RIVETED WITH STEELRIVETS.

Approx draught = 15'-0"

EQUIPMENT NUMBER.	TONN. UNDER MAINDECK	999
FOR R. Q.U. DECK	18	
POOP, BRIDGE AND R.C. DECK	175	
DECKHOUSE	39	
TOTAL	1261.	

CN°

23510.360 x 15.75 x 75	=	1000.
145 100	=	183
145 360 x 7.0 x 15	=	246
100 4	=	82
65 x 360 x 7.0 x 75	=	70
100	=	53
42 x 360 x 7.0 x 15	=	1351
110	=	1306


EQUIPMENT.

2 STOCKLESS ANCHORS	25 CWT.
1 ANCHOR	24
1 STREAM	9 1/2" EXL STOCK

240 FATH. 19/16" STUD CHAIN CABLE	
1 OFF 90 FATH. 3/8" STEELWIRE WITH REEL	
1 " 90 " 3/8" " " " " " "	
1 " 90 " 2 1/2" " " " " " "	
2 " 90 " 2 1/4" " " " " " "	
1 " 90 " 5 1/2" MANILLA	
1 " 90 " 5" " " " " " "	
1 " 90 " 3" " " " " " "	

ALL COLD FLANGED MATERIAL TO BE B.E. QUALITY.

ALTERNATIVE ARRANGEMENT OF SHIFTER BEAMS

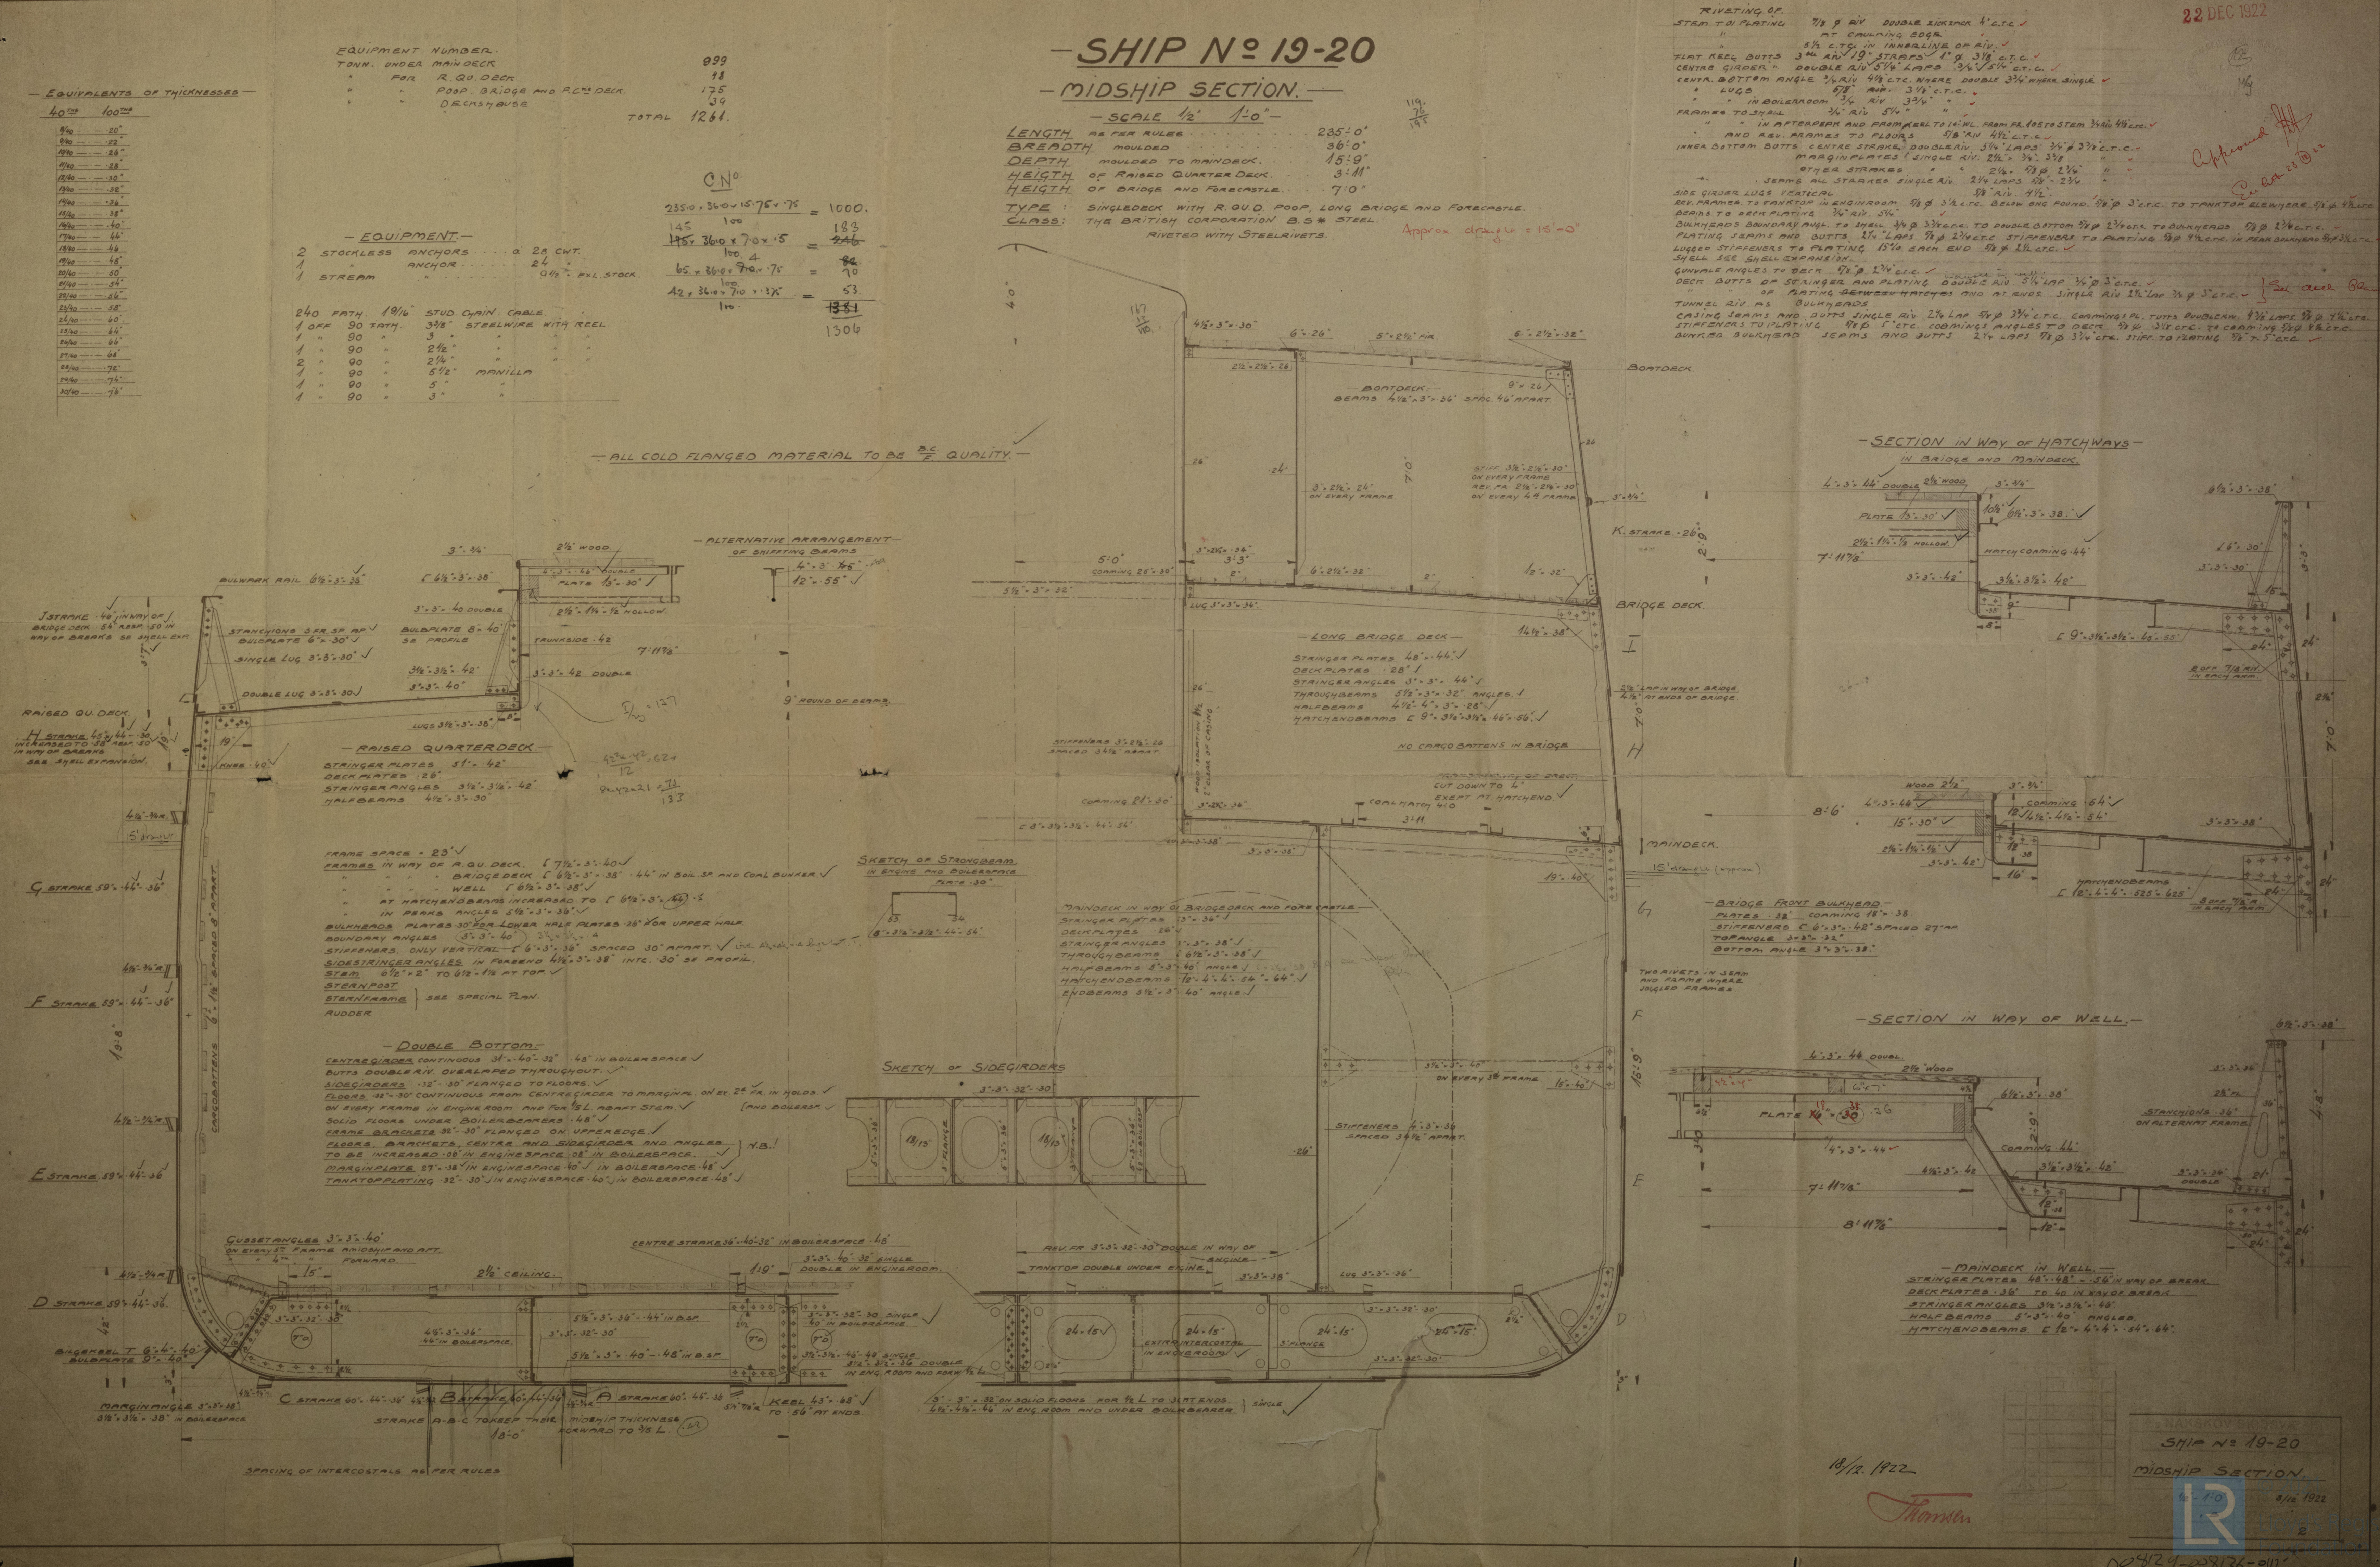

SECTION IN WAY OF HATCHWAYS

SECTION IN WAY OF WELL

SHIP N° 19-20
 MIDSHIP SECTION

18/12/1922

Thomson

10 1/2 1922

004124-008136-0112

Kakskov Skibsværft

19-20

Mid Sect

235 x 36 x 15.9

Bsg

TC

21.

2.

23

Kakskov - Skibsværft.

no 19 + 20

Midship Section

235 + 36 x 15.9"

Now "Alice Lonn"

23.12.22.

19

"ALICE"*

20

"FREYA"



© 2021

Lloyd's Register

Foundation

00812908156-0112