

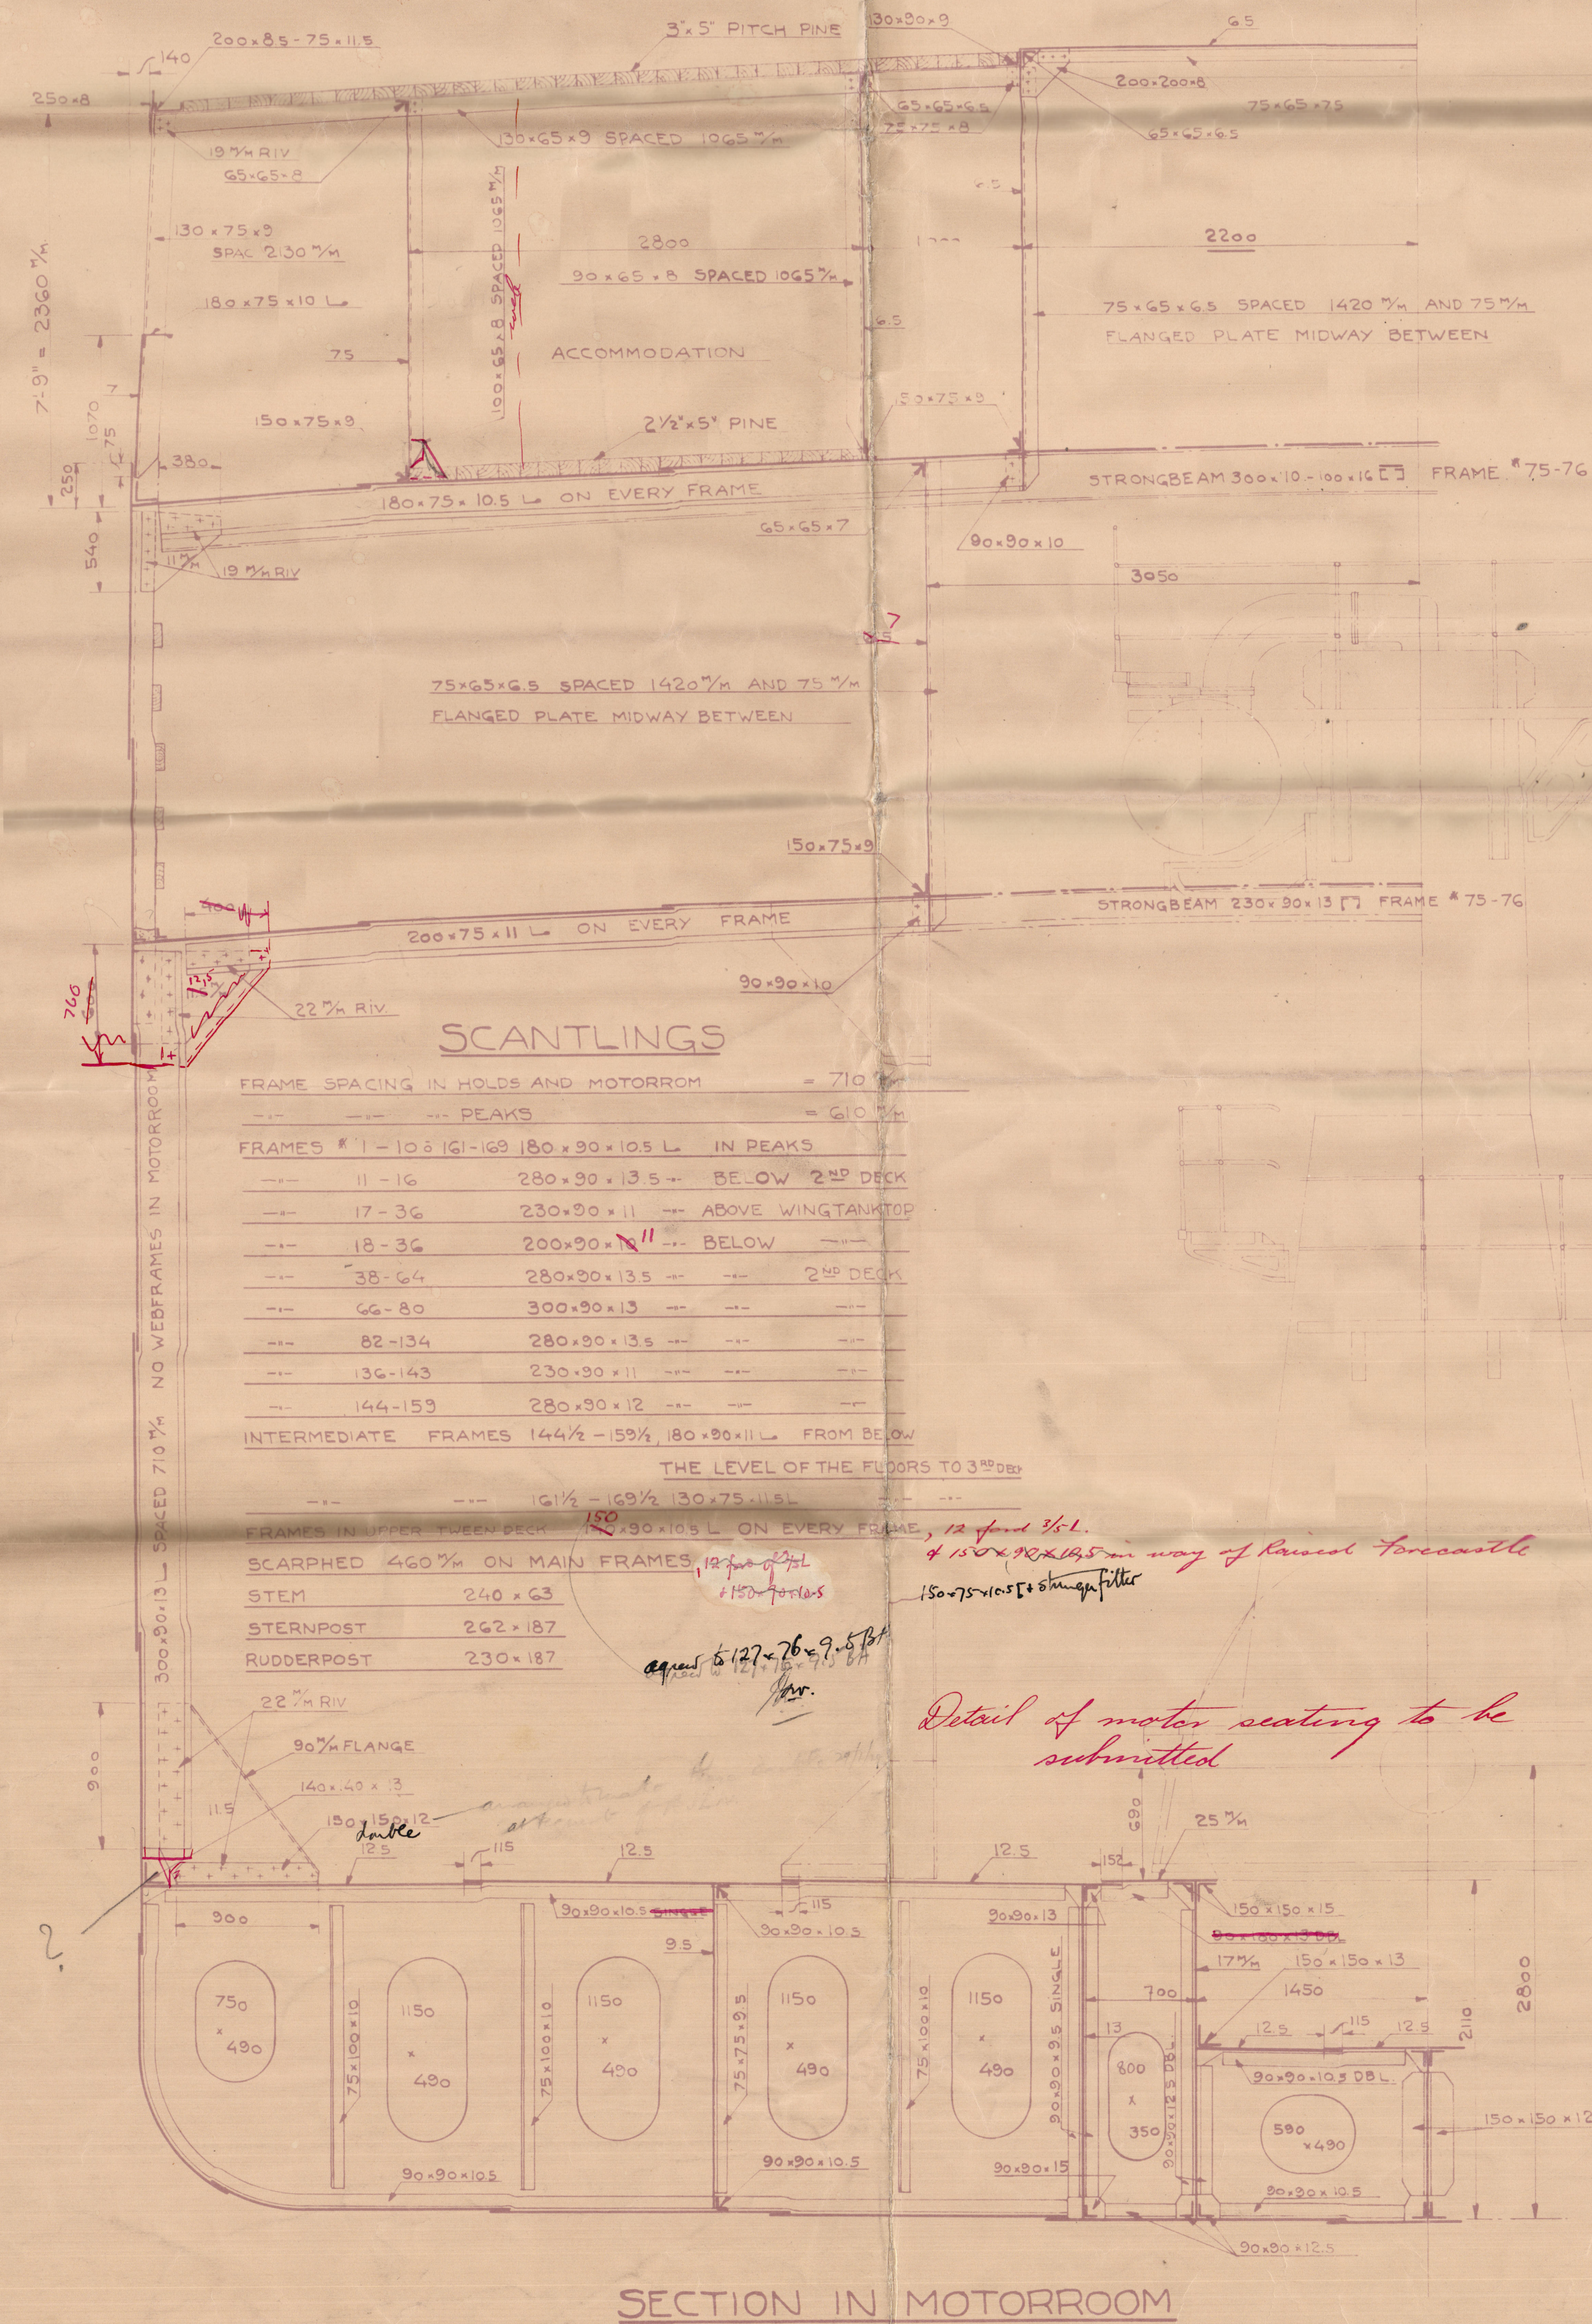


17/9/48

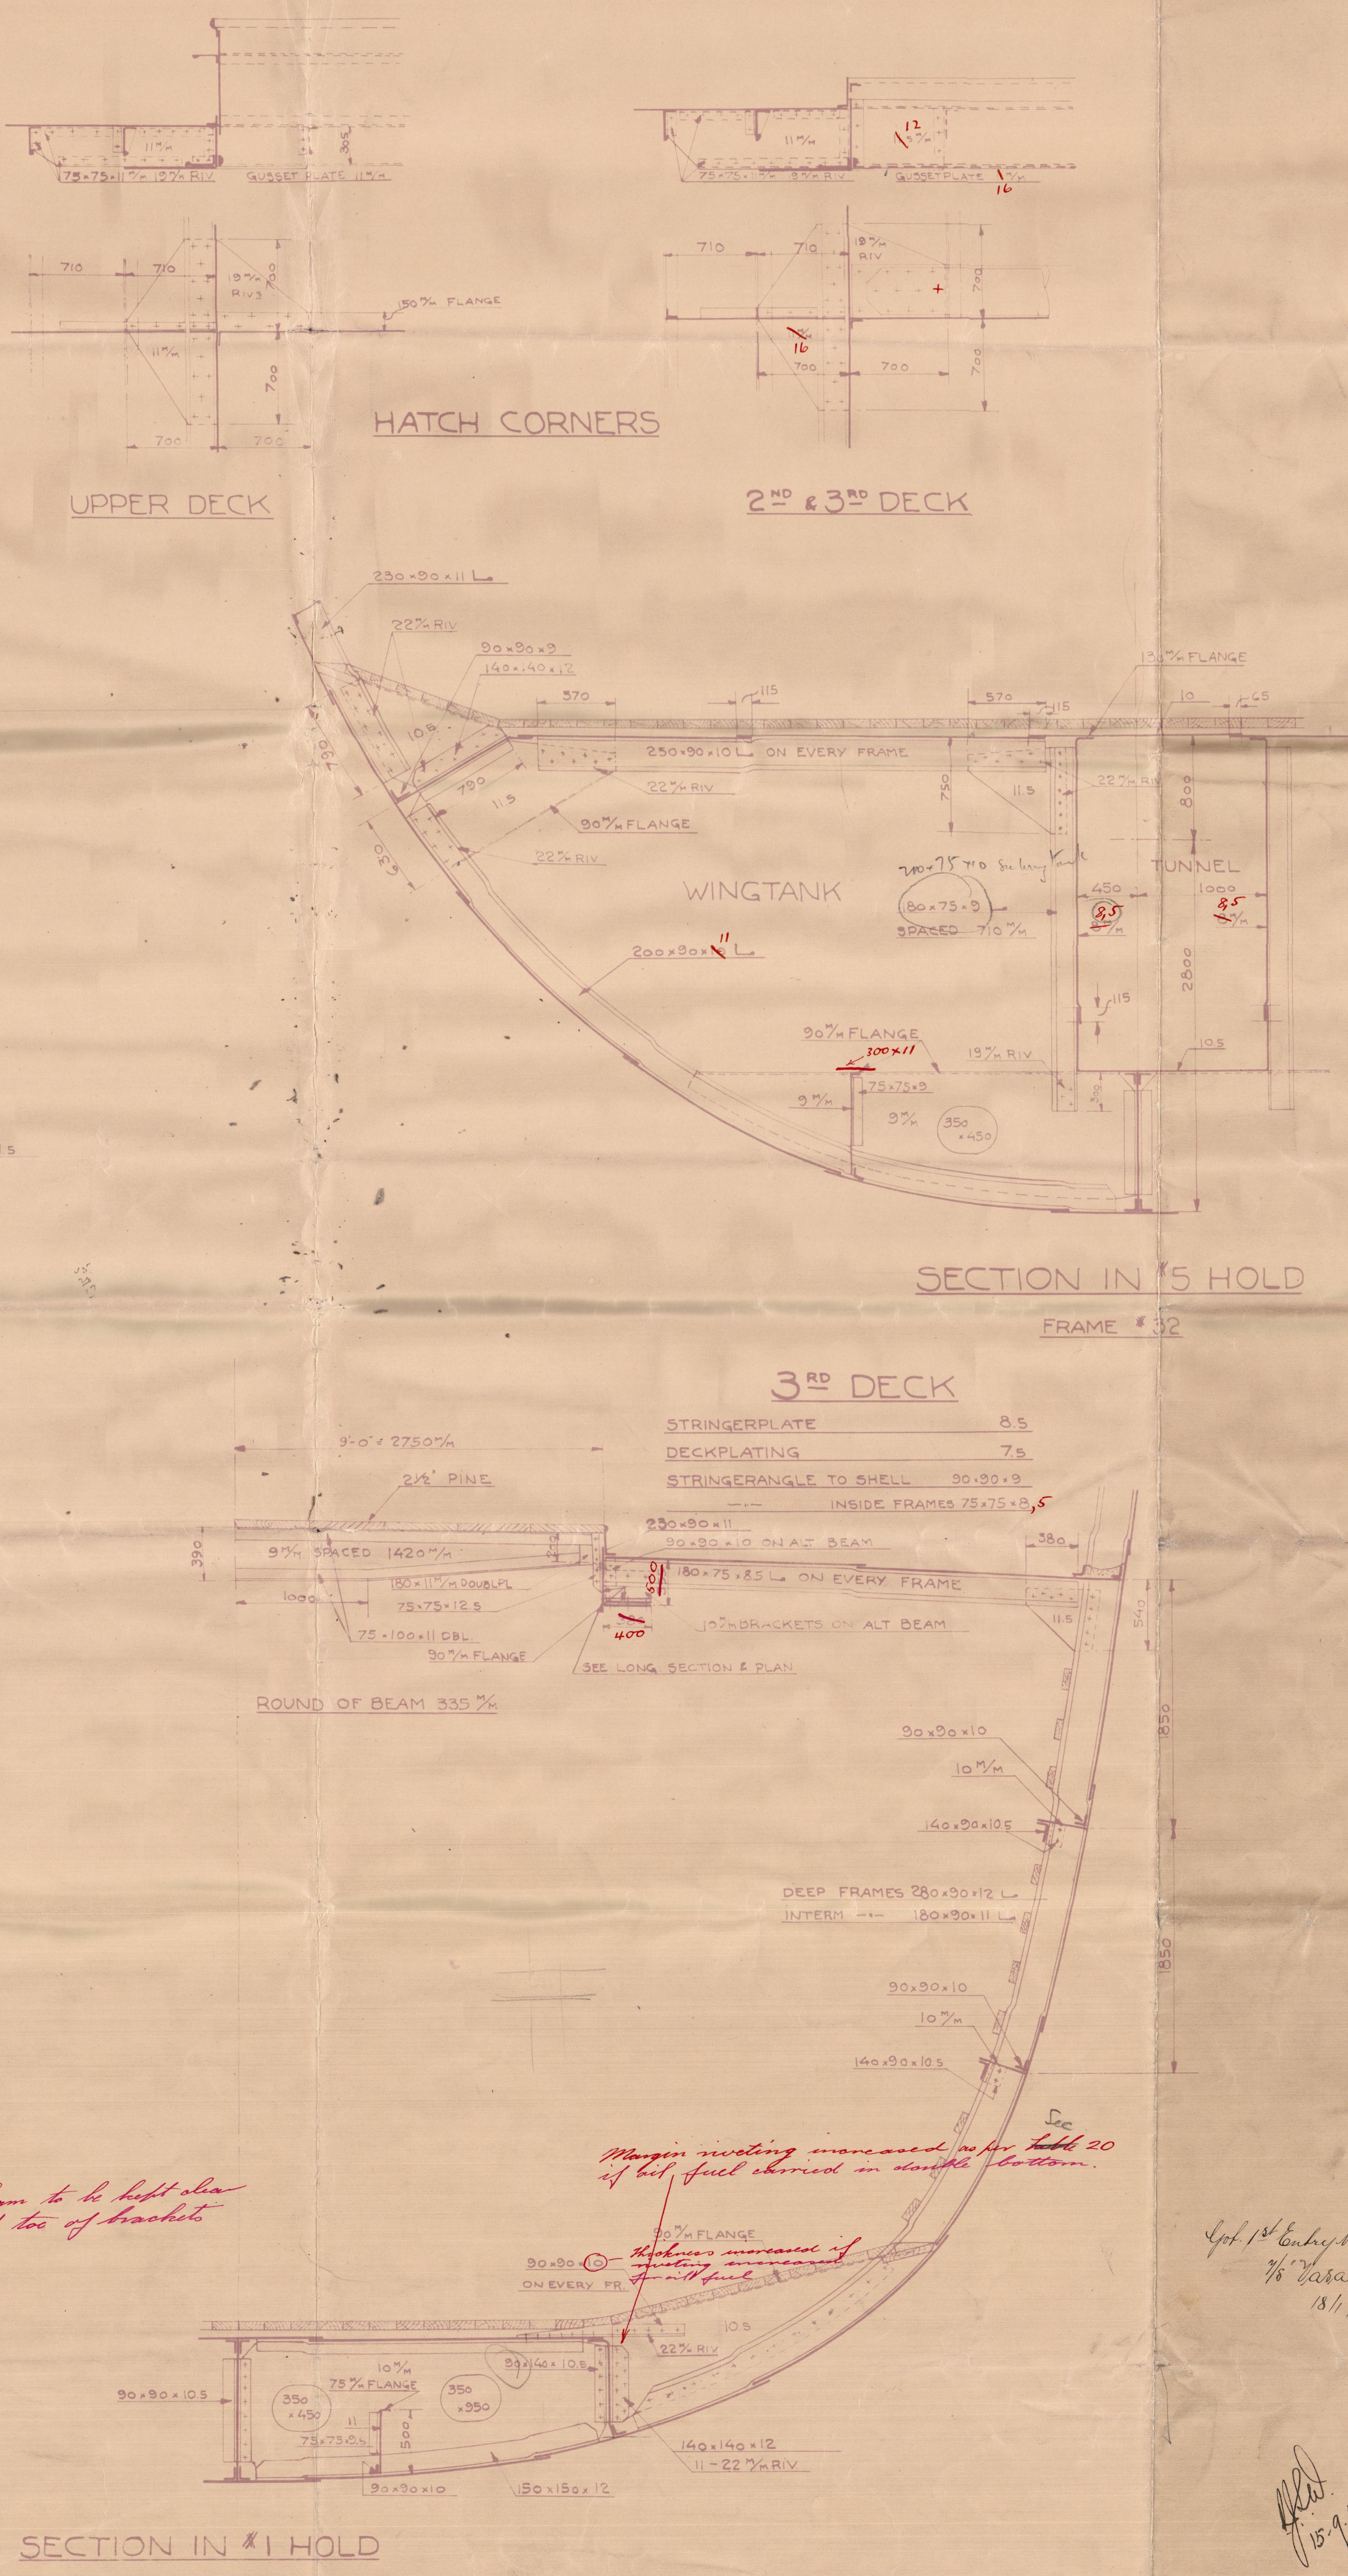

Reinforcing to Surgeon's satisfaction

### HATCH END BEAMS

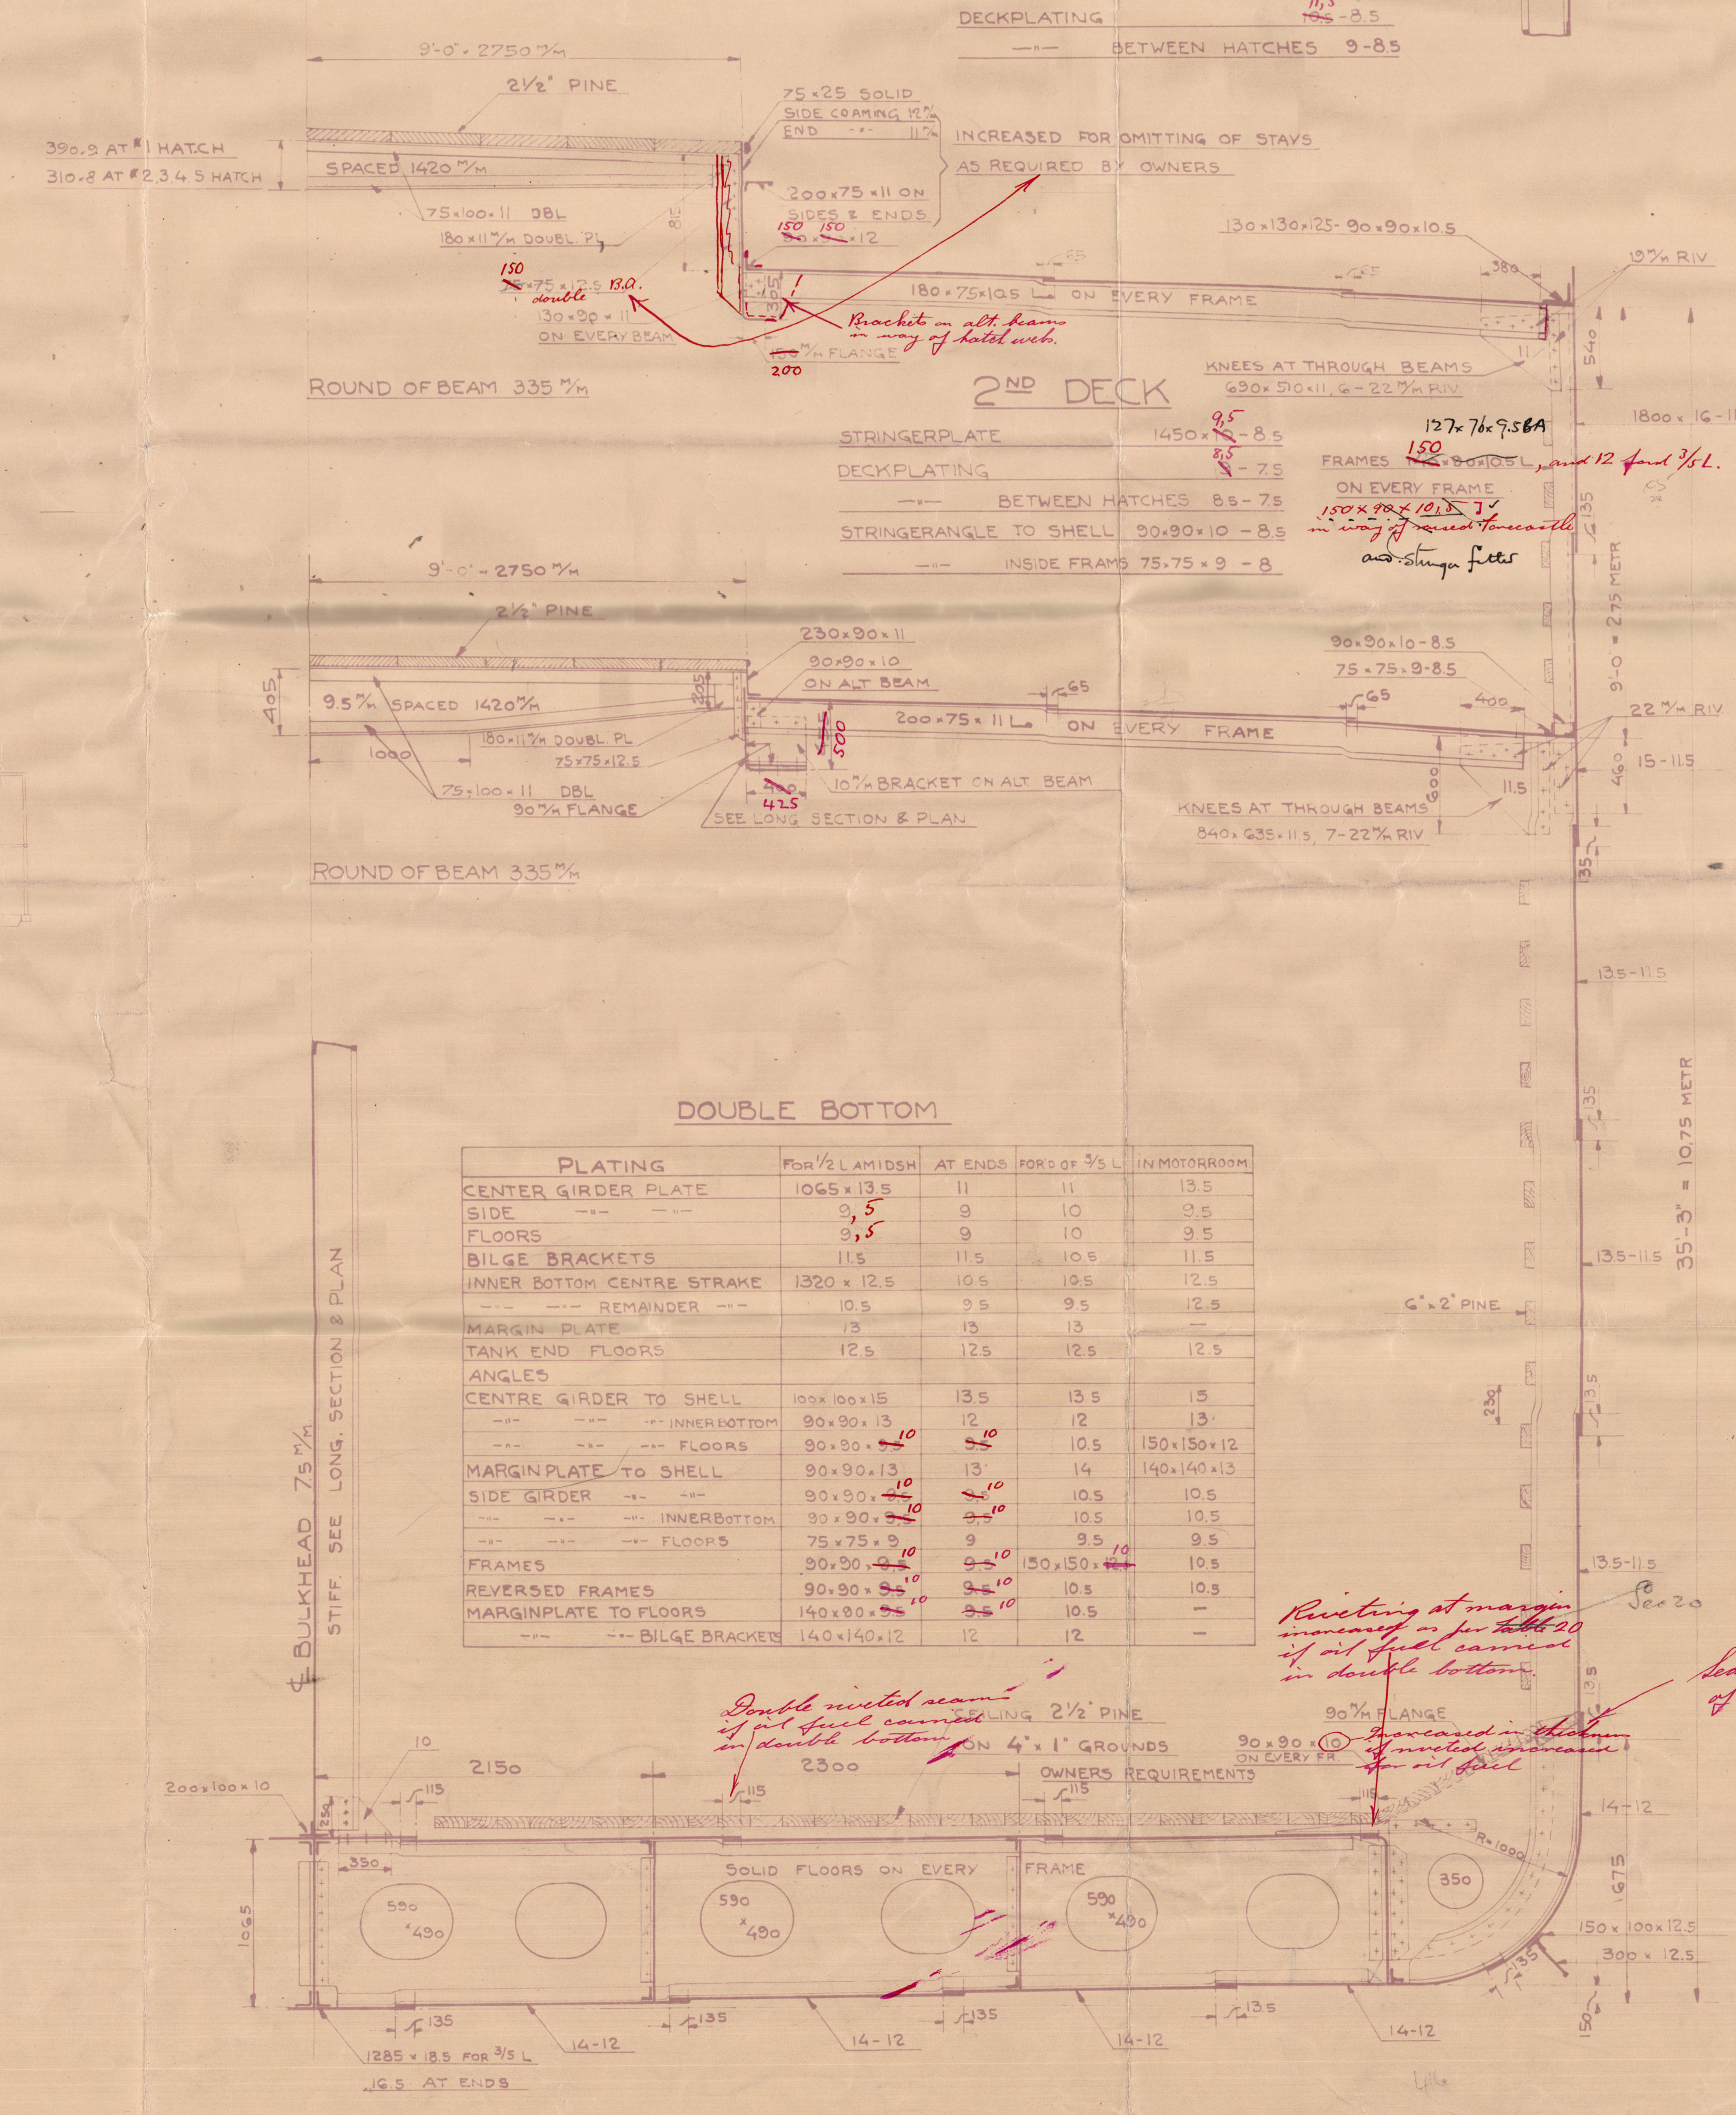

EQUIPMENT 'Y'

	2 BOWER ANCHORS (STOCKLESS) A	3050 kg
1	STREAM	INCL STOCK 1876
495	MTR 2 1/2" (55.87m) STEEL CHAIN CABLE	
165	4 1/4" (121m) STEEL WIRE	
220	4 1/4" (121m)	
2AIG5	2 1/4" (70m)	
2AIG5	7" (178m) MANILLA	

ALL BOLTBANGLES NBSBA 1924 OR NEW GERMAN STANDARDS 1927

## DIMENSIONS

LENGTH PP	390'0" - 118.87m
BREADTH MOULDED	52'6" - 16.00m
DEPTH	TO SHEER DECK 35'3" - 10.75m
	TO MAIN 26'3" - 8.00m
D	= 34'-3" = 10.44 METR.
L/D	= 13358 FEET x 1241
L(B/D)	= 33833 ... 3143
EN: L(B/D)	= 34223
DECKHOUSE	25.5 x 7.5 x 0.5 = 93
CLASS LLOYDS	53.75 x 7.75 x 0.5 = 208
FOR A DRAUGHT	29.5 x 7.5 x 0.5 = 111
FORECASTLE	35.5 x 0.75 x 7.6

1/2" = 11.02  
4" = 22.31 - 5.69  
CLASS LLOYDS 100 AL WITH FREEBOARD  
FOR A DRAUGHT CORRESPONDING TO A COMPLETE SUPERSTRUCTURE VESSEL HAVING A TONNAGE OPENING STRENGTHENED FOR NAVIGATION IN ICE

1/5 426  
MIDSHIP - SECTION

1/25  
5.08