

General Arrangement


Texaco, 171/2

Rpt No - 124k 37381

NOTE: PRICE MARKS ON RUBBER STAMP TO
BILL OF MATERIAL ON DTH-13

REFERENCE PLANS

- MASSING SECTION & TOWERS - H-5
- BULKHEADS - H-6
- STEEL FRAMES & RIGGING - H-7
- SHELL EXPANSION - H-8
- HATCHES, COMPARTMENTS - H-9
- DECK HOUSE - H-10
- BOW & STERN - H-11
- BOILER JACKETING - H-12
- SCUPPERS - H-13
- HAWSE PIPES - H-14
- RIGGING DETAILS - H-15
- DAINT DETAILS - H-16
- LADDERS - H-17
- WHICH & WINDLASS - H-18
- STEERING GEAR - H-19
- FOUND IN BOILER - H-20
- GENERAL ARRANGEMENT - H-21
- WHEEL HOUSE - H-22
- FOOT & PLANS - H-23

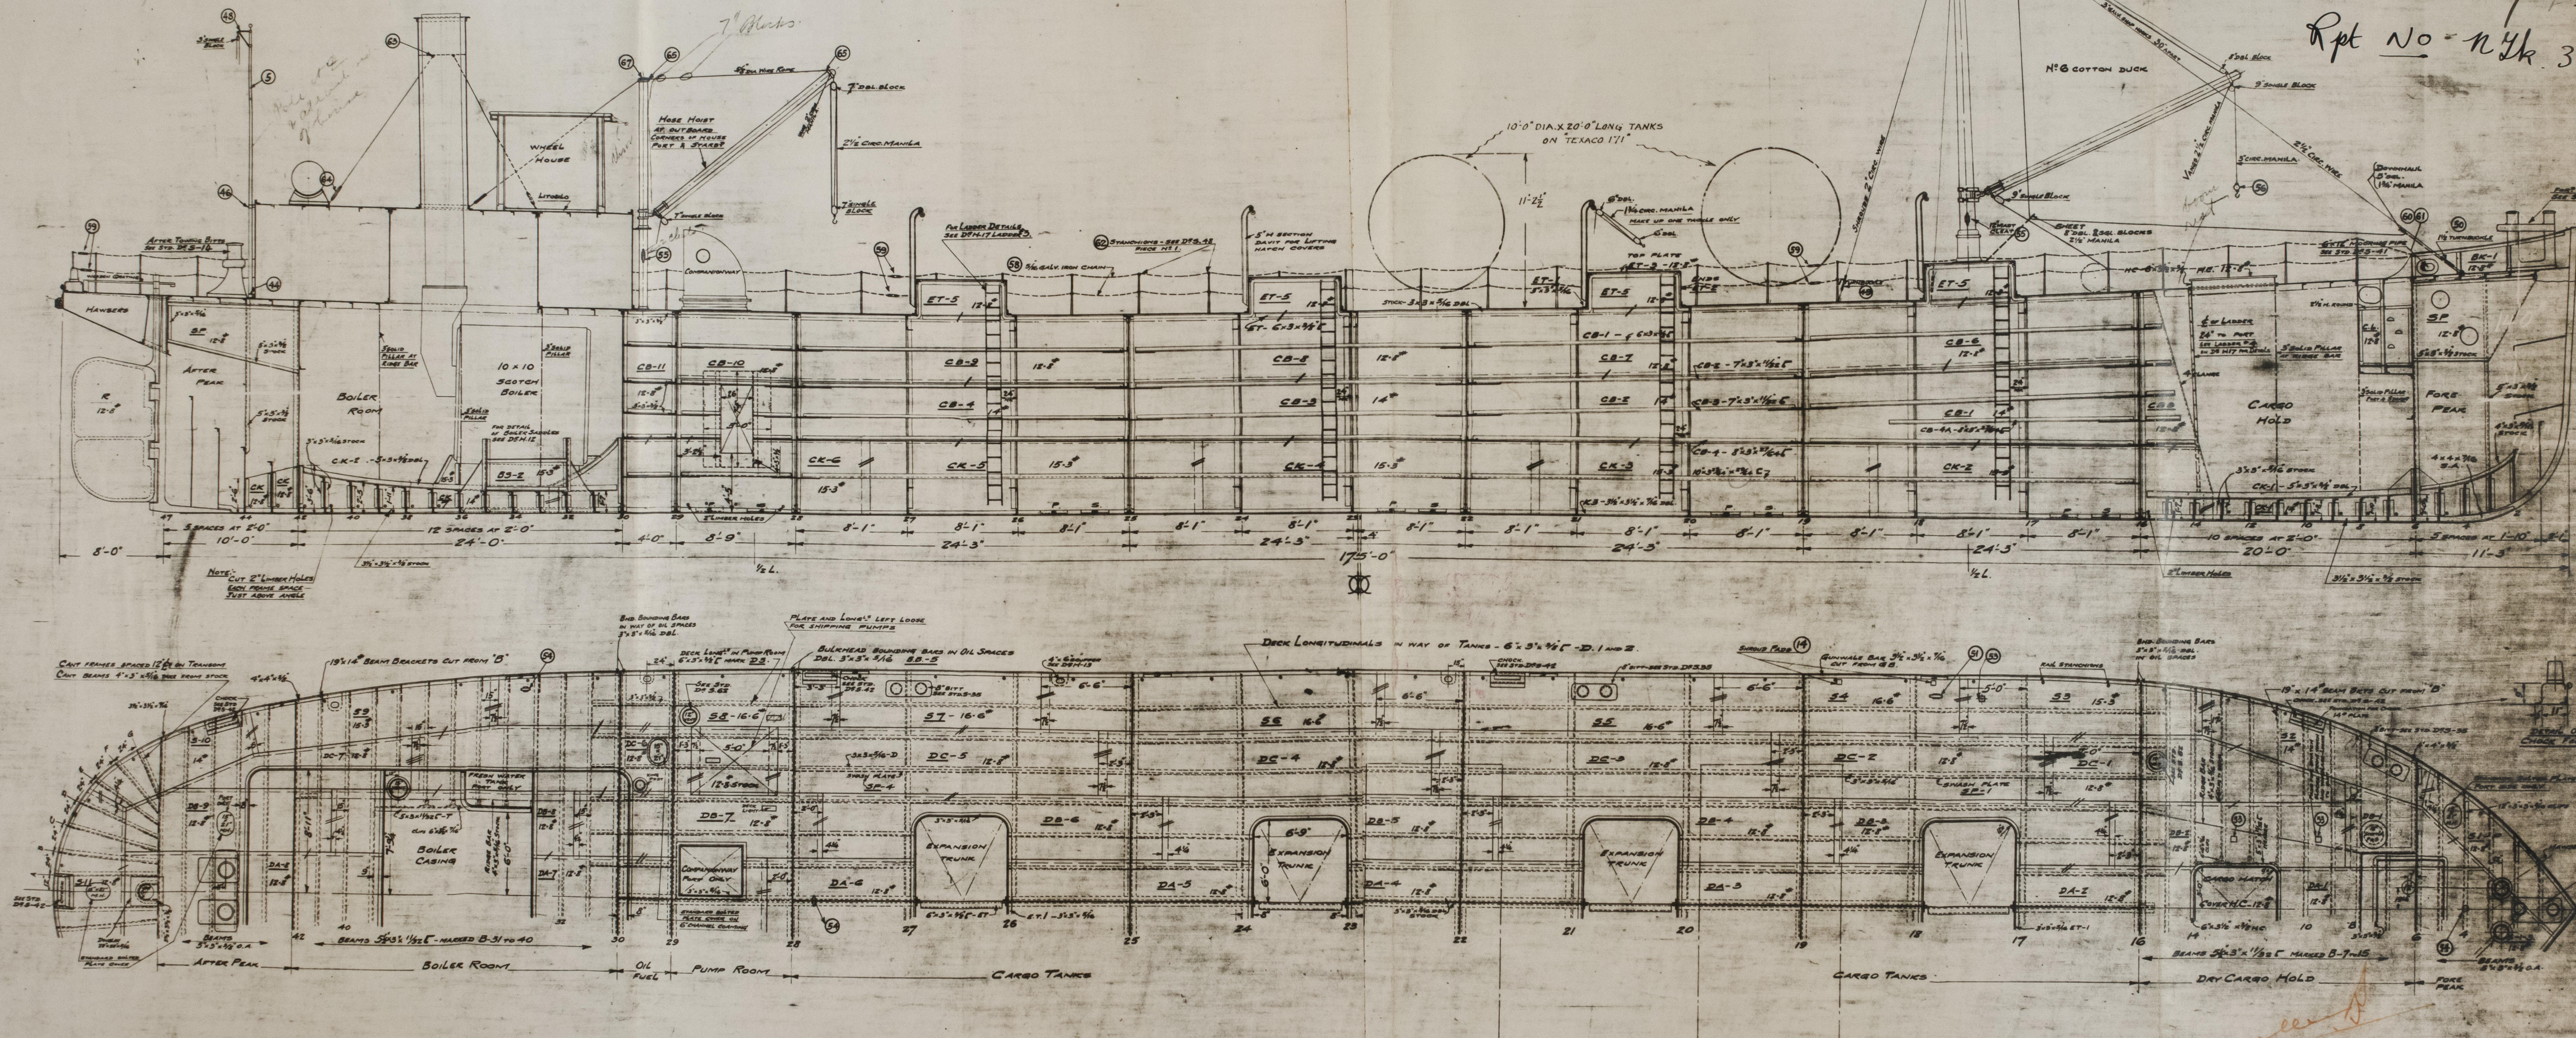

APPROVED
JAN 8 1937
LLOYD'S REGISTER OF SHIPPING
NEW YORK

THE TEXAS STEAMSHIP
CORPORATION
BOSTON, MAINE
HULLS 33-34-35
General Arrangement
Scale 1/4" = 1'-0"

REVISED 12/9/20

00137-00943-0197