

M/S. "JACO"


Forstærkning ved Sideporte  
 Ølemme i Dæk paa Overbygning  
 Midtstubs.

Skala: 1:25.


16.11.48.

Snit i Lemme.


Top af Hus

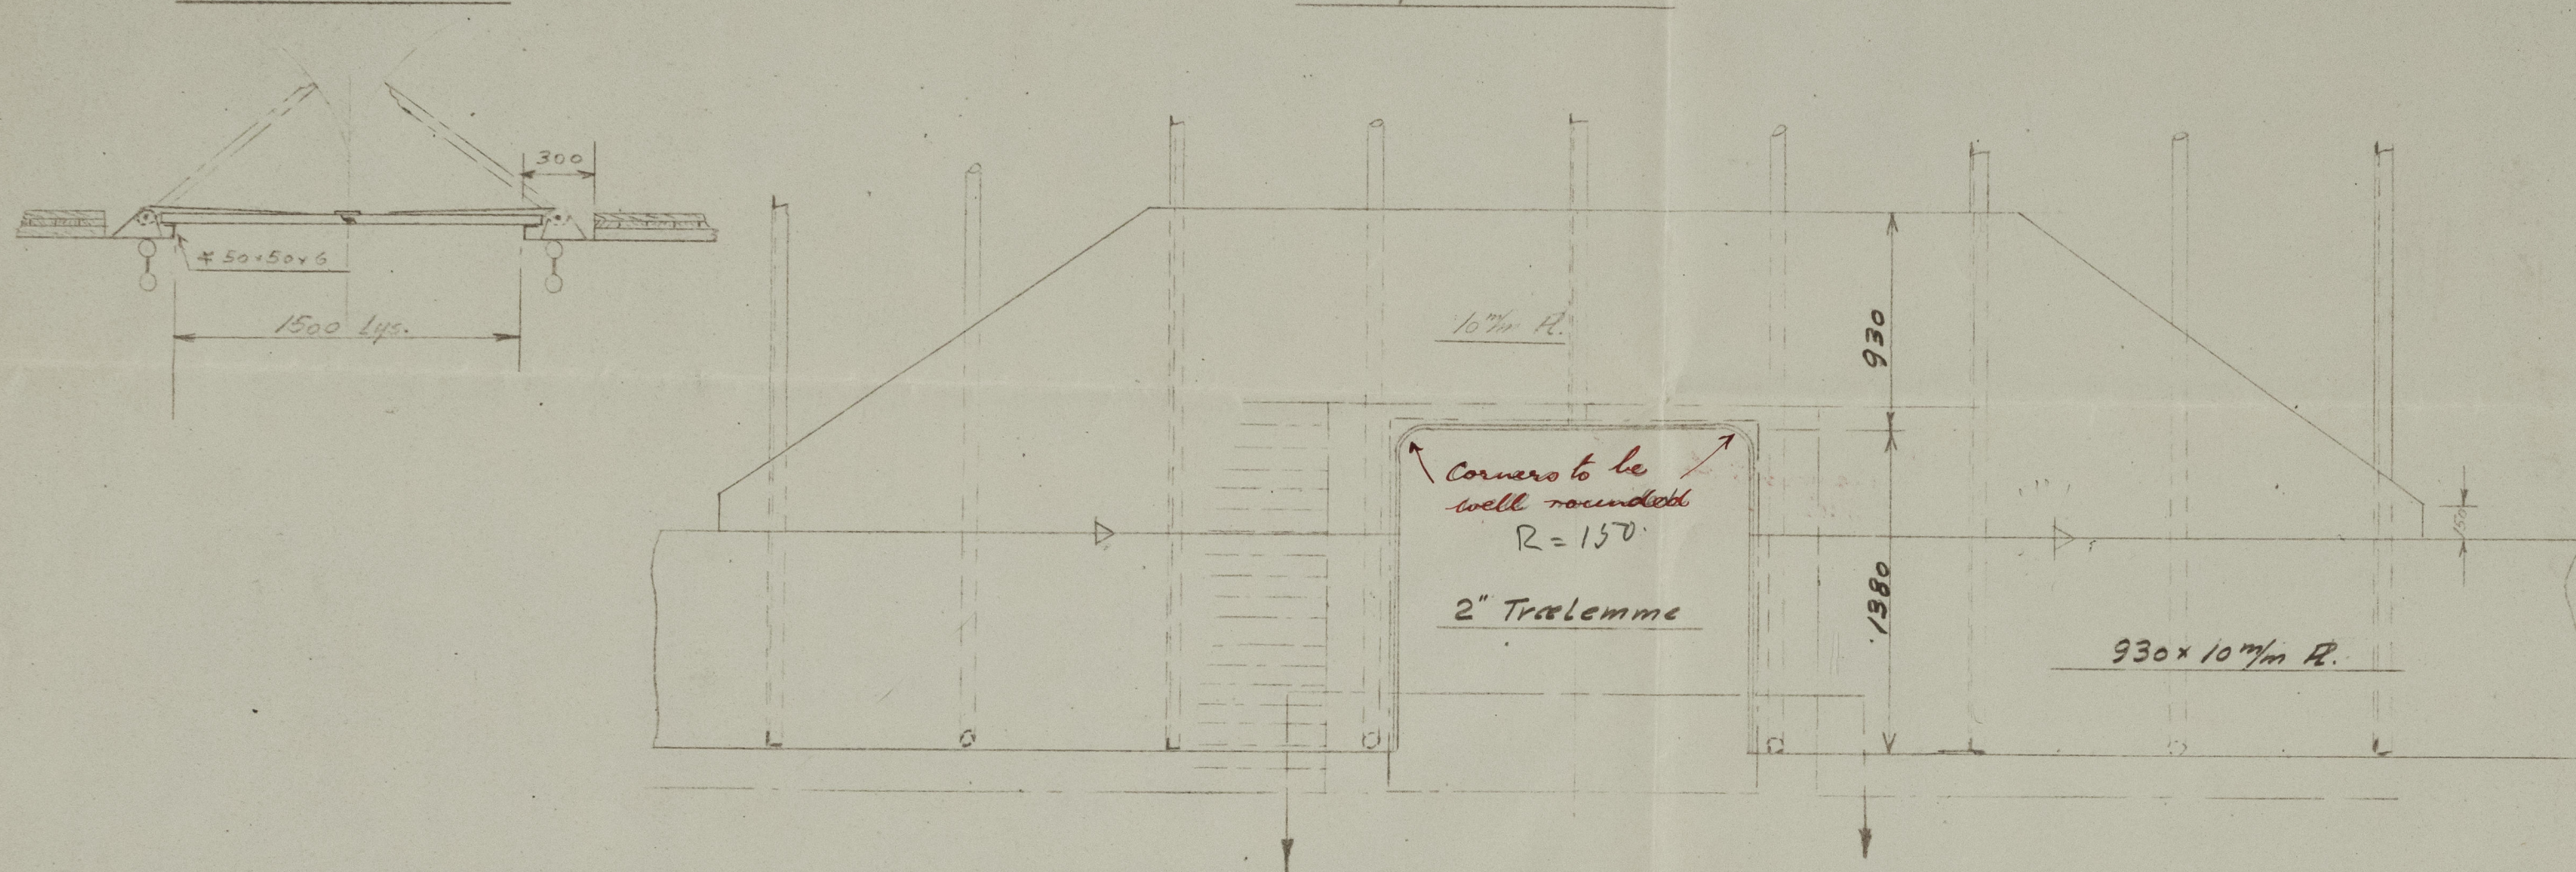


S.b. Side af Hus

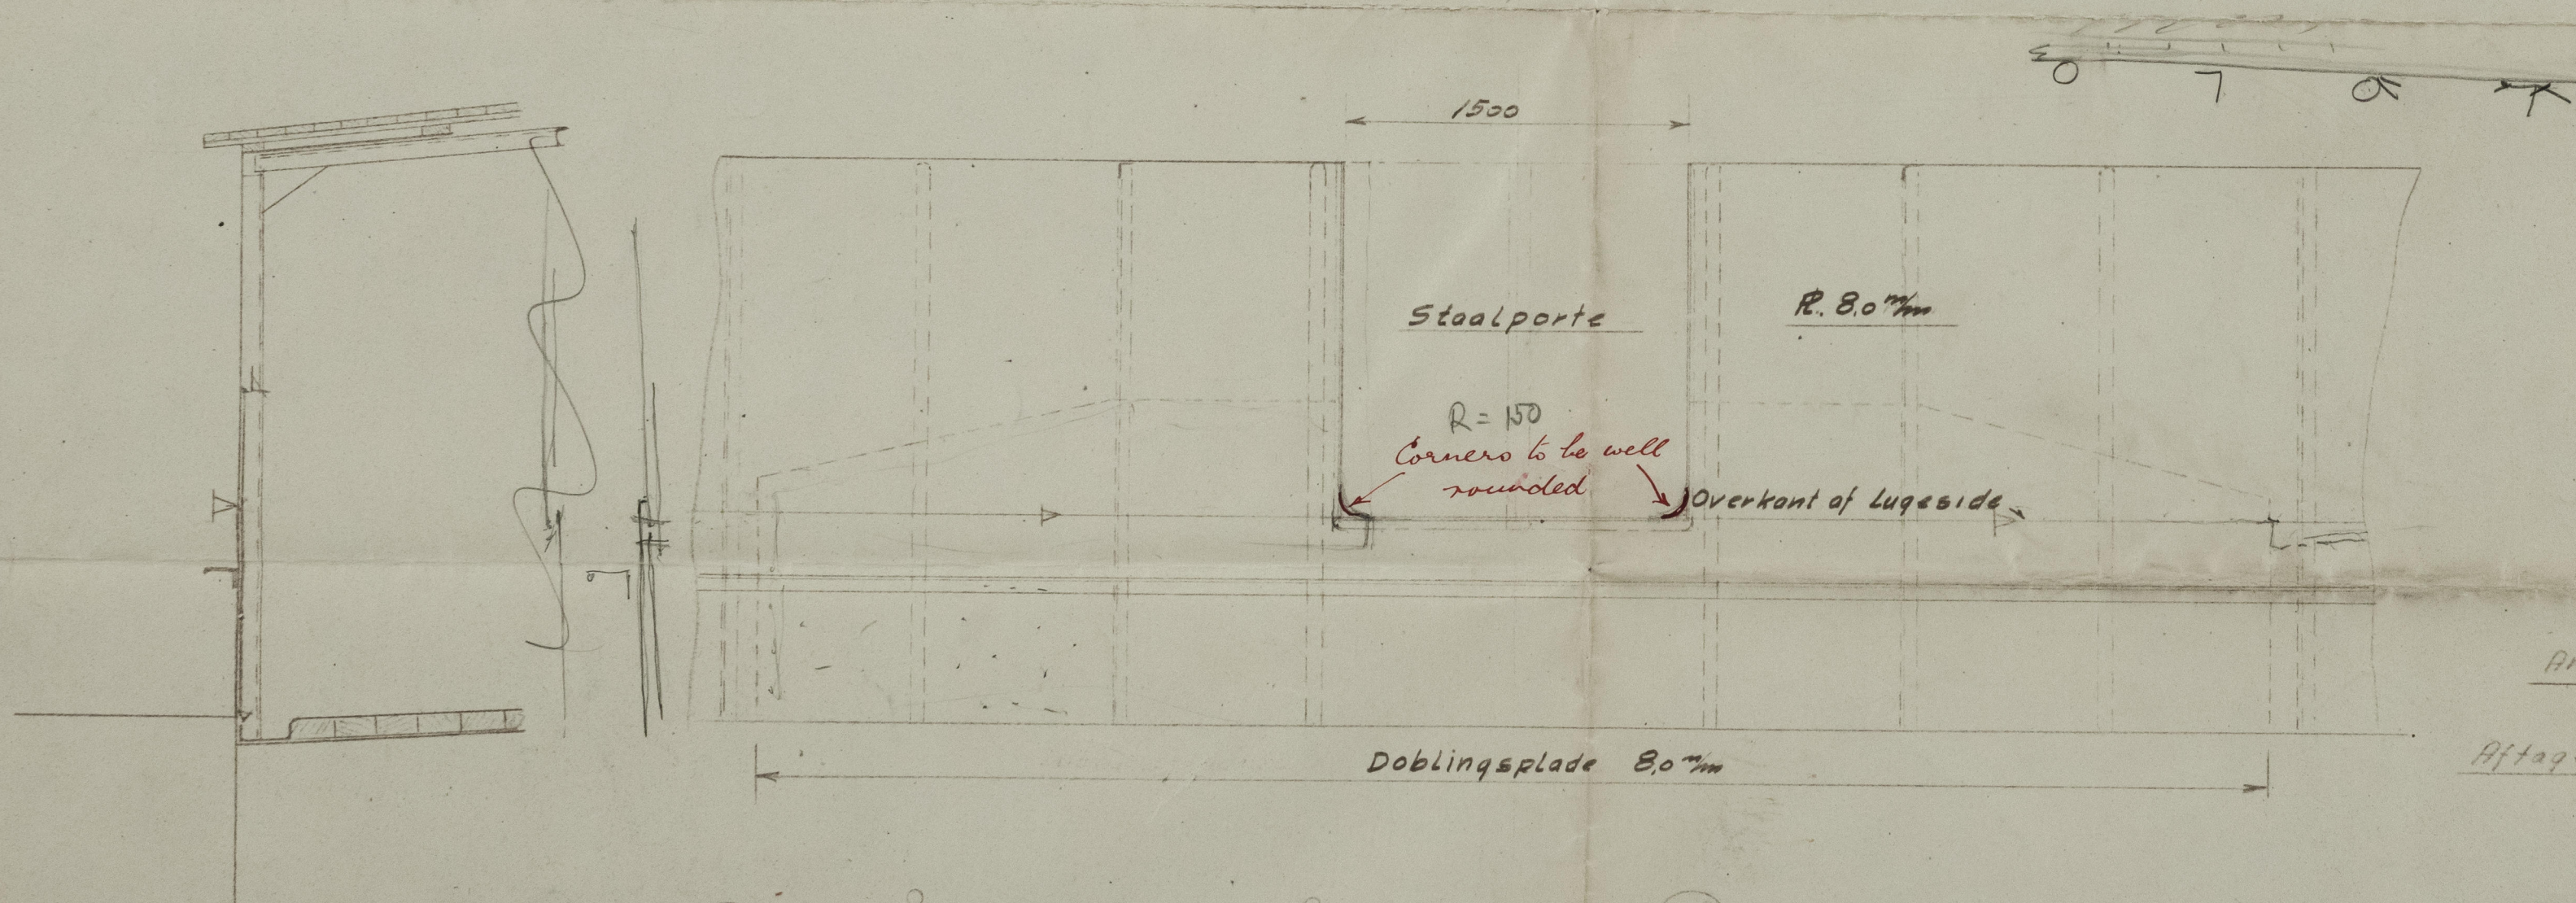

Snit i Port.

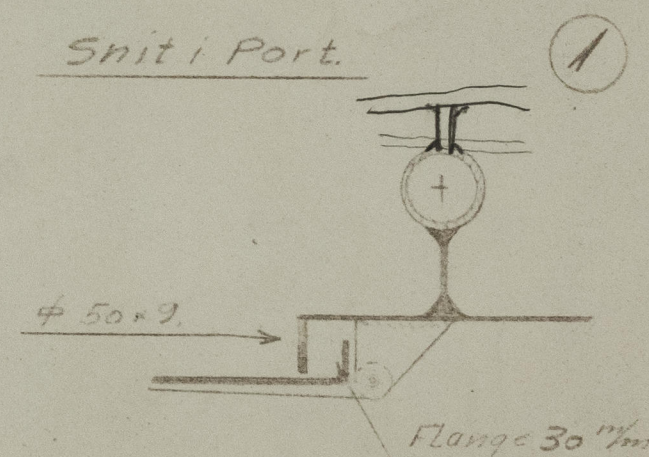

Anslag for Port.

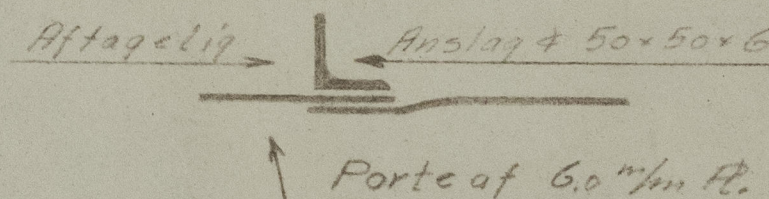

16.11.48

M/S. "JACO"

TO ACCOMPANY *Cpw.* REPORT No. 12670  
 DATED *Feb 1949*

28 SEP. 1948

KNUDE E. HANSEN

Ingeniør cand. polyt. M. Ing. K.  
 Rosenvangsgade Allé 22 - København Ø.  
 C. 6442, Tlf. 1645, Telegr. Adr. DESIGN

K. E. H. 4843-1

008158-008167-0038



"JACO"

RPT. No. Cpn. 12 670.



© 2021

Lloyd's Register  
Foundation

008158-008167-0038