
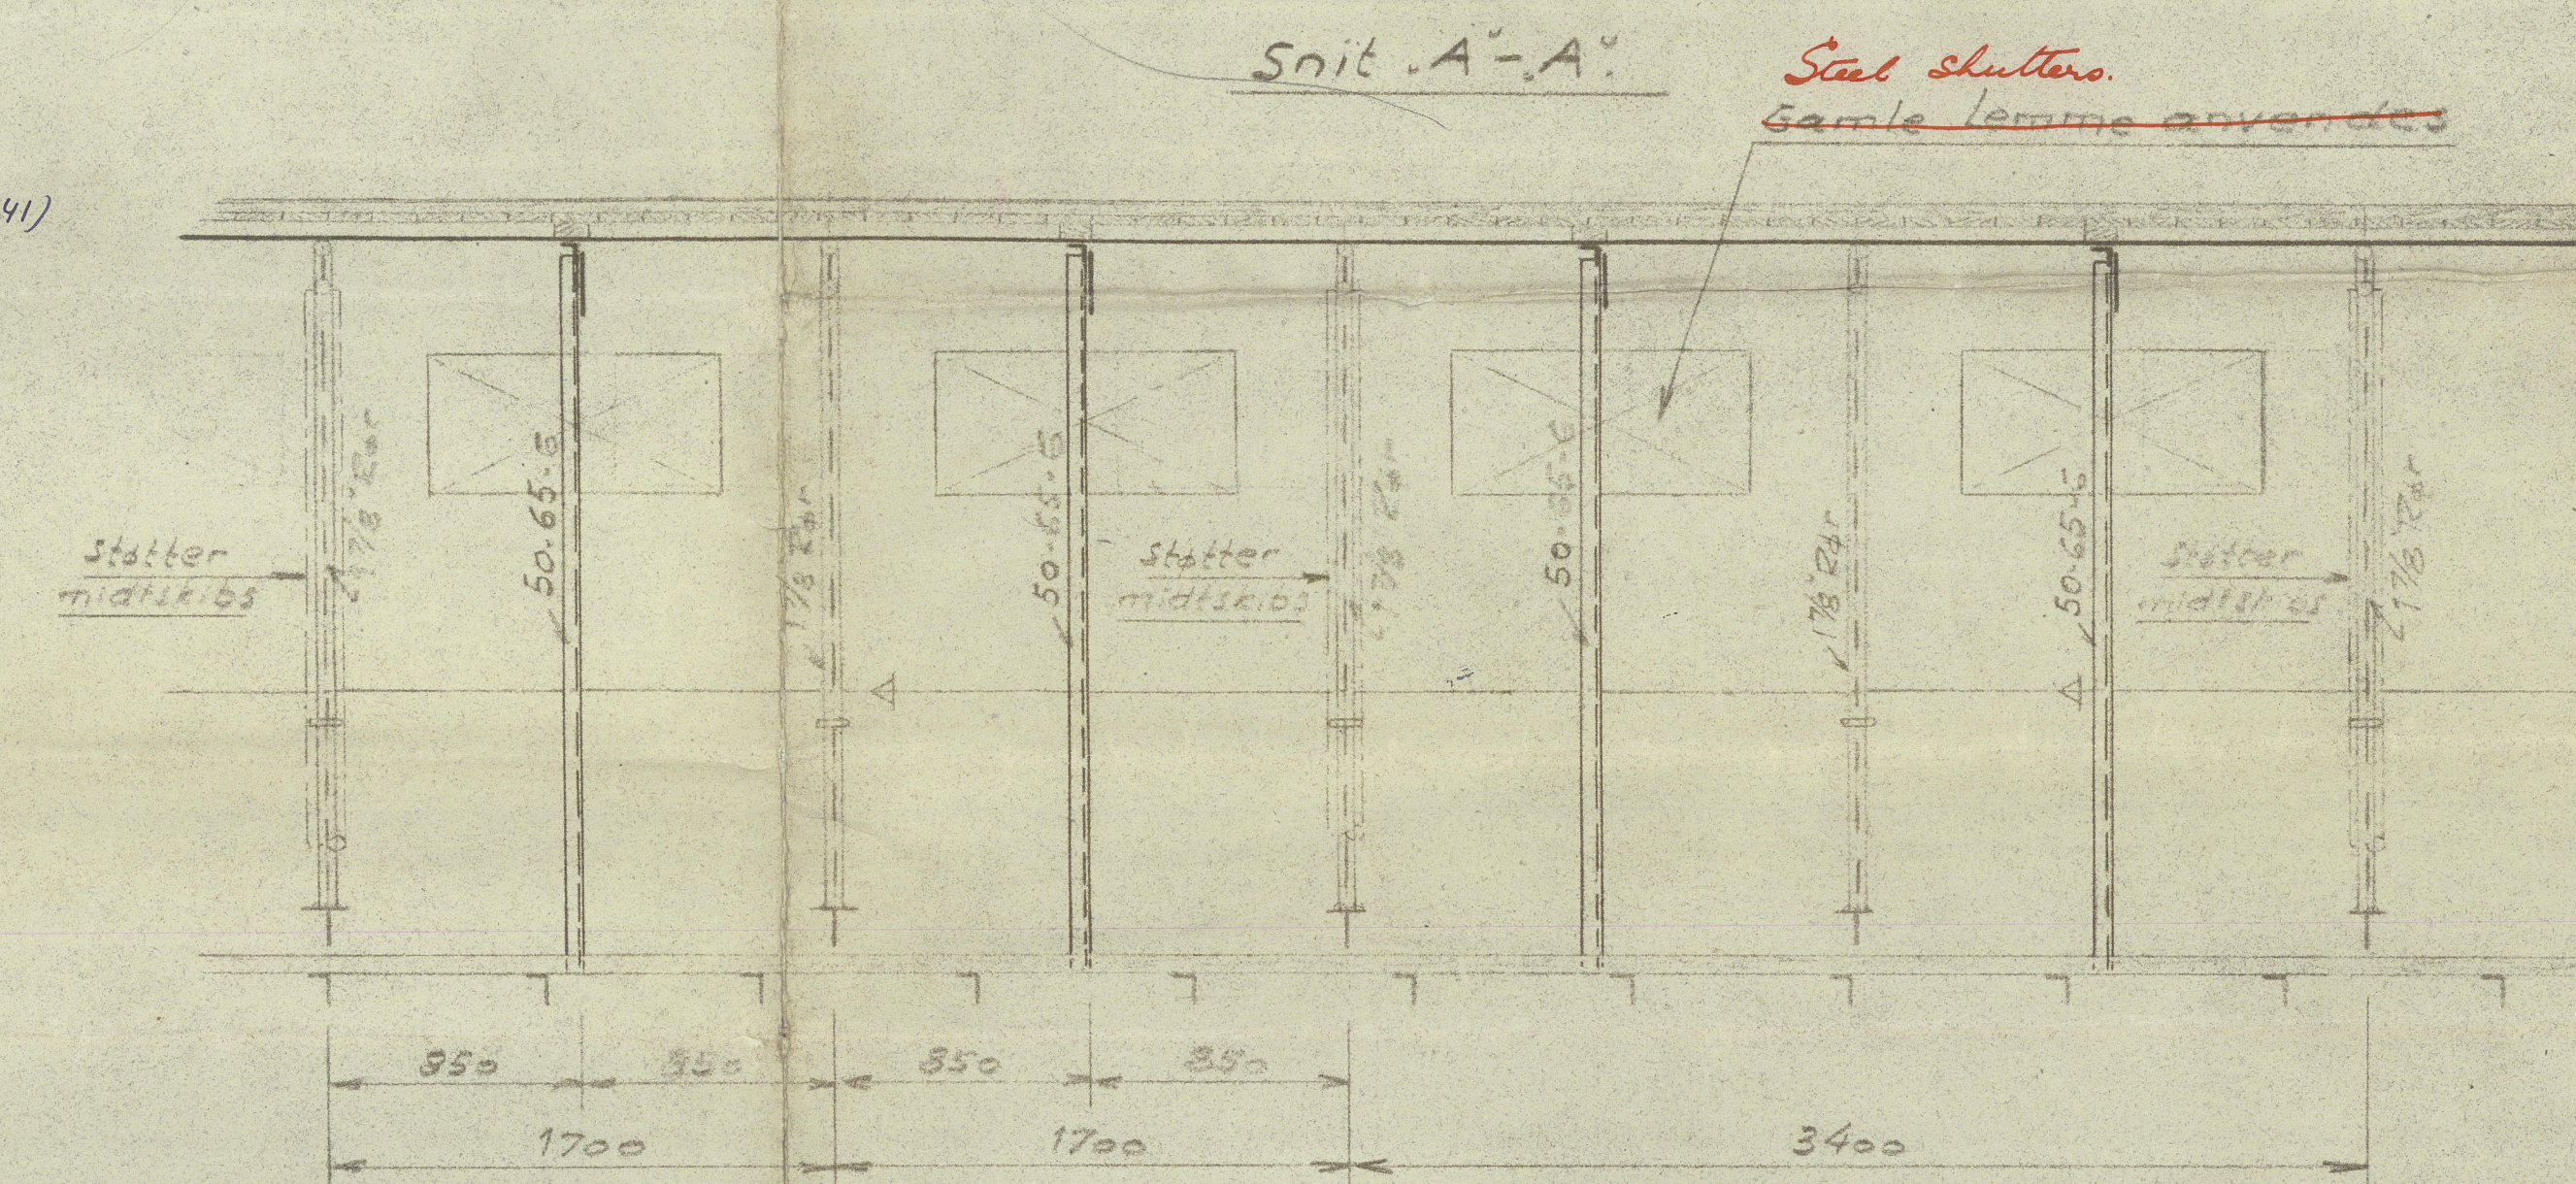


L.C.T. 8.4027—M/s Jacobs.  
Forandring af Midtskibets Opbygning.  
Skala 1:25 & 1:5

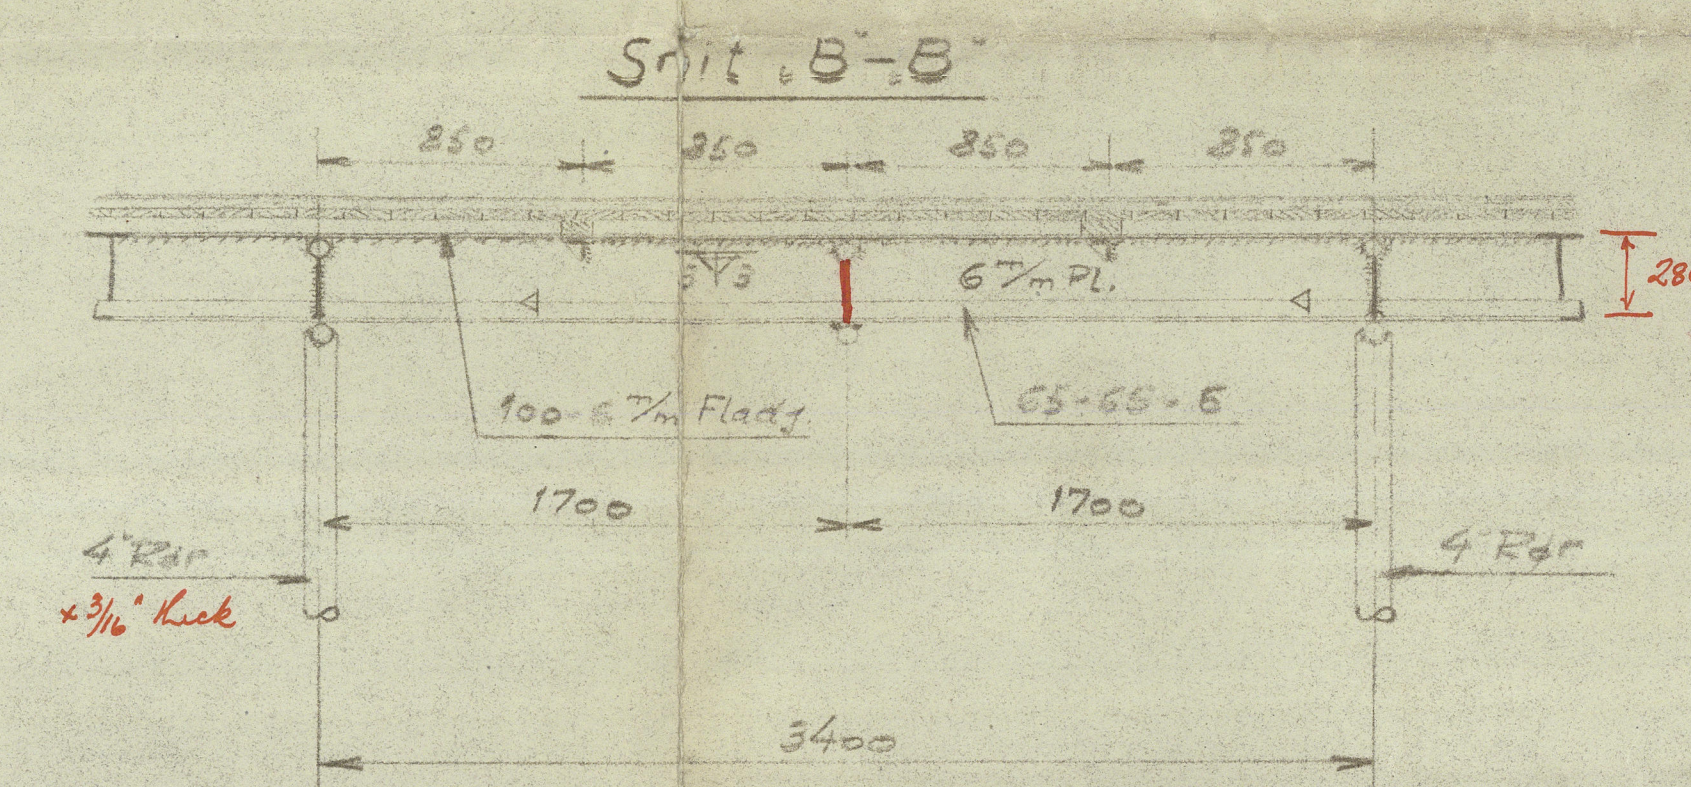

**KNUD E. HANSEN**  
Ingeniør cand. polyt. M. Ing. F.  
Rosenvængets Allé 22 - København Ø.  
C. 6442, Tria 1645, Telegr. Adr. DESIGN

27 AUG

© 2021  
Lloyd's Register  
Foundation

008158-008167-0039



"JACO"

RPT. NO. Cpn. 12.670



© 2021

Lloyd's Register  
Foundation

009158-008167-0039