


M/S "Jaco" [L.C.T. 8-4027.] 23.2.48

Strengthening for ~~European~~ Navigation

Scale 1:250 & 1:100


For limits of service
See letter dated 23/2/48.

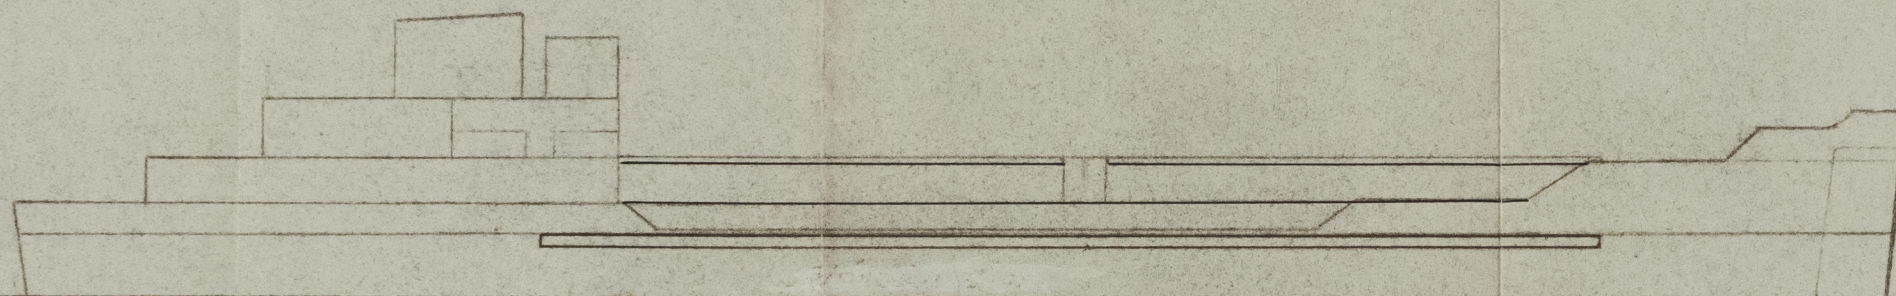

M.S. "JACO"

TO ACCOMPANY *Copenhagen* REPORT No. 12670

DATED *February 1949*

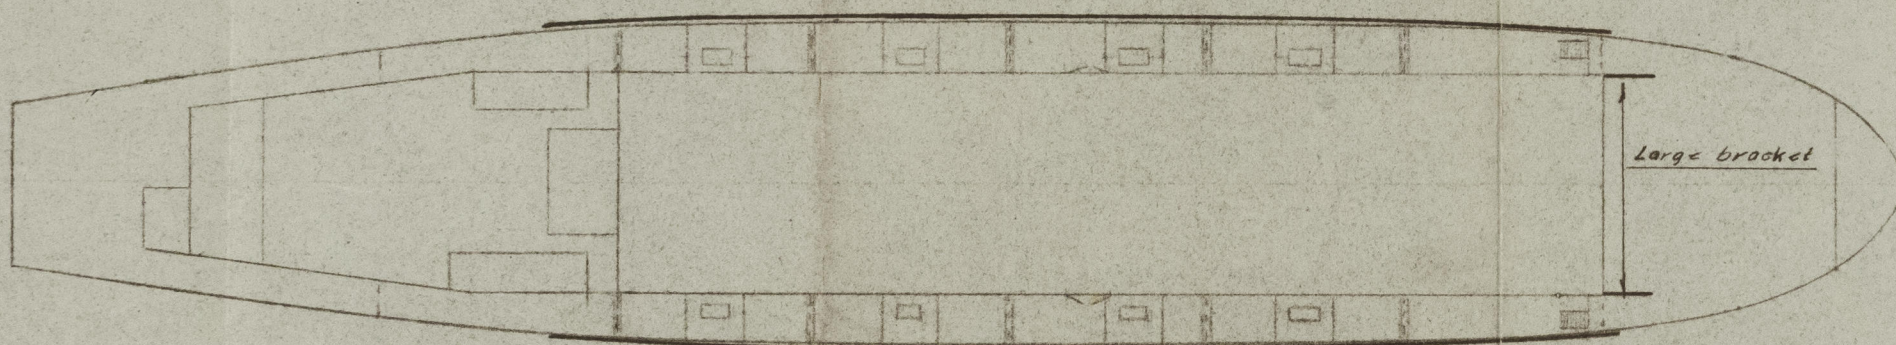

[Signature]
23.2.48

Stringer-plate $3\frac{1}{2} \times 40$

.32

Strengthening 12×60

KNUD E. HANSEN

Ingeniør cand. polyt. M. Ing. F.

Rosenvangs Allé 22 - København Ø.

C. 6442, Tria 1645, Telegr. Adr. DESIGN.

30 DEC. 1947



© 2021

Lloyd's Register
Foundation

"JACO"

RPT. No. Cpn. 12670

REPORT NO.	TO ACCOMPANY
	DATED



© 2021

Lloyd's Register
Foundation