

# Lloyd's Register of Shipping.

SURVEYS FOR FREEBOARD.—STEAM SHIPS.

Particulars relating to ~~all~~ STEAM SHIPS EITHER FLUSH DECKED, OR WITH  
GALLANT FORECASTLES, SHORT POOPS AND BRIDGE HOUSES DISCONNECTED, OR  
TOP GALLANT FORECASTLES HAVING LONG POOPS, OR RAISED QUARTER DECKS  
CONNECTED WITH BRIDGE HOUSES, OR OTHERWISE.

Index No. (For London Office only.)

33689

8 AUG 1930

HULL

10099

Port of Survey

Date of Survey 6th August 1930

Name of Surveyor J. B. Leyland

Ship's Name.	Port of Registry and Nationality.	Official Number.	Gross Tonnage.	Date of Build.	Particulars of Classification.
LIMPOPO S.B.C. No 678 SHIP.	LOURENCO MARQUES PORTUGUESE.	✓	✓	1930.	Plan contemplated

Length.	Breadth.	Depth.	Under Deck Tonnage.
190.2'	30.2'	9.7'	370.62.
190.0	Frame Depth 4' Rule " 3½' x 2 - .08	Ceiling fitted Sheer +.38 7¾ Drop in Tank Spars fitted +.32	Peak } INCLINED Tanks
190.0	30.12	10.40	370.62

Moulded Depth as measured..... 11.6"

NOTE.—If the depth is measured when vessel is afloat, the details of measurement should be reported.

11-6  
7½

12.11½  
2 5/16  
9.8 1/16

Addition for Keel below base line for draught record..... inches.

## CORRECTION FOR LENGTH.

Length of Ship on Loadline..... 190.0

138.0

Length in Table ..... 32.0

Difference ..... 9

Correction for 10ft., Table A. .... 2.88 Table C.

x Difference divided by 10 ..... 1.444 (if required.)

If  $\frac{1}{16}$ ths length covered divide by 2 + 1½

634 x 3 = 1.90 CORRECTION FOR IRON DECK.

366 x 2½ = .91 2.88

Proportion covered, if less than  $\frac{1}{16}$ ths length covered ..... 634

Thickness of usual wood deck, less stringer ..... 3"

2½' Sheathing fitted mean effective thickness 2 3/4" - 1/16"

25 x 634 = 17

CORRECTION FOR ROUND OF BEAM.

Breadth at Gunwale amidships..... 30.0

Round of Beam ..... 7½"

Normal round ..... 4½"

Difference ..... - ÷ 2 = .....

Proportion of Deck uncovered (Para. 19) ..... NIL

NOTE.—The round of beam should be reported on the full breadth of vessel at the gunwale.

Freeboard, Table A .....

1" 4½"

Correction for Sheer .....

- 3½" /

Correction for Length .....

1" 4" /

Allowance for Deck Erections .....

+ 1½" /

Correction for Round of Beam .....

1" 5½" /

Correction for fall in Sheer (if any) .....

- 5½" /

Correction for Steel Deck (if required) .....

0 - 11½" /

Additions for non-compliance with provisions of

Para. 11 (d) and (e) + Crew facilities in well not provided. + 1" /

Other Corrections (if any) For no sheathing in way of marking - 2 3/4" /

0 " 9 3/4" /

Winter Freeboard .....

0" 9 3/4" /

Summer Freeboard .....

0 - 8" /

Indian Summer Freeboard .....

0" 6 1/4" /

N. A. Winter Freeboard .....

0" 11 3/4" /

Correction necessary because clearside amidships, measured

in accordance with the Statute is not taken at the intersection of the ~~wood~~ steel deck with side.

+ 1½" /

Winter Freeboard from deck line .....

0" 11" /

Summer " " " .....

0" 9 1/4" /

Indian Summer " " " .....

0" 4 1/2" /

N. A. Winter " " " .....

1" 1" /































Do all the Frames extend to the top height in the Poop? YES ✓ Raised Quarter Deck? ✓ Bridge House? YES ✓ Forecastle? YES  
 To what height do the Reverse Frames extend? ✓  
 Has the Poop or Raised Quarter Deck an efficient Iron Bulkhead at the fore end? YES  
 Give particulars of the means for closing the openings in Bulkhead 2 HINGED STEEL DOORS 5'0" x 2'0"  
 Is the Poop or Raised Quarter Deck connected with the Bridge House? YES - Has the Bridge House an efficient Bulkhead at the fore end?  
 Give particulars of the means for closing the openings in Bulkhead 2 STEEL HINGED DOORS 5'0" x 2'0" SECURED BY BUTTERFLY NUTS - (AS PER SKETCH ENCLOSED WITH THIS REPORT) 4 PORTS LID.  
 What is the thickness of the Bridge Front plating? .30 - and Coaming plate? .42 -  
 Give scantlings and spacing of the Stiffeners 6 1/2" x 3" x .34 BULB ANGLES SPACED 30" APART.  
 Are bracket plates fitted at each end of the Stiffeners? LUGS WITH 4 NUTS Are hor'l. brackets fitted connecting Bridge Bulk'd. with Bulwarks? YES  
 Has the Bridge House an efficient Iron Bulkhead at the after end? COVERED BY BRIDGE DECK. YES  
 How are the openings closed? NO openings  
 Is the Forecastle at least as high as the main or top-gallant rail? YES - Has the Forecastle an efficient Iron or Wood Bulk'd. at after end? YES  
 Are the Engine and Boiler openings covered by a Bridge, Poop, Raised Quarter Deck, or enclosed by a Strong Iron or Steel Deckhouse? YES by Bridge  
 If the openings are not so protected are the exposed parts of the Casings efficiently constructed?  
 Give thickness of plating; scantlings and spacing of Stiffeners ENGINE CASING 2'9" ABOVE BOILER 7'6" BRIDGE DECK.  
 What is the height of the exposed Casings? Are suitable means provided for closing all openings in them in bad weather? HINGED  
 Are the Weather Deck Hatchways efficiently constructed and at least equal to the requirements of the Rules? Give particulars below: YES.

Position.	No 1 UPPOA DK	No 2 BRIDGE DECK				
Size.	15'6" x 10'0"	12'10" x 10'0"				
COAMING WOOD Height above top of DECK	2'6"	2'6"				
Thickness { Sides.....	.42	.42				
Ends.....	.42	.42				
SHIFTING BEAMS OR WEB PLATES.	Number .....	1	1			
Material .....	STEEL	STEEL				
Number .....	1	1				
Section and Scantlings .....	PLATE 1/2" x 32 4 ANGLES 3x3x40	PLATE 11" x 30 4 ANGLES 3x3x40				
Material .....	STEEL	STEEL				
* FORE AND AFTERS.	Number .....	1	1			
Material .....	8" x 4"	6 1/2" x 7"				
Section and Scantlings .....	PITCH PINE	PITCH PINE				
HATCHES Thickness .....	2 7/8" U.W.	2 7/8" U.W.				
Remarks.....						

\* The depth of Fore and Afters should be stated from the underside of the hatches in all cases.

(If the sill of the lowest side scuttle will be less than 6 inches above the Indian Summer Load Line if assigned under the tables, state vertical distance from top of keel to lower edge of lowest side scuttle.) NO SIDELIGHTS TO EFFECT FREEBOARD.

Enclose up to Date General Arrangement Plan, also sketch of Bridge Front Decks. A Provisional Freeboard is assigned. SEE London Letter M/4/40. This vessel is expected to sail about the 1/4 of next. And we should be pleased to receive the Freeboard assigned as early as possible.

The following information is to be given in all Cases of vessels dealt with under Paras. 11, 12 (under 15 feet Moulded depth) and under Shelter Deck Rule. What is the thickness of the Bridge Sheerstrake? Strake between Main and Bridge Sheerstrakes?

Delete the words { The Crew are, are not, berthed in the bridge house. that do not apply { The arrangements to enable them to get backwards and forwards from their quarters are, are not satisfactory.

Length of Bulwarks in well 33.0 PROVIDED TO ENABLE THE CREW TO GET TO AND FROM THEIR QUARTERS DESCENDING INTO THE WELL. THESE ARE NOT PROPOSED TO BE FITTED.

Area of Freeing Ports required by Para. 11 (e) each side of vessel = Sq. ft.


Ft. Tenths. Ft. Tenths. No. 9.8 Sq. ft.

2.26 x 1.58 x 3.0 10.65 Sq. ft.

x x STEVENS BULB PLATE 8" x 3" 5'6" AREA

STEEL HINGED DOORS 1.05.  
AS PER PLAN APPROVED 30/4/40  
12'5 1/2" x 3'3 1/2"  
STRONGLY BUILT & SECURED.

Total deficiency or excess = .95 Sq. ft.

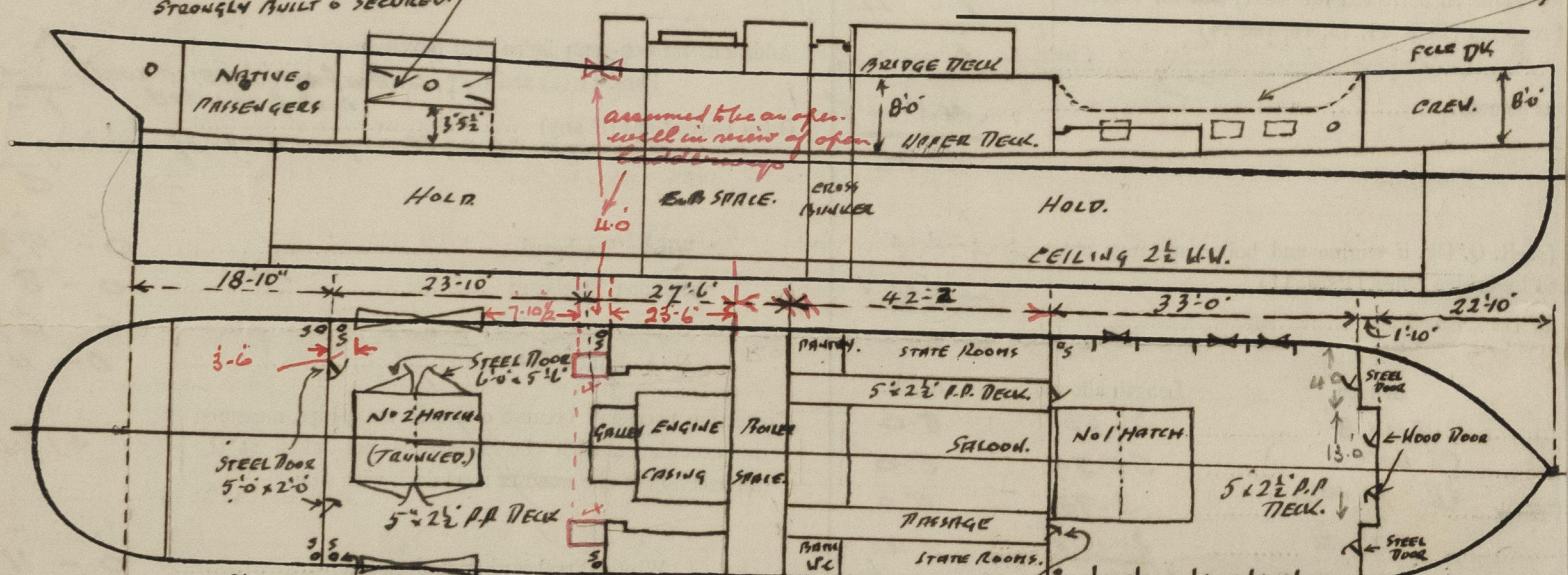

Show hereon line of Floors or Tank Top with position of any Breaks in same; also height of Peak Tank tops, &c., &c. STEEL HINGED DOORS 5'0" x 2'0" COLLISION SCUTTER. 3 FREEING PORTS EACH SIDE FITTED WITH HINGED DOOR.

State any special features in the construction of the Vessel

Builder's name and yard number EARLES S. B. B. HULL YARD NO 678.

Names of sister vessels ✓

Owners EMPREZA DO LIMPOPO LTD. (A. Couto)

" Address LOURENZO MARQUES.  
Fee £ will be charged  
mtt: F.E. Report.

Received by me See J.C. Report.

© 2021  
Lloyd's Register Foundation

42.17  
59.79