


Scale $\frac{1}{2}$ Inch. 1 Foot.

29. 11. 01
14. 12. 01
16. 1. 02
31. 1. 02
ENDING DECS
4. 2. 02
11. 3. 02 ^{6 1/2}
12. 4. 02
19. 4. 02
29. 4. 02
15. 7. 02
23. 7. 02
31. 7. 02

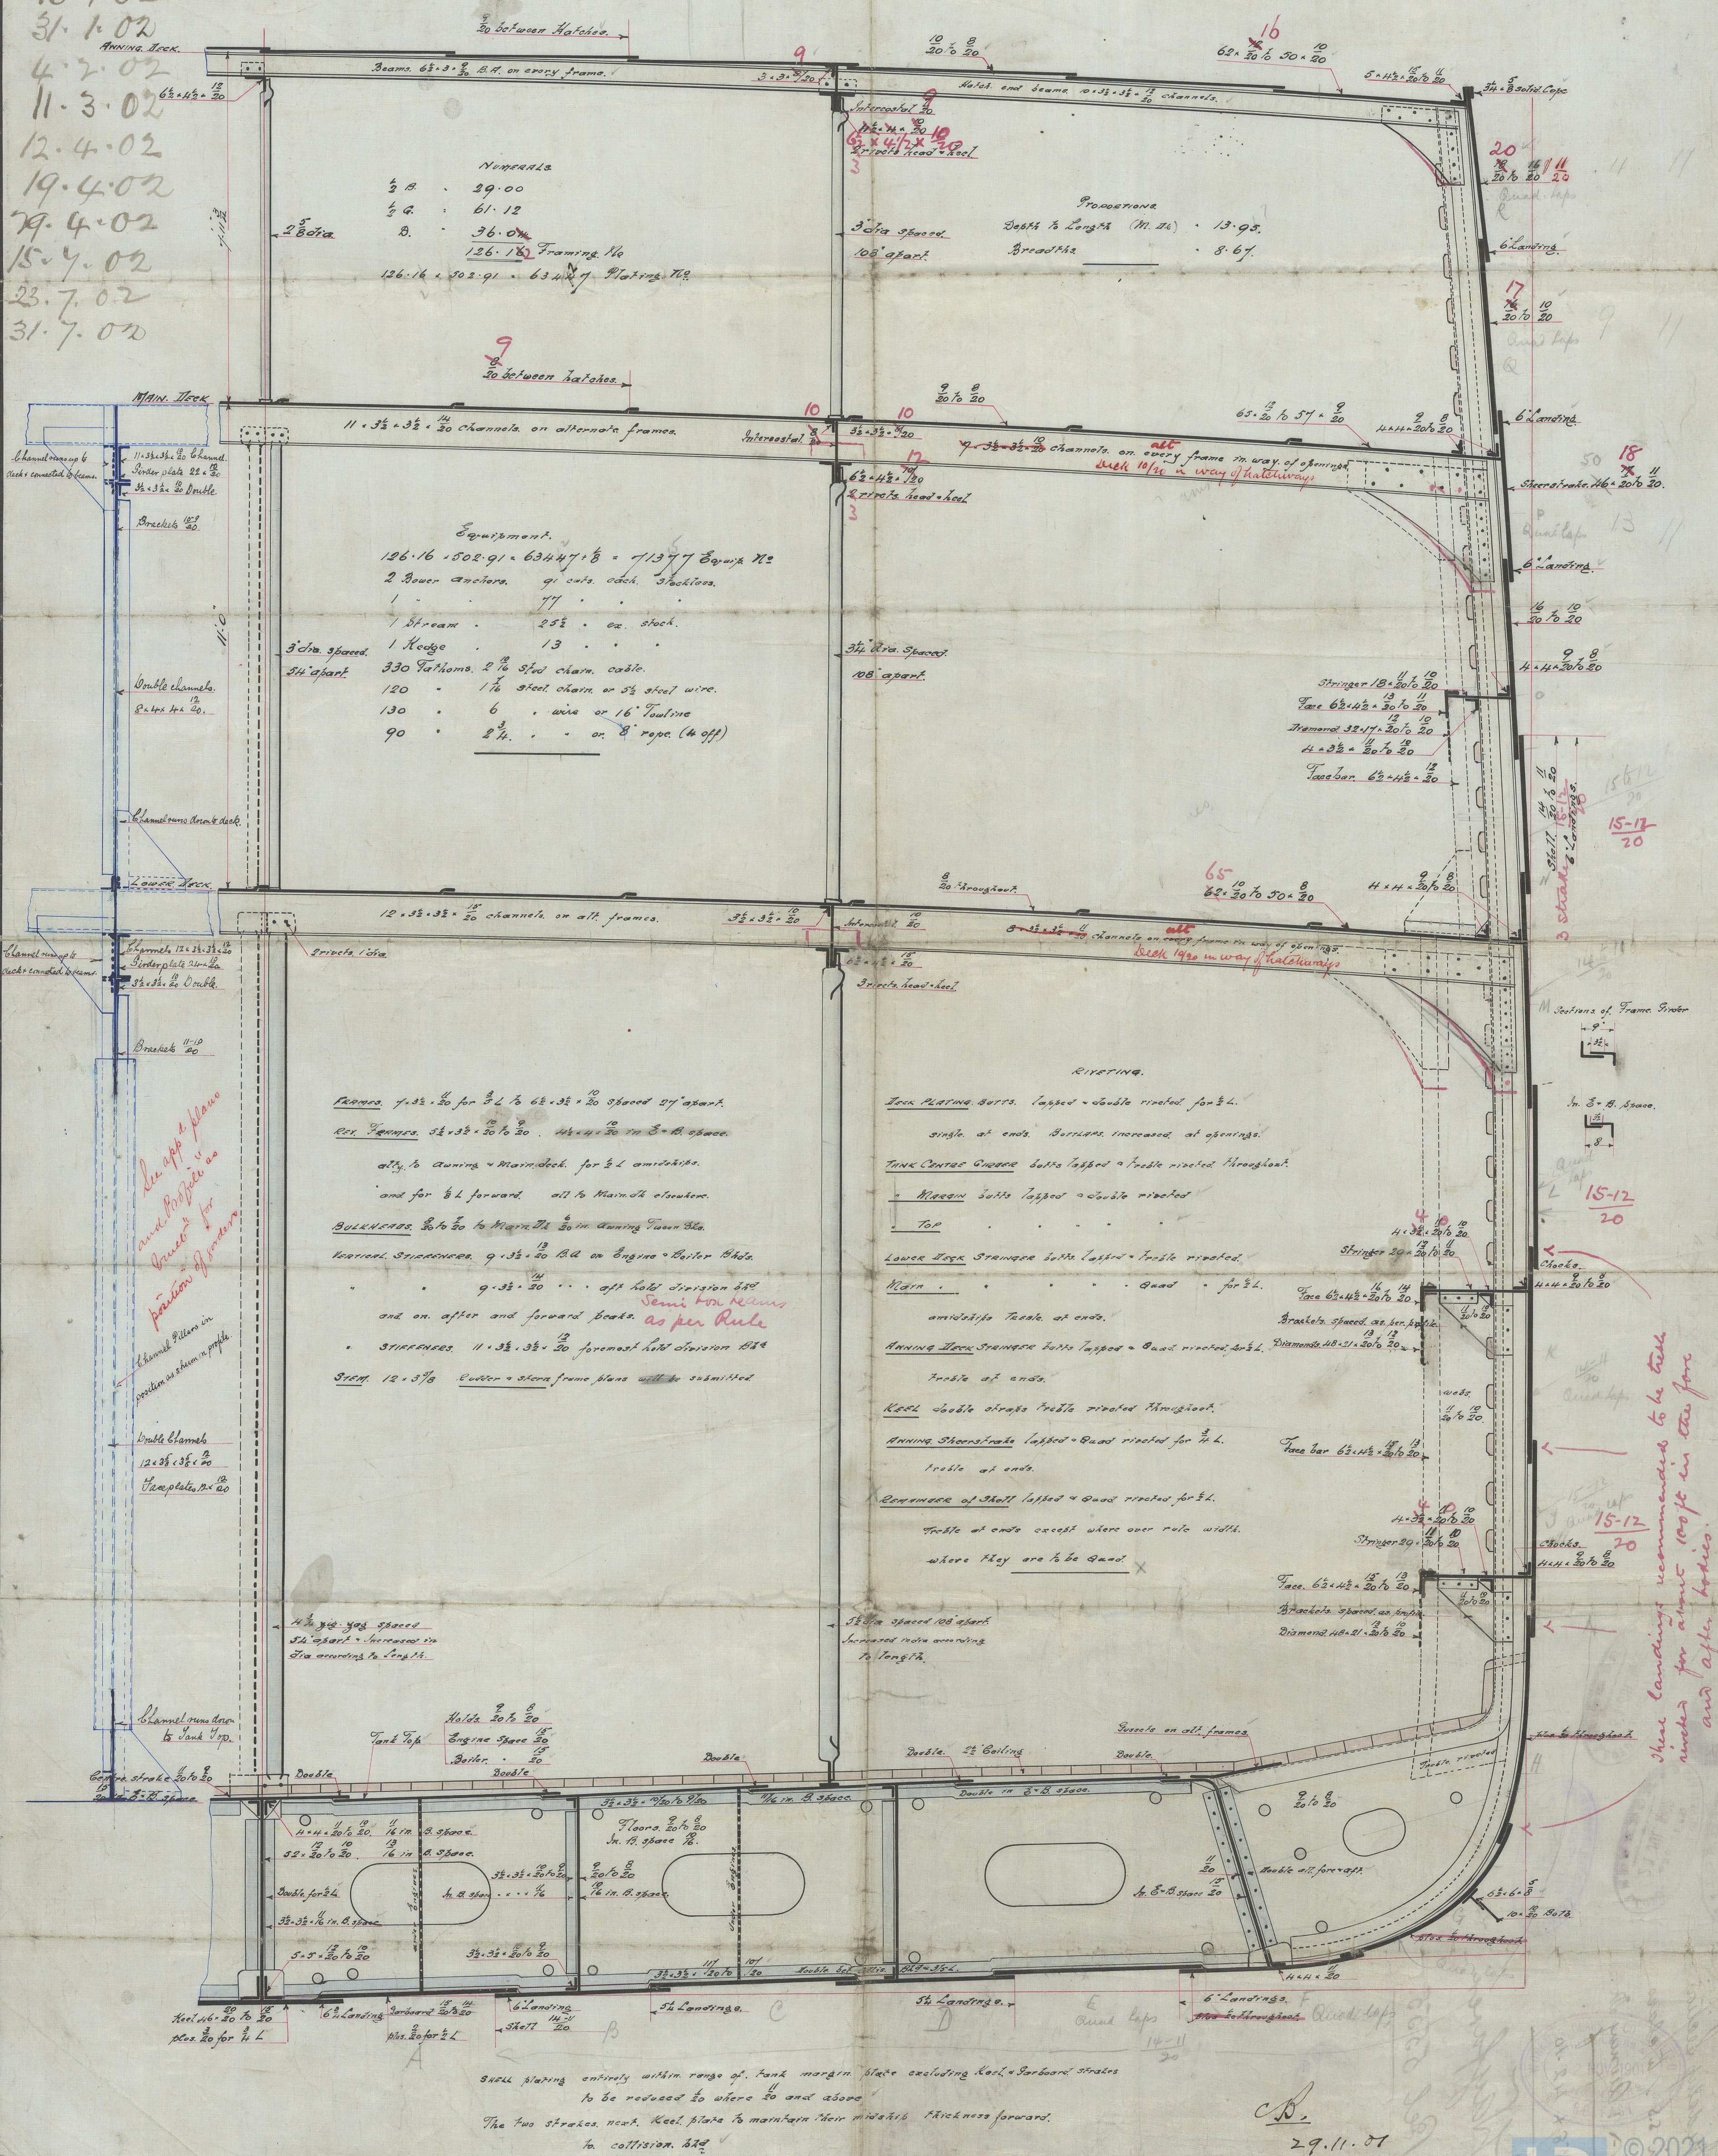






West Workman Clark & Co
ss no. 195

Revised Midship Section
of *Twinn* s.s. to class
100-A 1 Awaiting M.

505 x 58 x 42.10

^{Wayfarer}
S. Wayfarer

Bel 5555.

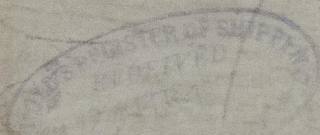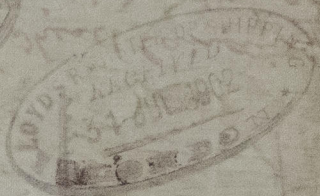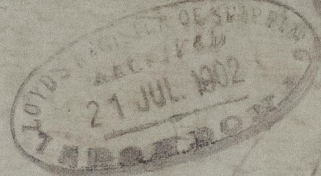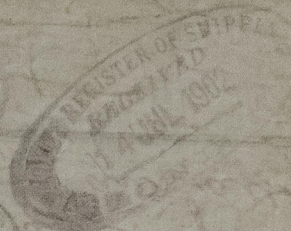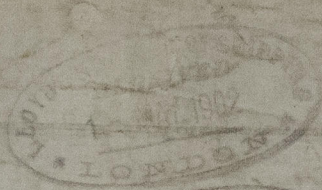

© 2021

Lloyd's Register
Foundation

008158-008167-0226

