

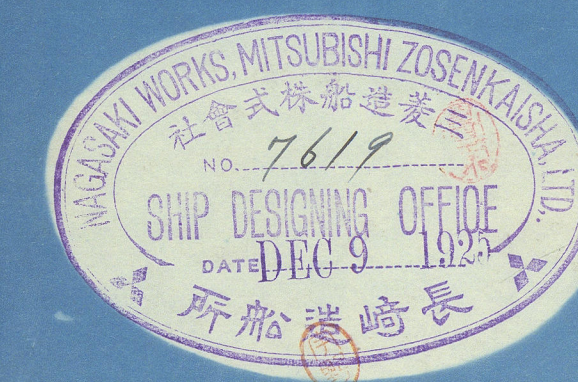


SCALE $\frac{1}{2}$ INCH TO ONE FOOT.
SCALE 1 INCH TO ONE FOOT. DETAILS.

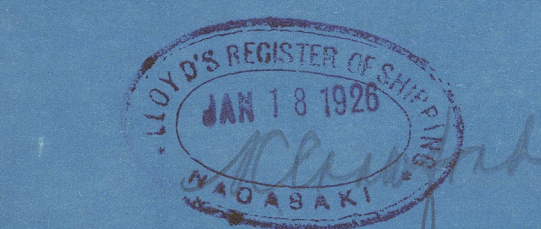

7/2

008158-008167-0307

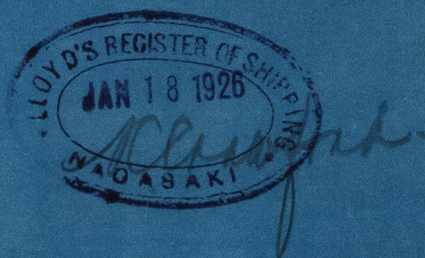

M.S. "SANTOS-MARU."
RUDDER PLAN.
(FINISHED PLAN).
SCALE $\frac{1}{2}$ " & 1" TO 1 FOOT.



12
3
1
F
3



© 2021

Lloyd's Register
Foundation

008158-008167-0307