

# LLOYDS NUMERALS.

L x D 770" x 11.33' = 872.41  
 L x (B+D) 770(21.5+11.33) = 2527.91  
 D/B 77.0 / 11.33 = 6.79

10 OCT 1940


## DIMENSIONS.

LENGTH B.P. 77'-0"  
 BREADTH MLD. 21'-6"  
 DEPTH MLD. AMIDSHIPS 11'-4"

TO LLOYDS CLASS 100.A.1. \* FOR ~~TOWING~~ PURPOSES  
 RIVER AND HARBOUR SERVICES.

## EQUIPMENT

2. STOCKLESS ANCHORS 4 1/2 CWTs.  
 60-FATHOMS 1 3/16" STUO CHAIN CABLE.  
 60. " 5 1/2" HAWSER.  
 60. " 3" WARP.

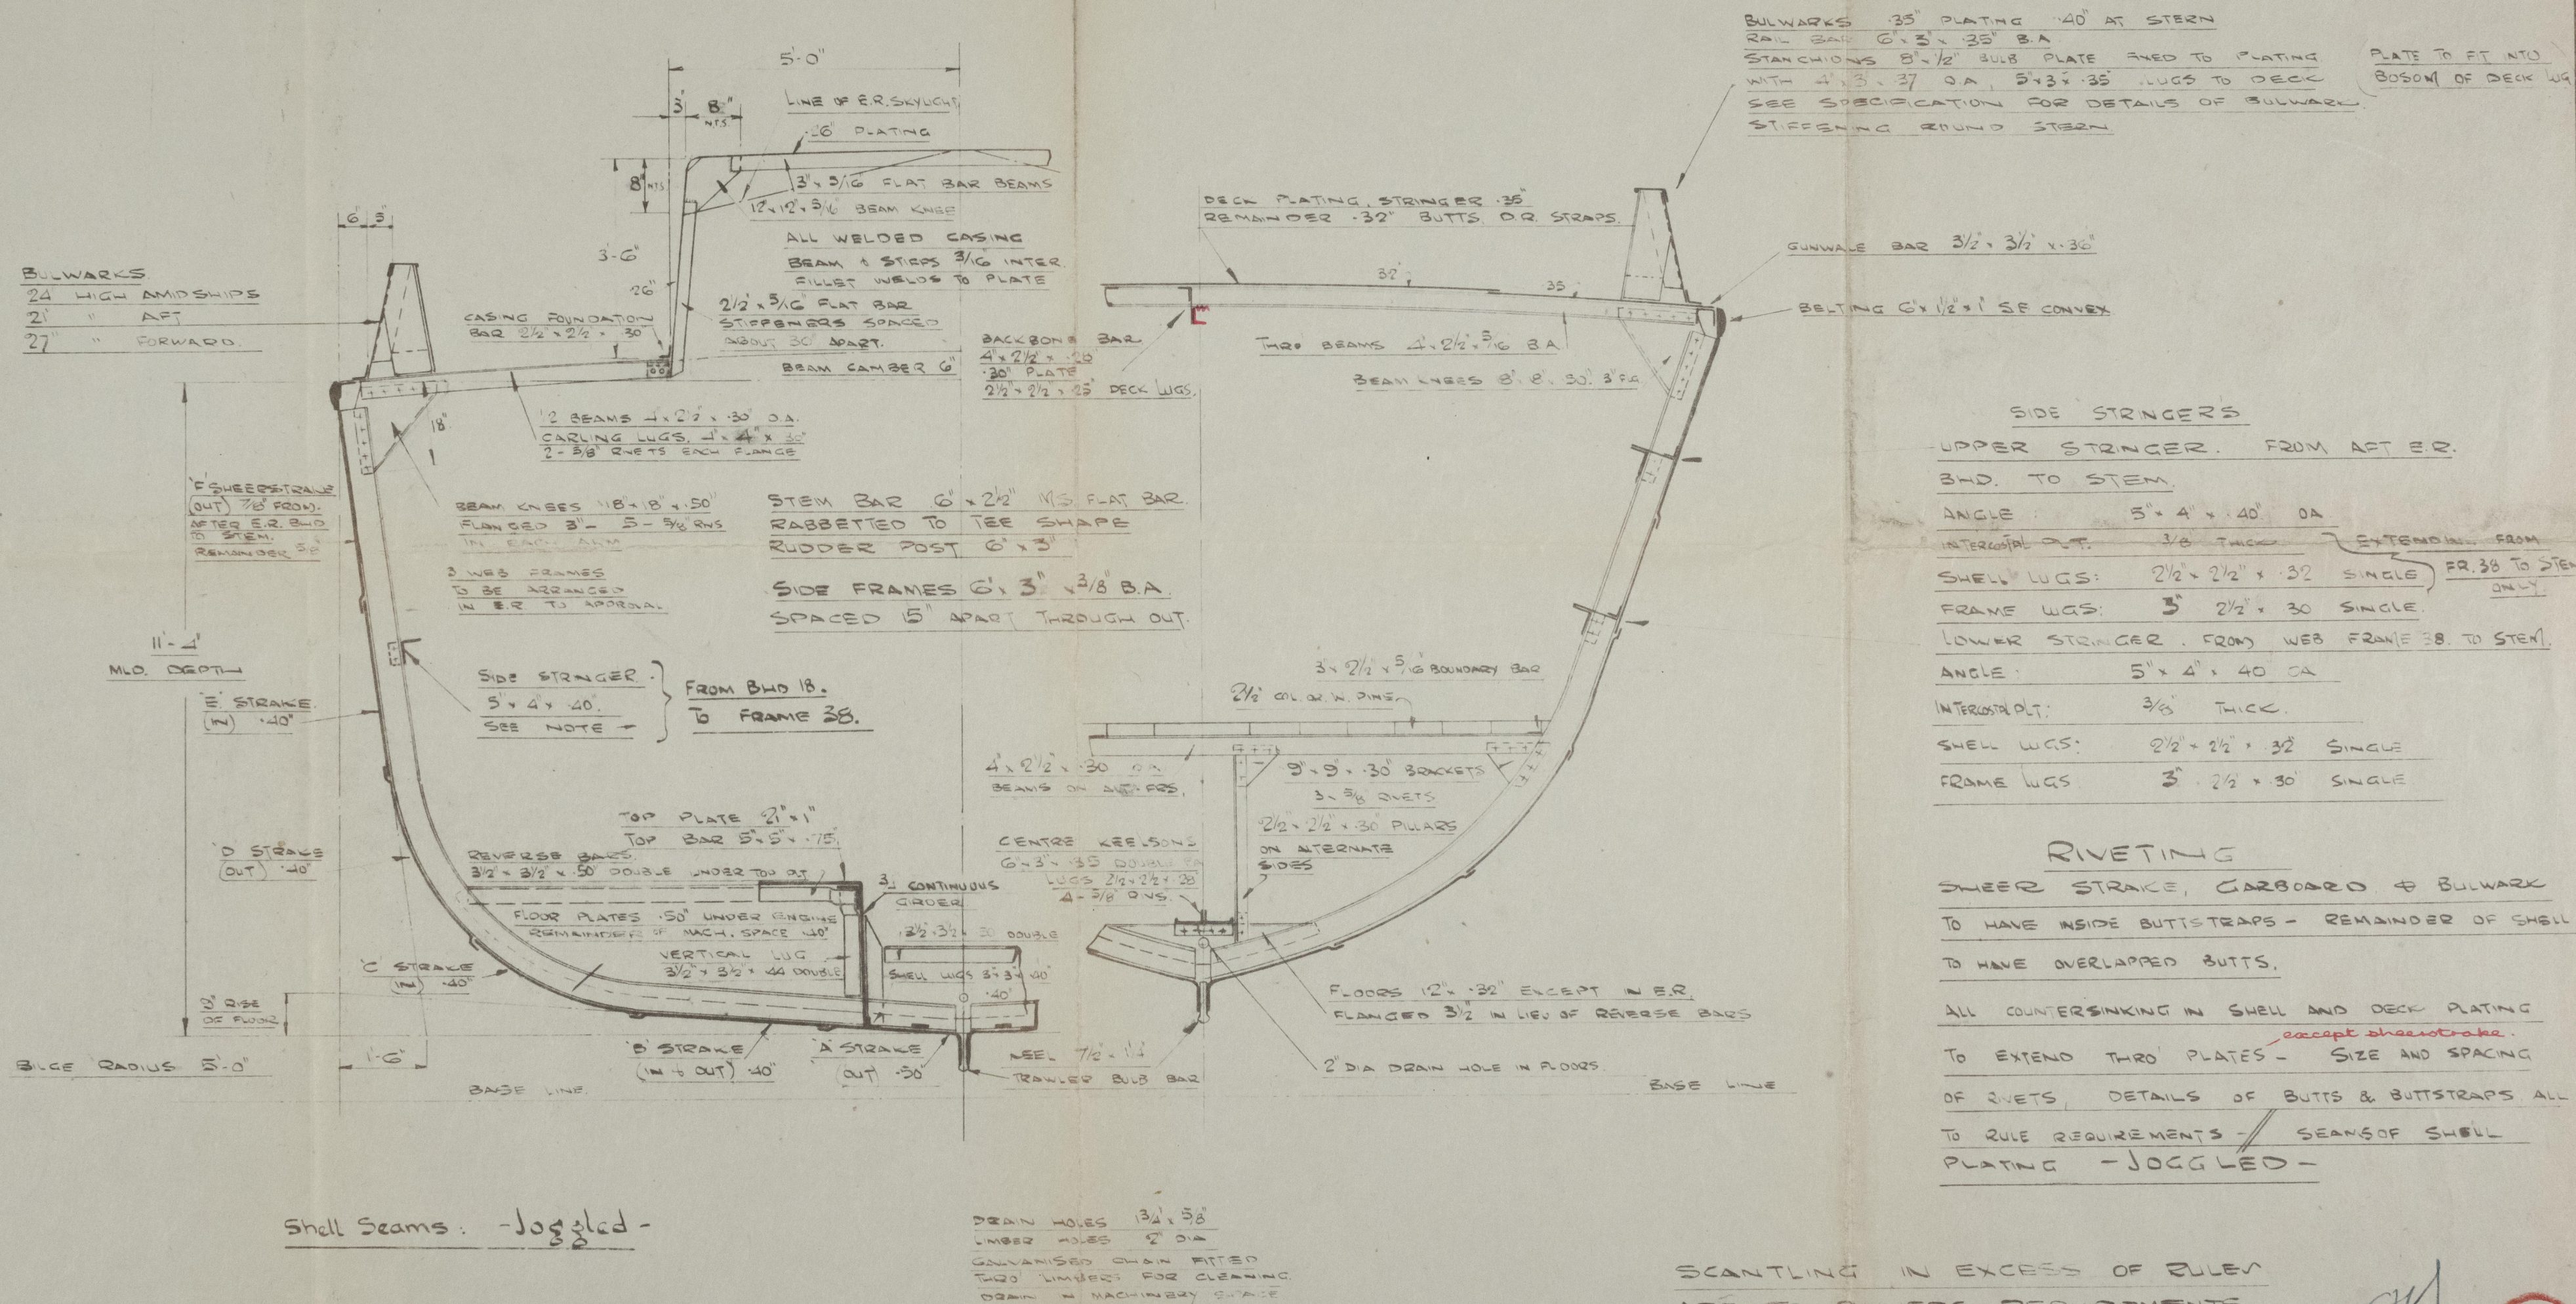

RICHARD DUNSTON LTD.  
 SHIPBUILDERS  
 THORNE YORKSHIRE

DRAWN BY *16* DATE 1.7.46.  
 TRACED BY *16* DATE 6.9.46.  
 CHECKED BY DATE

REVISIONS		
No.	DATE	PARTICULARS

This Drawing and the Information it contains are the Property of RICHARD DUNSTON LTD.  
 it is not to be Traced, Copied or Published without their Written Consent, nor is the Information  
 thereon to be misused in any way.

TITLE: - MIDSHIP SECTION -


SCALE: 1/2" TO ONE FOOT

YARD No. S.561.

DRG. No. 4814/5



MOTOR TUG "CEMENCO"

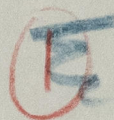


Henry Scaris S.561.  
(Richard Dunston)

Hull F.E. Rpt. No. 54859.

MIDSHIP SECTION.

RECORDS DEPT.,  
LONDON

Hul 54849.

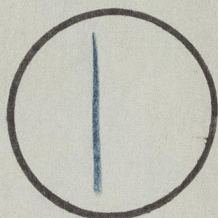

© 2020

Lloyd's Register  
Foundation

008177-008185-0038