

21-8-16.

MIDSHIP SECTION.


N^{os} 687-8.

STEEL SCREW TRAWLERS

DIMS: 138'4" x 23'9" EXT. x 13'6" MOULDED

SCALE 1/2" = 1 FOOT.

DECK PLATED OVER IN WAY OF MACHINERY SPACE
ENGINE & BOILER CASING AS PREVIOUSLY APPROVED

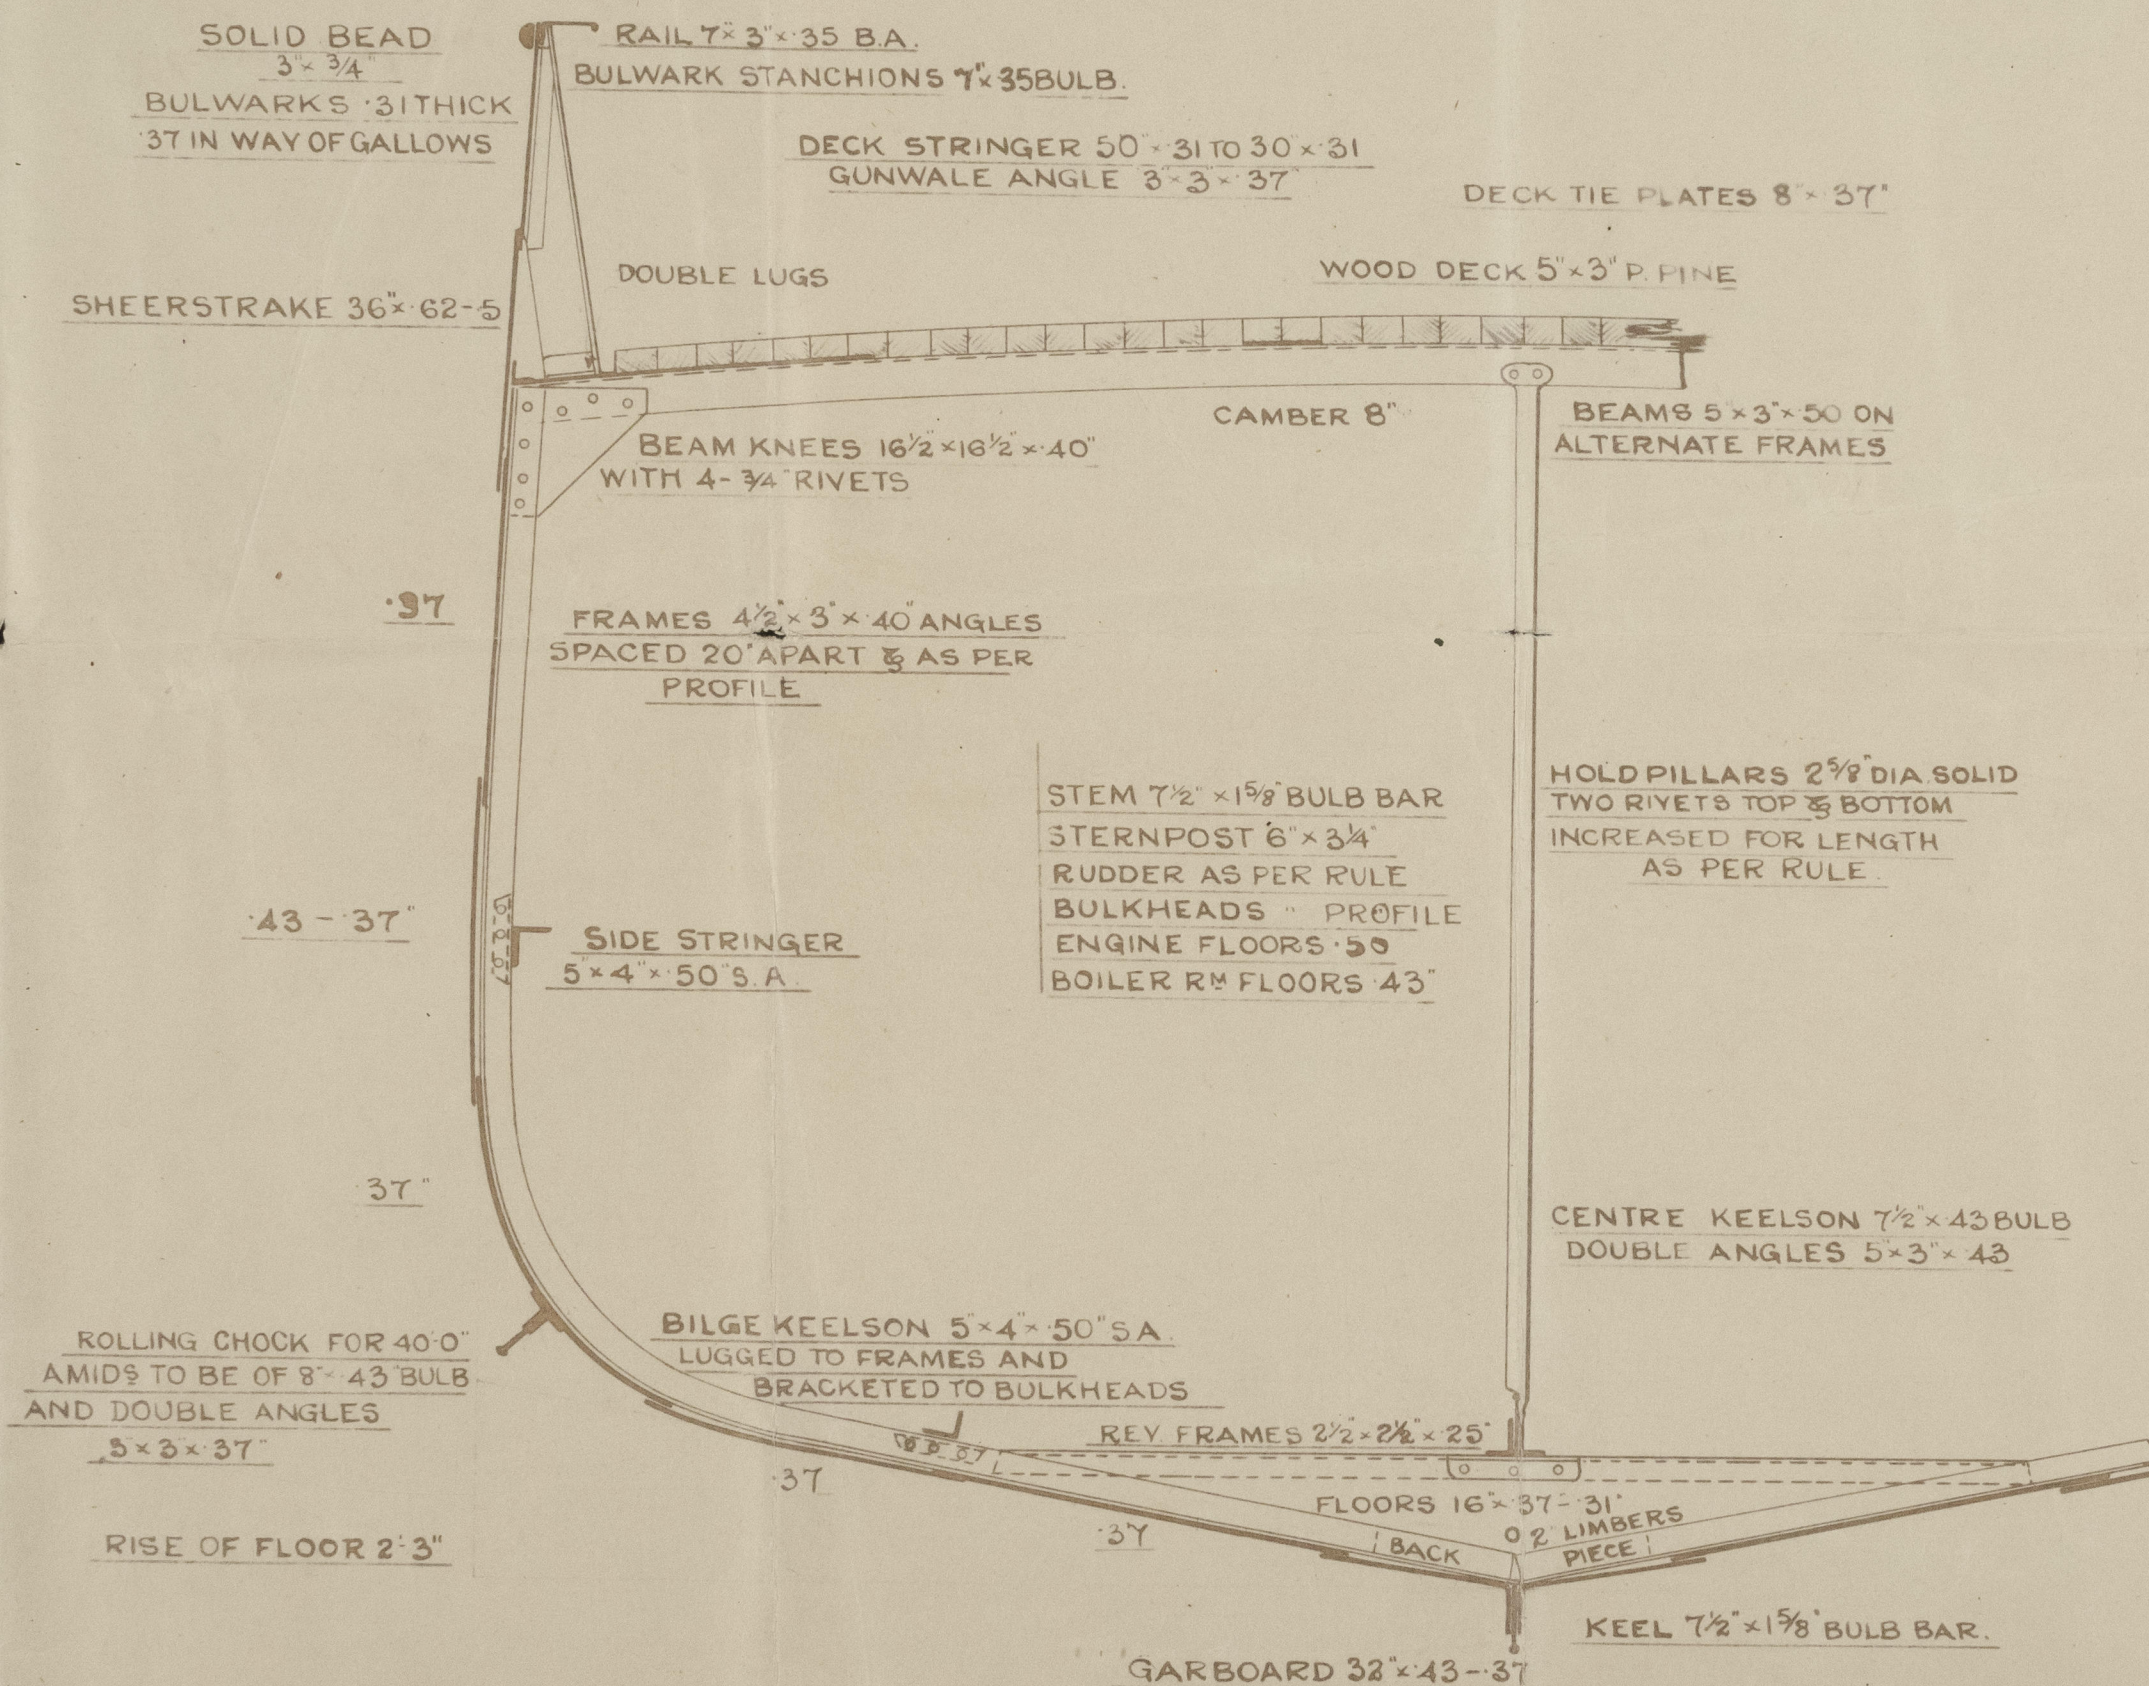

PLAN No. 475
FOR ENCLOSURE TO
FROM
BUILDERS, SELBY.
11/8/16

NUMERALS

B+D ----- 37 12
L x (B+D) ----- 5134 80

PROPORTIONS

L/B ----- 5 85
D ----- 10 24
D = 12 17

EQUIPMENT.

1ST BOWER ANCHOR 80WT STOCKLESS
2ND " " 7 1/4 " "
KEDGE " 3 1/4 EX STOCK.
120 FATHOMS 1 1/16 STUD LINK CABLE
60 " 6" HAWSER
60 " 5" WARP.

RIVETTING.

BUTTS OF SHELL PLATING LAPPED AND DOUBLE RIVETED, EXCEPT GARBOARD AND SHEERSTRAKE WHICH ARE STRAPPED AND DOUBLE RIVETED. LANDINGS DOUBLE RIVETED. BULWARKS SINGLE RIVETED.


SHELL RIVETS 3/4" DIA IRON
KEEL, STEM & STERNFRAME, 1" DIA. IRON

C.F.
21.8.16

Hull Rpt No 29960.

S.S. William Westenberg

687/8

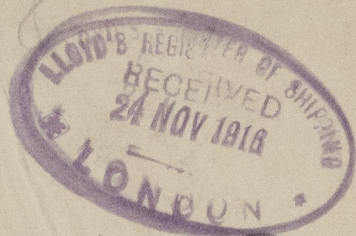



MS

N.N. Star of the Realm
Messrs Cochrane & Sons
Ltd.

S/S N^{os} 687 + 688.

Star of the Realm


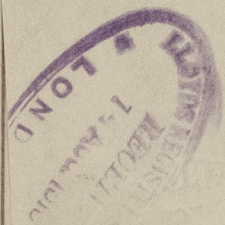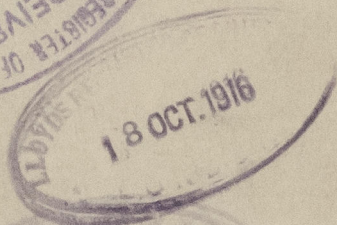

8600-581800-641800



© 2020

Lloyd's Register
Foundation

8 + 687 + 8