


Lloyd's Register of Shipping.

SURVEYS FOR FREEBOARD.

(CONDITIONS OF ASSIGNMENT.)

Ship's Name STAR OF THE REALM Port of Survey YARMOUTH
 Official Number 143929 Surveyor's Signature Ch. Mapleton
 Nationality and Port of Registry BRITISH. FALMOUTH Date of Survey 25/10/46.

Disposition and dimensions of superstructures, trunks, deckhouses and machinery casings to be inserted in the diagrams and tabular statement :-

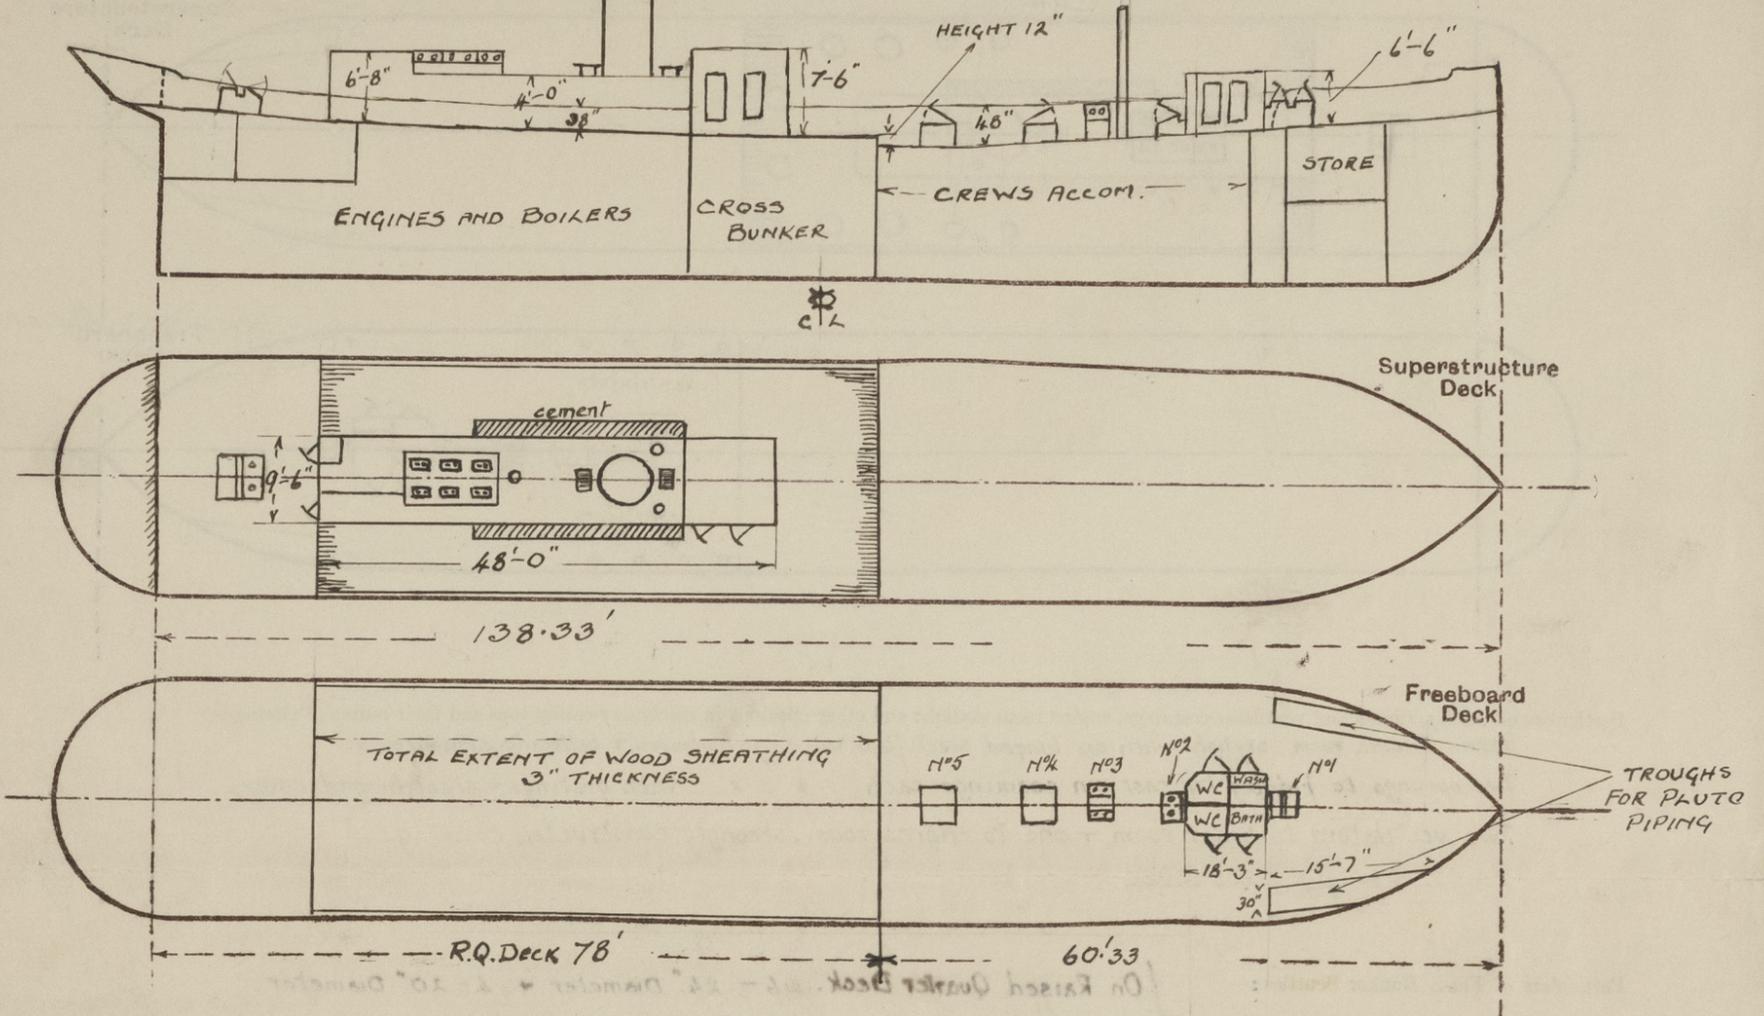

Particulars of Superstructures, Trunks, Casings, Deckhouses.


	Coaming	Plating	Stiffeners	Spacing	End Attachments of Stiffeners	Size of Openings	Height of Sills	Height of Casings
Poop Bulkhead								
Raised Quarter Deck Bulkhead ...	12" x 30"	.28" - .26"	5 1/2" x 3" x .36"	28"	Brackets at top & bottom	✓	✓	✓
Bridge, After Bulkhead								
Bridge, Forward Bulkhead								
Forecastle Bulkhead								
Trunk, Aft								
Trunk, Forward								
Exposed Machinery Casings on Freeboard or Raised Quarter Decks ...								
Exposed Machinery Casings on Superstructure Decks	17" x 35"	.30	3" x 3" x .28"	30"	None	46" x 22"	19"	4'-0"
Machinery Casings within Superstructures not fitted with Class I Closing Appliances								
Deckhouses on Flush Deck <u>FORE DECK</u> Ships ...	1/2"	.50"	3" x 3" x .375"	36"	None	4'-6" x 22"	13"	6'-6"

Particulars of Closing Appliances (state if capable of being manipulated from both sides).

Poop Bulkhead	✓
Raised Quarter Deck Bulkhead ...	NO OPENINGS.
Bridge, After Bulkhead	✓
Bridge, Forward Bulkhead	✓
Forecastle Bulkhead	✓
Exposed Machinery Casings on Freeboard or Raised Quarter Decks ...	ONE HINGED STEEL DOOR, OPERATED FROM BOTH SIDES.
Exposed Machinery Casings on Superstructure Decks	✓
Machinery Casings within Superstructures not fitted with Class I Closing Appliances	✓
Deckhouses on Flush Deck Ships ...	✓

PARTICULARS OF PROTECTION TO OPENINGS, ETC.

The following diagrams should be used to indicate the positions of cargo and coaling hatchways, gangway, cargo and coaling ports, ventilators, companionways, etc., which would affect the seaworthiness of the ship:—

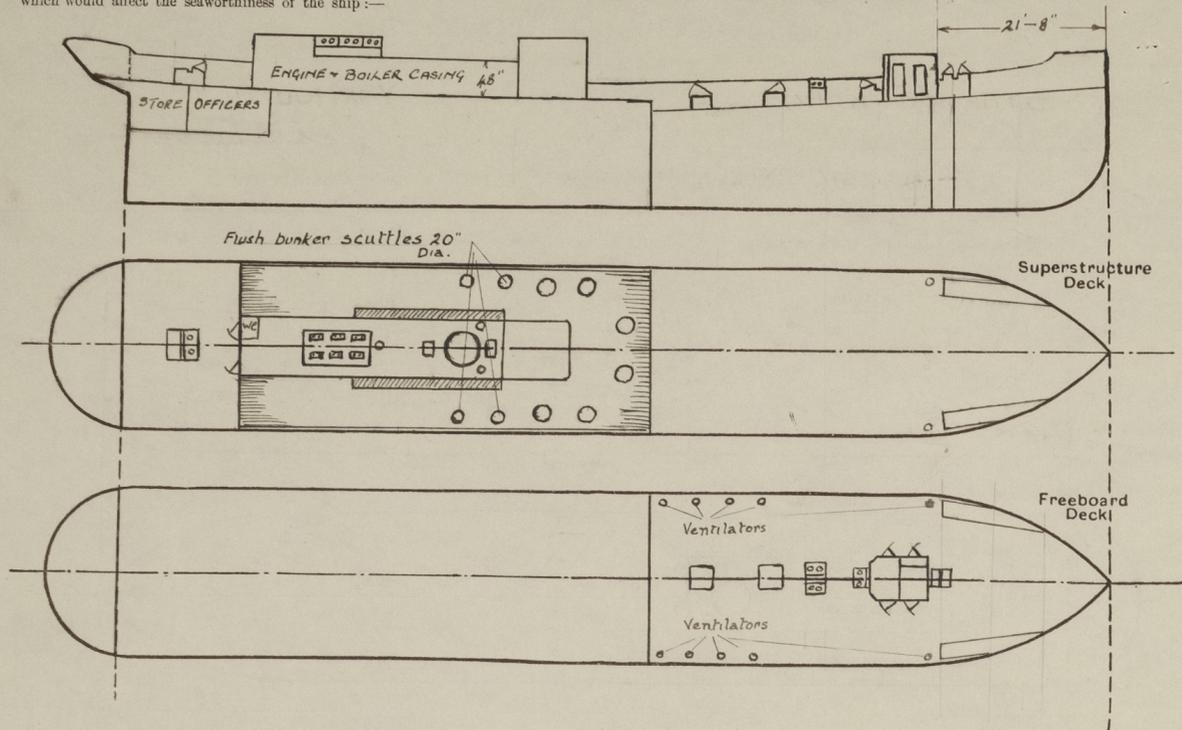

Particulars of fiddle, funnel and ventilator coamings, engine room skylight and other openings in machinery casing tops and their means of closing:—
 STEEL ENGINE ROOM skylight with six hinged steel flaps with light glasses, & battening arrangements.
 Two openings to fiddle top, cast iron coamings each * * with gratings & steel hinged covers.
 Two ventilators to boiler room, & one to engine room, strongly constructed coamings.
 Funnel strongly constructed.

Particulars of Flush Bunker Scuttles:—
 { On Raised Quarter Deck. 6 - 24" Diameter + 4 - 20" Diameter.
 All bayonet fastening type with chain attachment.

Particulars of Companionways:—
 None

Particulars of Ventilators in exposed positions on freeboard and superstructure decks:—

On Freeboard Deck:— Five port, & five starboard, each:— 20 1/2" x 6" x .31"
 with wood plugs & canvas covers

Particulars of Air Pipes in exposed positions on freeboard, raised quarter, or superstructure decks:—

None

Particulars of Gangway Cargo and Coaling Ports:—

None

Star of the Realm.

Particulars of Scuppers and Sanitary Discharge Pipes:—

Scuppers, On Raised Quarter Deck:— 8 on each side
 " " Freeboard Deck One on each side at after ends } All size 8" x 3"

No overboard discharges from spaces below freeboard or R.Q. Decks

Particulars of Side Scuttles:—

None

Vertical distance of Sill of lowest Side Scuttle above top of keel

Particulars of Guard Rails:—

None

Particulars of Gangways, Lifelines, etc.:—

Ropes stretched between bridge & fore deck house

Particulars of Freeing Arrangements.

	Length of Bulwark	Height of Bulwark	Size of Freeing Ports	Number each side	Area each side	Rule area each side
After Well	77-67"				12-0	
Raised Quarter Deck	48'-0"	3'-2"	18" x 10"	3	3-7 1/2	
Forward Well					10-0	
Freeboard Deck	60'-4"	4'-0"	12" x 24"	1	2-0	

State position of each freeing port (After Well:— Evenly spaced throughout
 (F. and A. position and height above deck edge) (Forward Well:— Close to aft end)

State whether the freeing ports are fitted with shutters, bars, or rails, and give particulars of such:— On Quarter Deck, steel bars not more than 9" apart

Additional area where sheer is less than standard.


On Freeboard Deck:— Sliding shutters.
 steel bars not more than 9" apart

PARTICULARS OF PROTECTION TO OPENINGS, ETC.

HATCHWAYS ON FREEBOARD AND SUPERSTRUCTURE DECKS.									
Description of Hatchway		N ^o 1	N ^o 2	N ^o 3	N ^o 4	N ^o 5	N ^o 6		
Dimensions of Hatchway		5'-10" x 30"	2'-7" x 33"	2'-8" x 30 1/4"	2'-8" x 30 1/4"	2'-8" x 30 1/4"	4'-1" x 38"		
COAMINGS	Height above Deck	18"	16"	30 1/2"	18 1/2"	18 1/2"	18 1/2"		
	Thickness	Sides	.31"	.375"	.31"	.31"	.31"	.31"	
		Ends	.31"	.375"	.31"	.31"	.31"	.31"	
	Stiffeners	✓	✓	✓	✓	✓	✓		
Brackets, Stays	✓	✓	✓	✓	✓	✓			
HATCH BEAMS	Number								
	Spacing								
FORE AND AFTERS	Scantling and Sketch			None					
	Bearing Surface								
HATCH COVERS	Material	All covers hinged steel							
	Thickness	watertight & operated from both sides							
Spacing of Cleats									
Number of Tarpaulins				None					

Particulars of any special features:—

Keel removed in its entirety
troughs as shown in sketch for
laying "Pulo" pipe line.

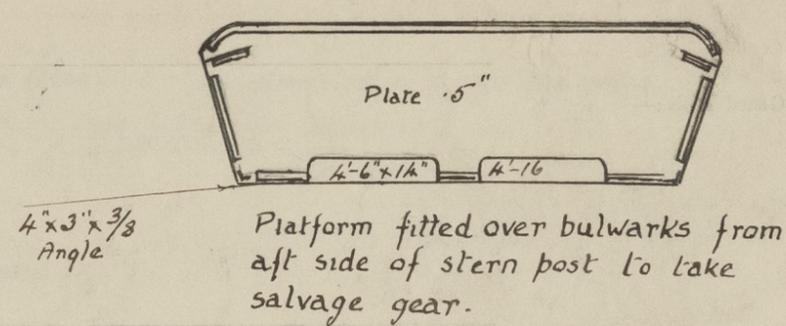

Endorsement at first survey and at surveys for renewal of Certificate:—

The fittings and appliances are in accordance with the particulars shown on this form (or as now modified) and are in good condition.