

"Well Park" - Greenock Report No. 10870  
 "Glen Park" - Greenock Report No.

17.5.83.

Midship Section of Steel Screw Steamer, No. 318 & 319.

Length for Loads	211' 0"
Breadth moulded	31' 0"
Depth do to M. D.	14' 10"
Do. of hold. - - -	14' 02"



Scale  $\frac{1}{2}$  in = 1 foot.

Anchors and Chains  
 1 Bower Anchor 1 1/2 Cts. ex. Stock  
 1 do do 1 1/2 do do do  
 1 do do 1 1/2 do do do  
 1 Biron do 5 1/2 do. do do  
 1 Hedge do 2 3/4 do. do do  
 210 Palmers 1 1/2 Cable Chain  
 60 " 1 1/2 Stream "

(Ridge not now required)

*Hansers.*  

Reveling.  
Bulls of small rth.D. stung  
fules to be lapped & treble  
invited for 2 length amids  
a remainder double invited. ✓  

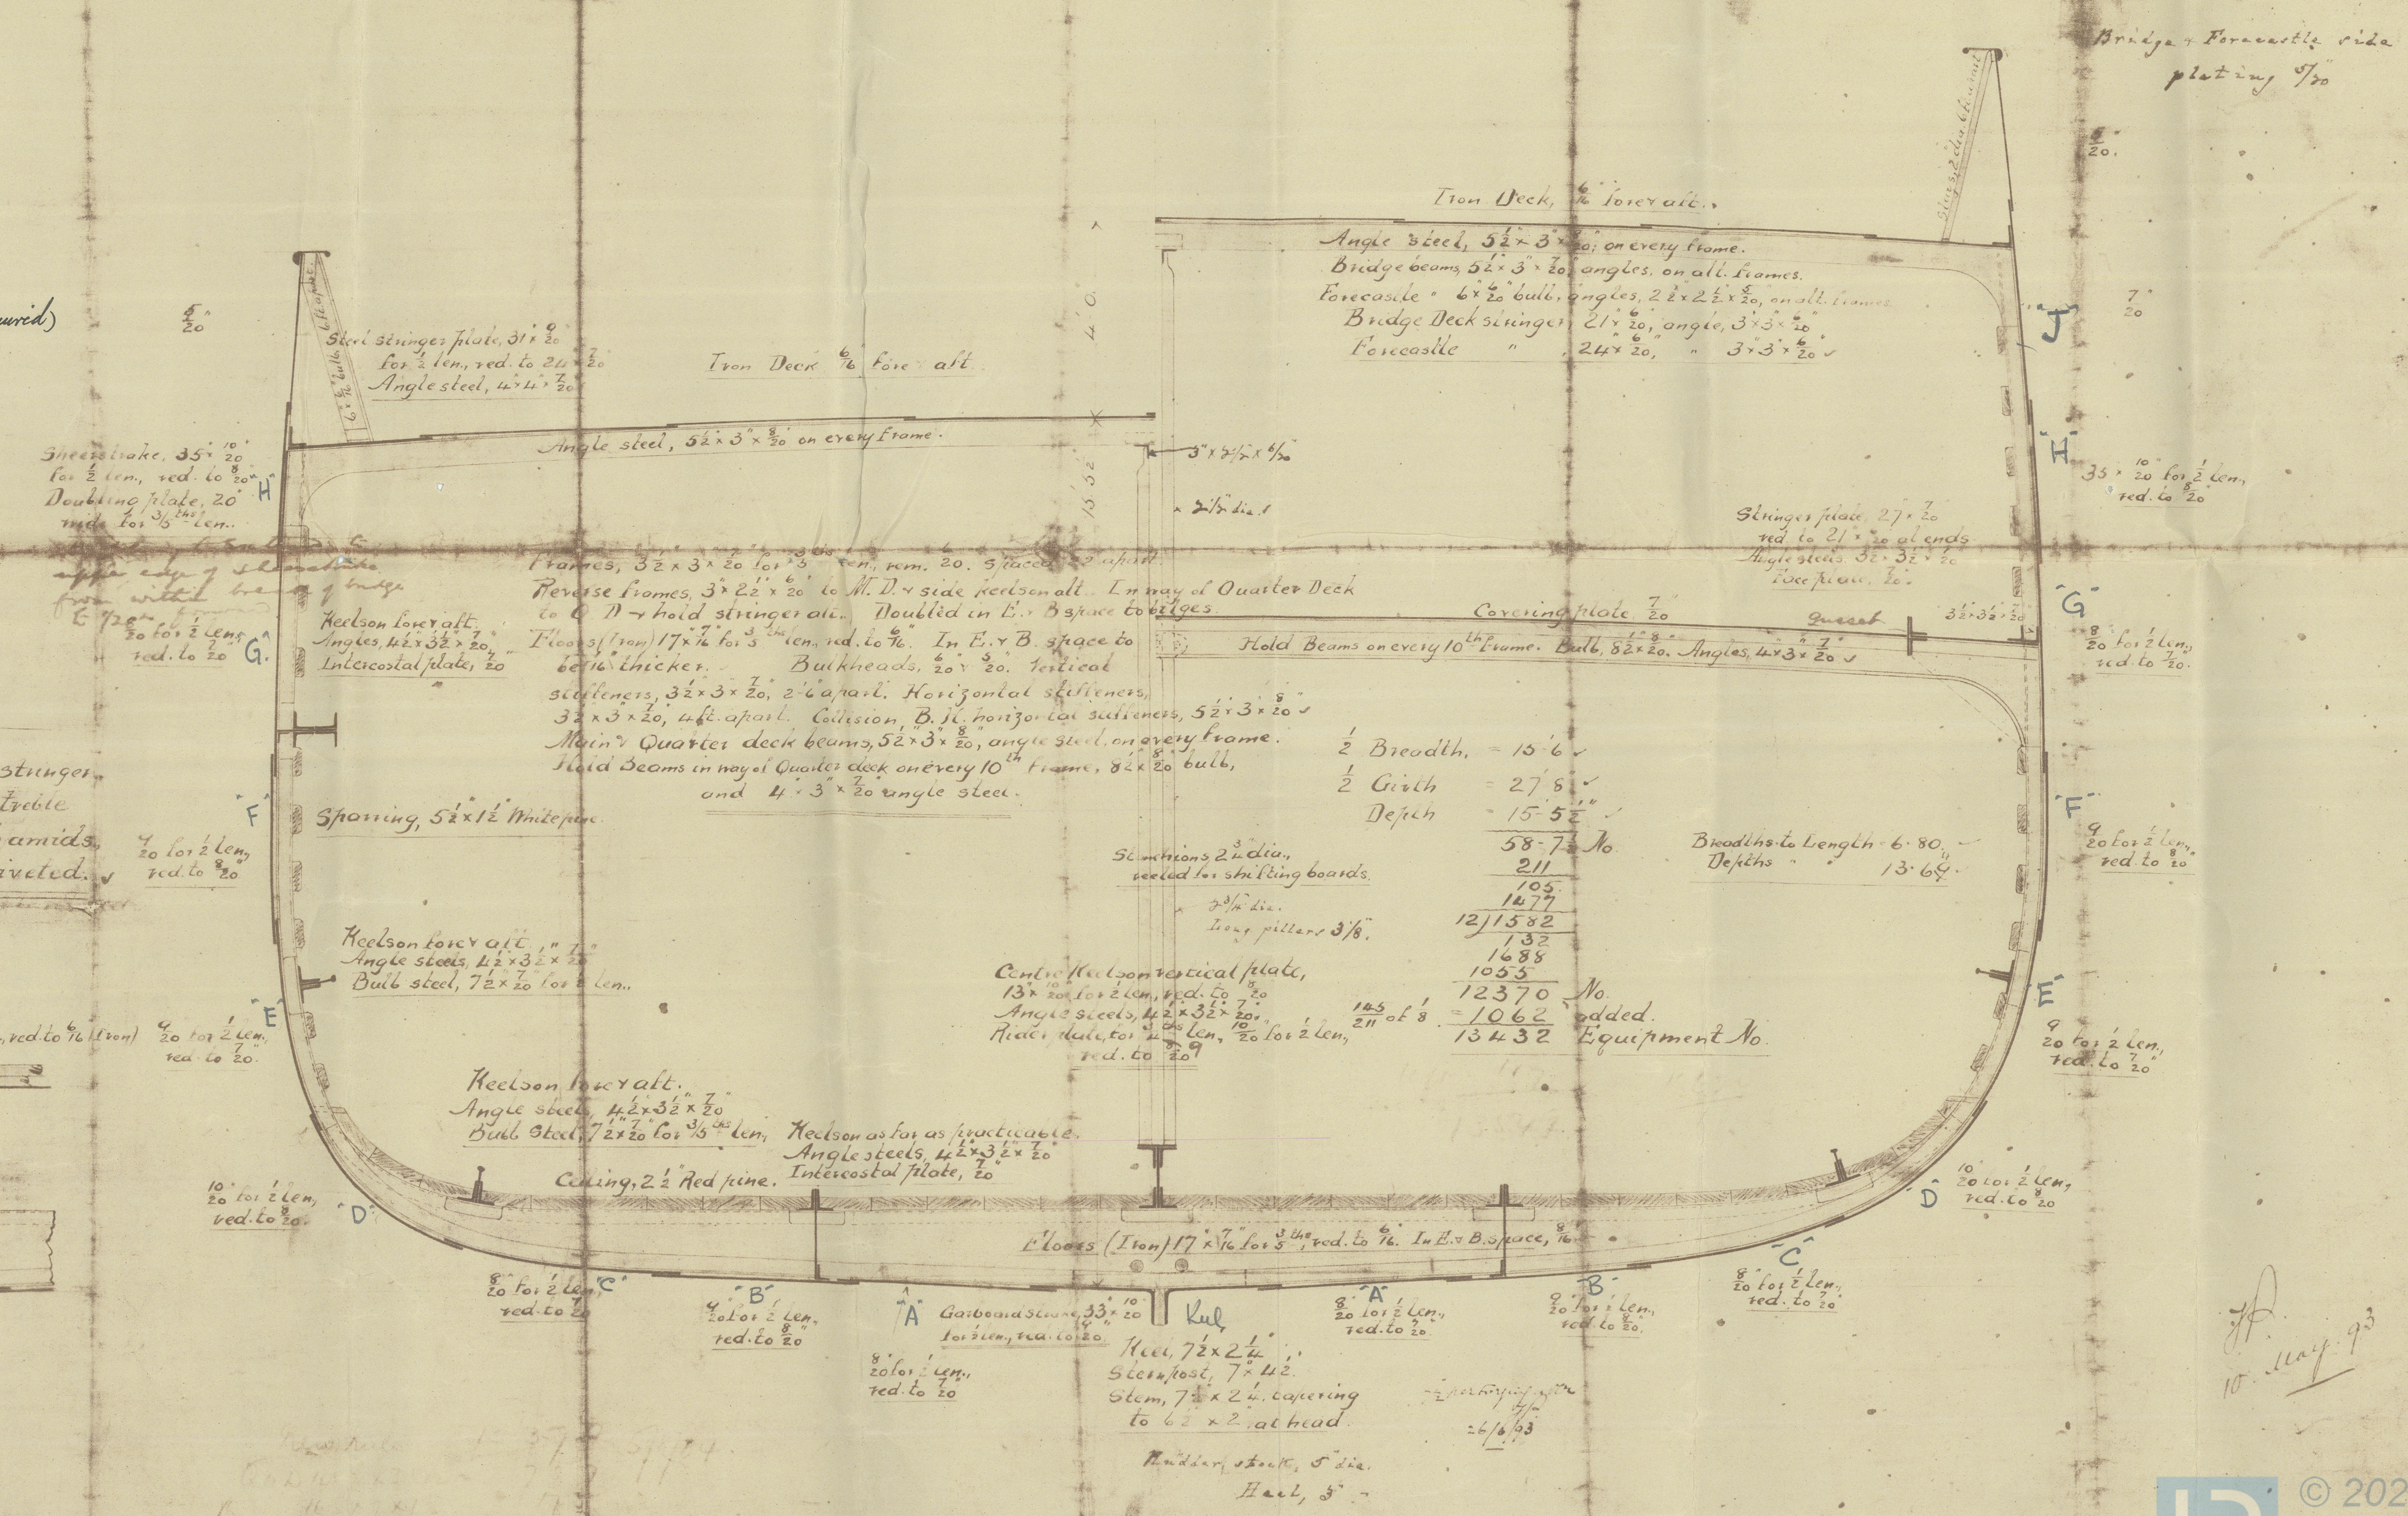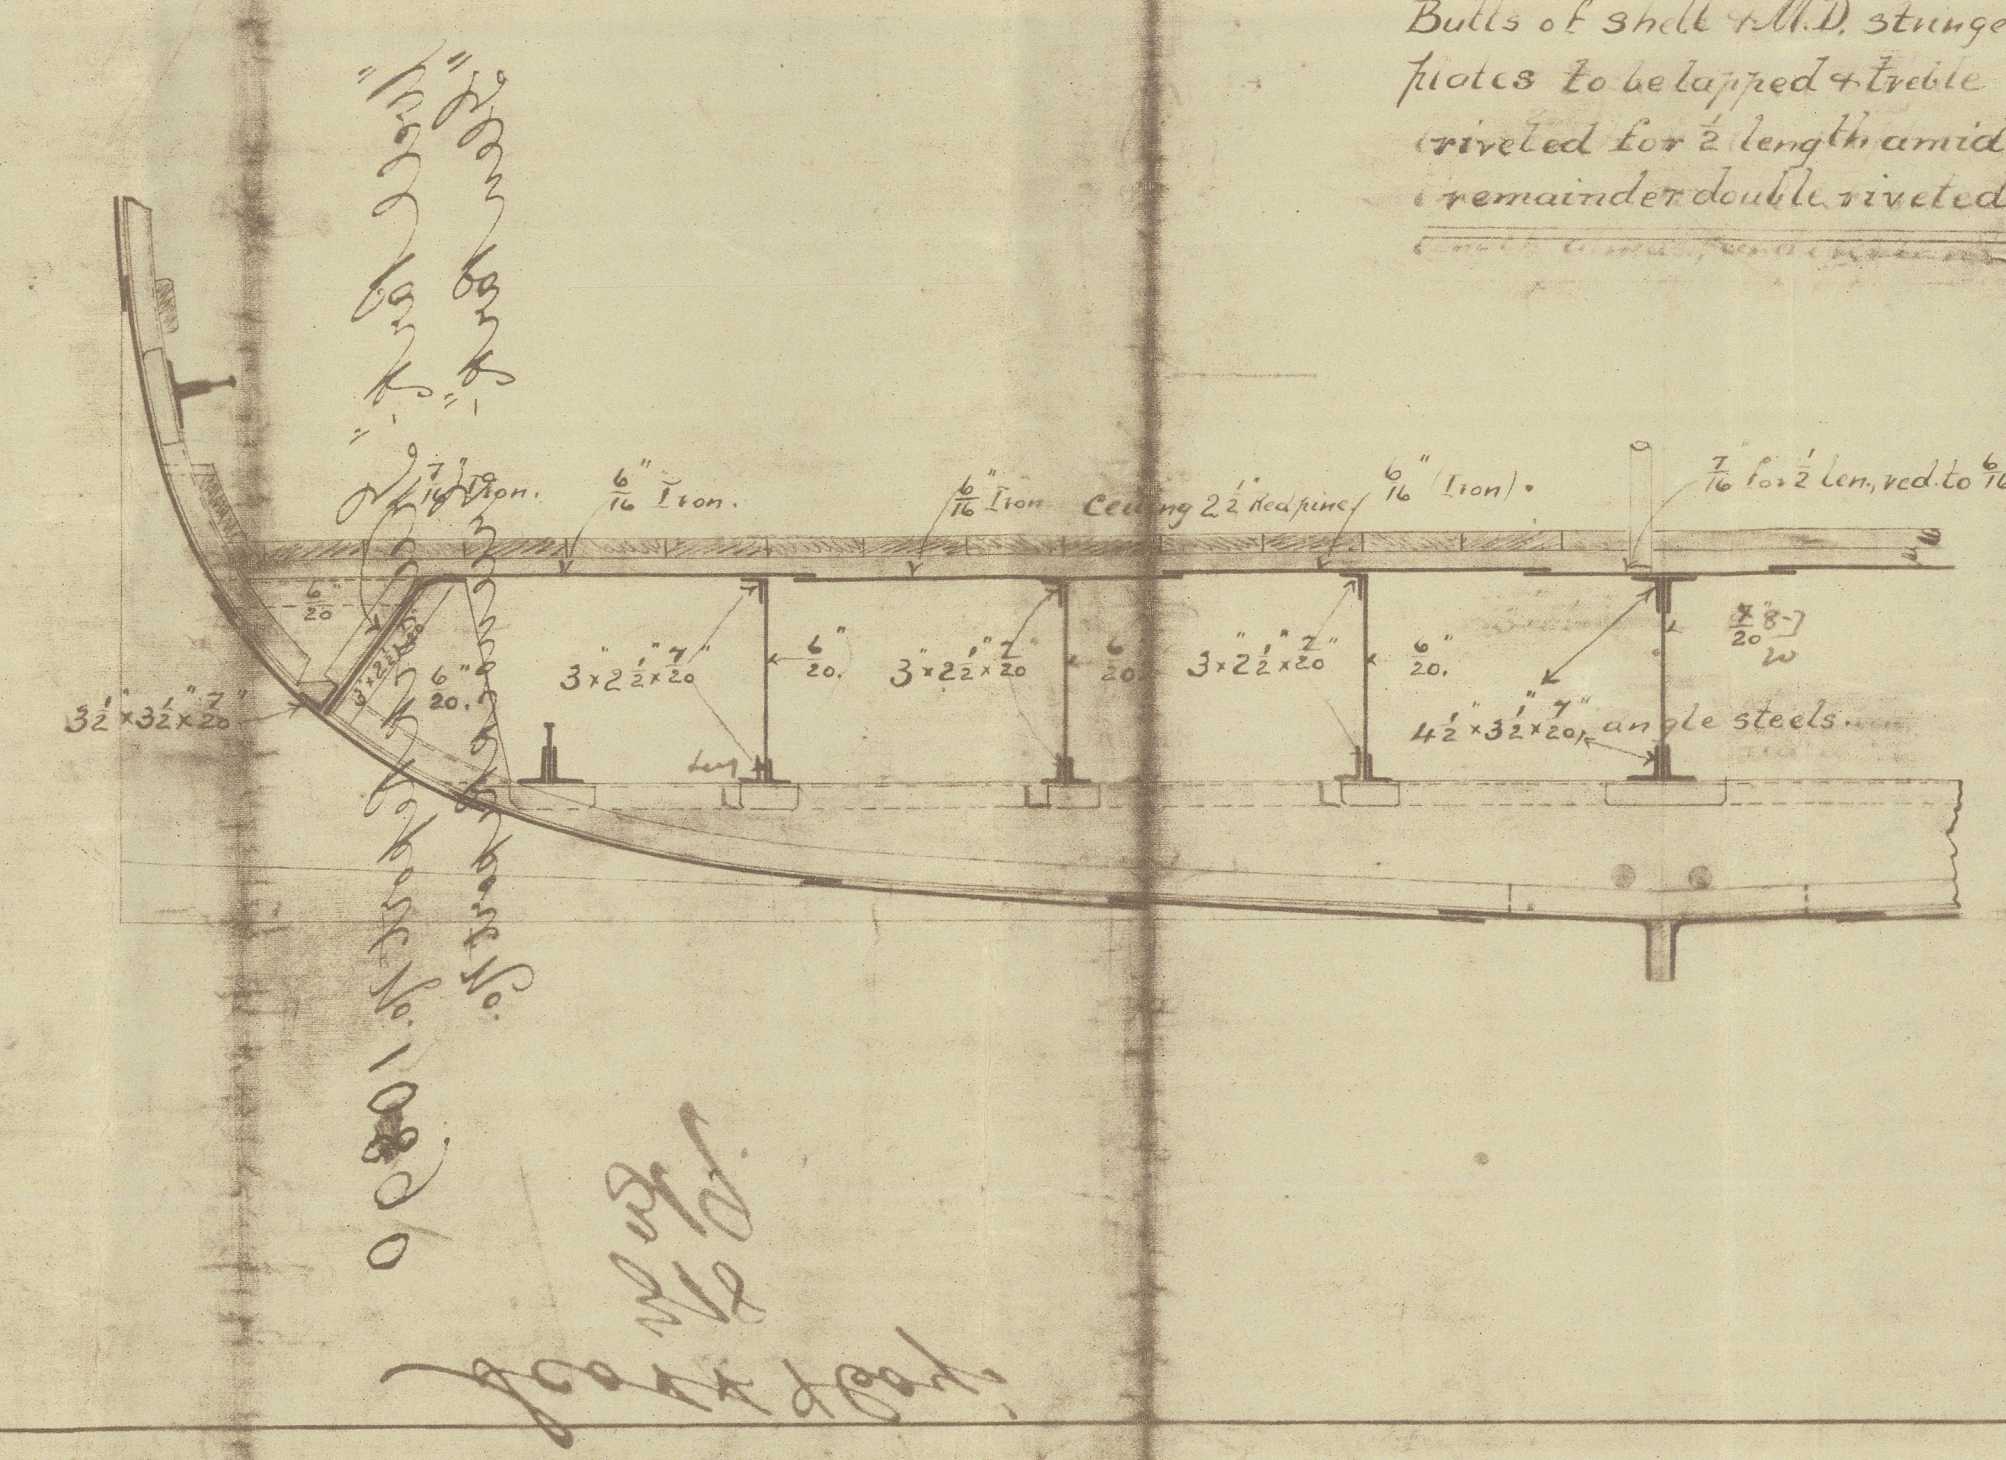

7P.  
10 May 93



008177-008185-0187

Sh. Sc 'JAN' (built at Fink 1893.)

Midship<sup>in C.F.O.</sup> Section (Share com)

File with 78 vol.

Grk. 10898 © 2020

Grk rept No. 10898's Register  
Foundation