

Lloyd's

For Record purposes.

N^{os} 600-601



29-1-19

RUDDER FRAME.


SCALE:- 1" = 1 FOOT

MAINPIECE TO BE OF ROLLED MILD STEEL


ARMS TO BE FORGED IRON

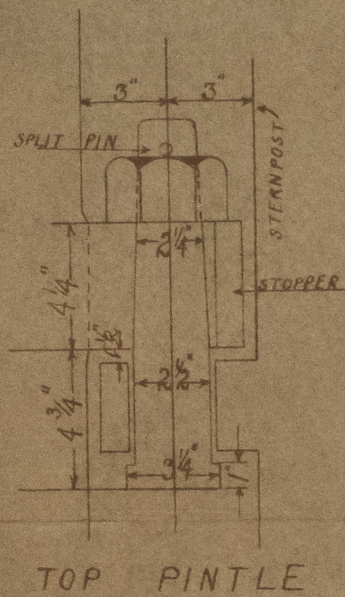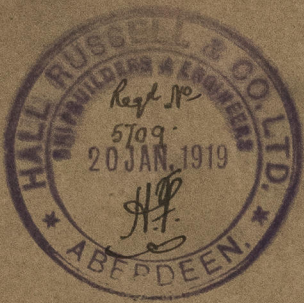

TOP PINTLE

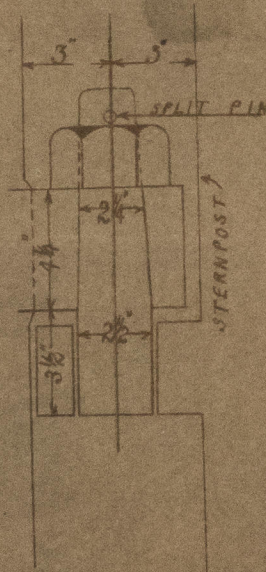


(TWO OFF)

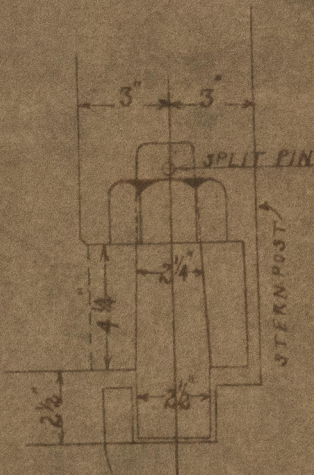

BOTTOM PINTLE

DRAWING N^o 600-601

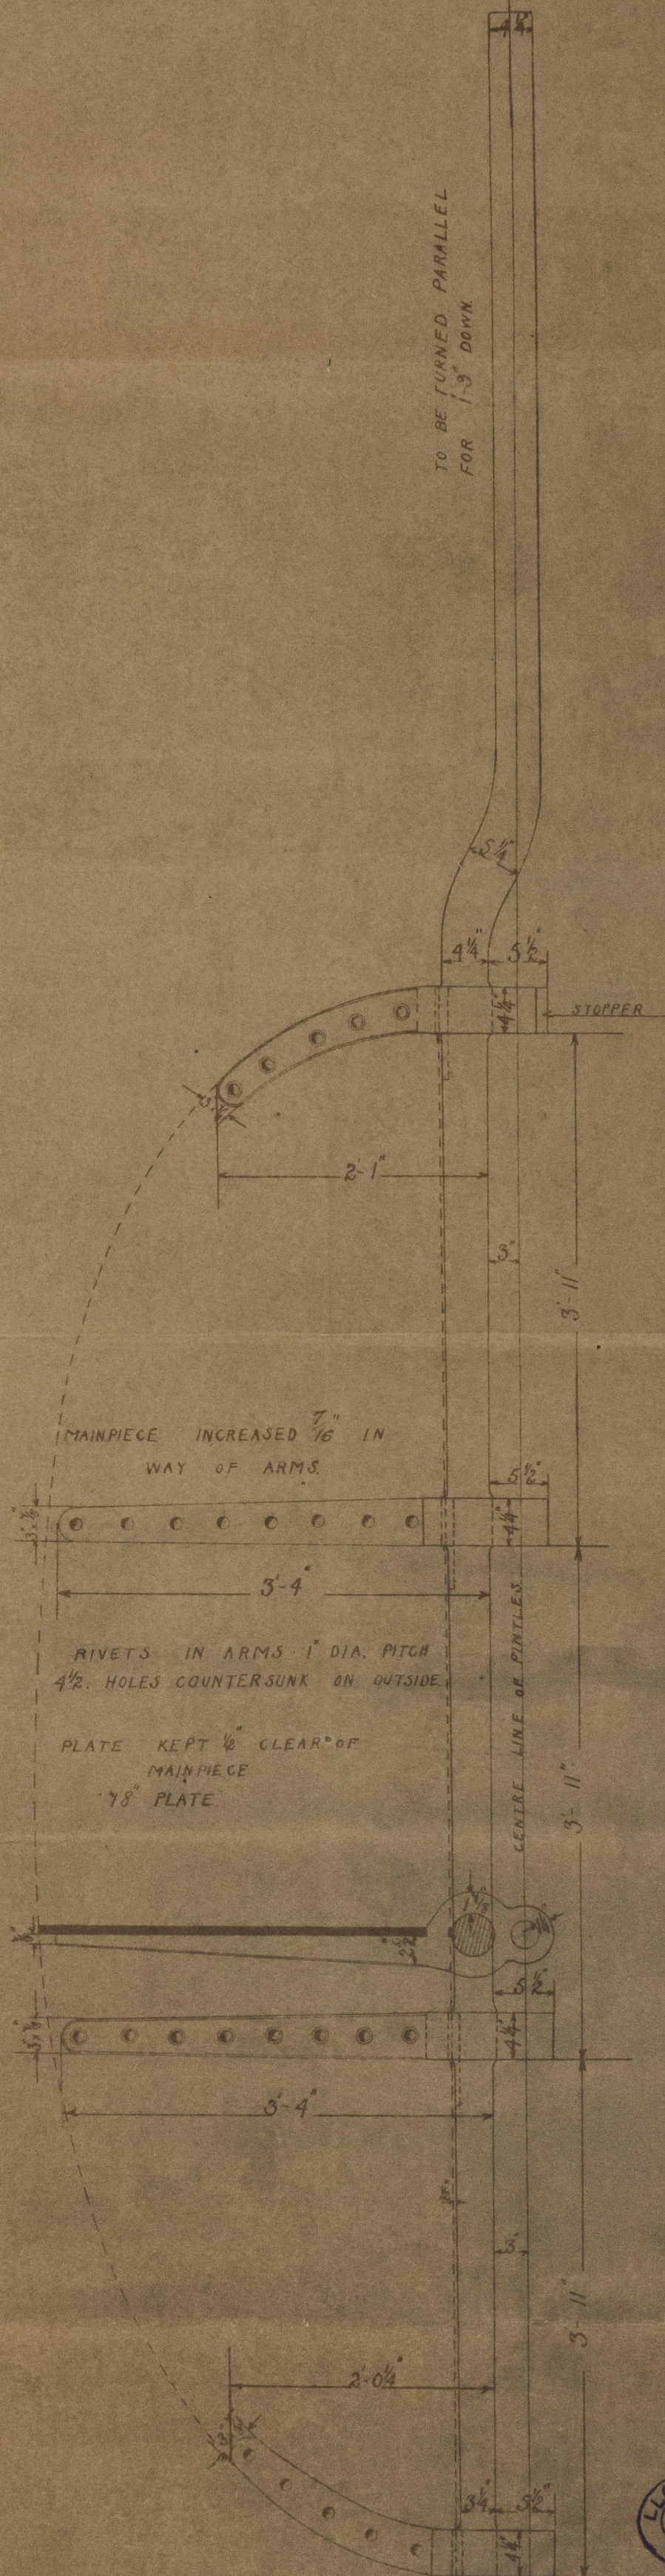

Lloyd's Register Foundation

008186-008200-0121

Hall Russell & Co. Ltd.

Nos. 600 & 1.

Rudder Name.

600/ S.S. "Ben Heilem"

Abn. F.C. Rept. No. 12280.

601/ S.S. "Ben Namur"

Abn. F.C. Rept. No. 12281.



© 2021

Lloyd's Register
Foundation

008186-008200-0121

Rudder Name.