

30.3.01  
2.4.01

Tracing showing Proposed Alteration  
of Side Stringers  
Barque No 490


Scale  $\frac{1}{2}$ " = one foot

Pl<sup>h</sup> Number 105.76

Steamer No 102.9 No 4856

Lower Deck

MMJ  
25/3/01

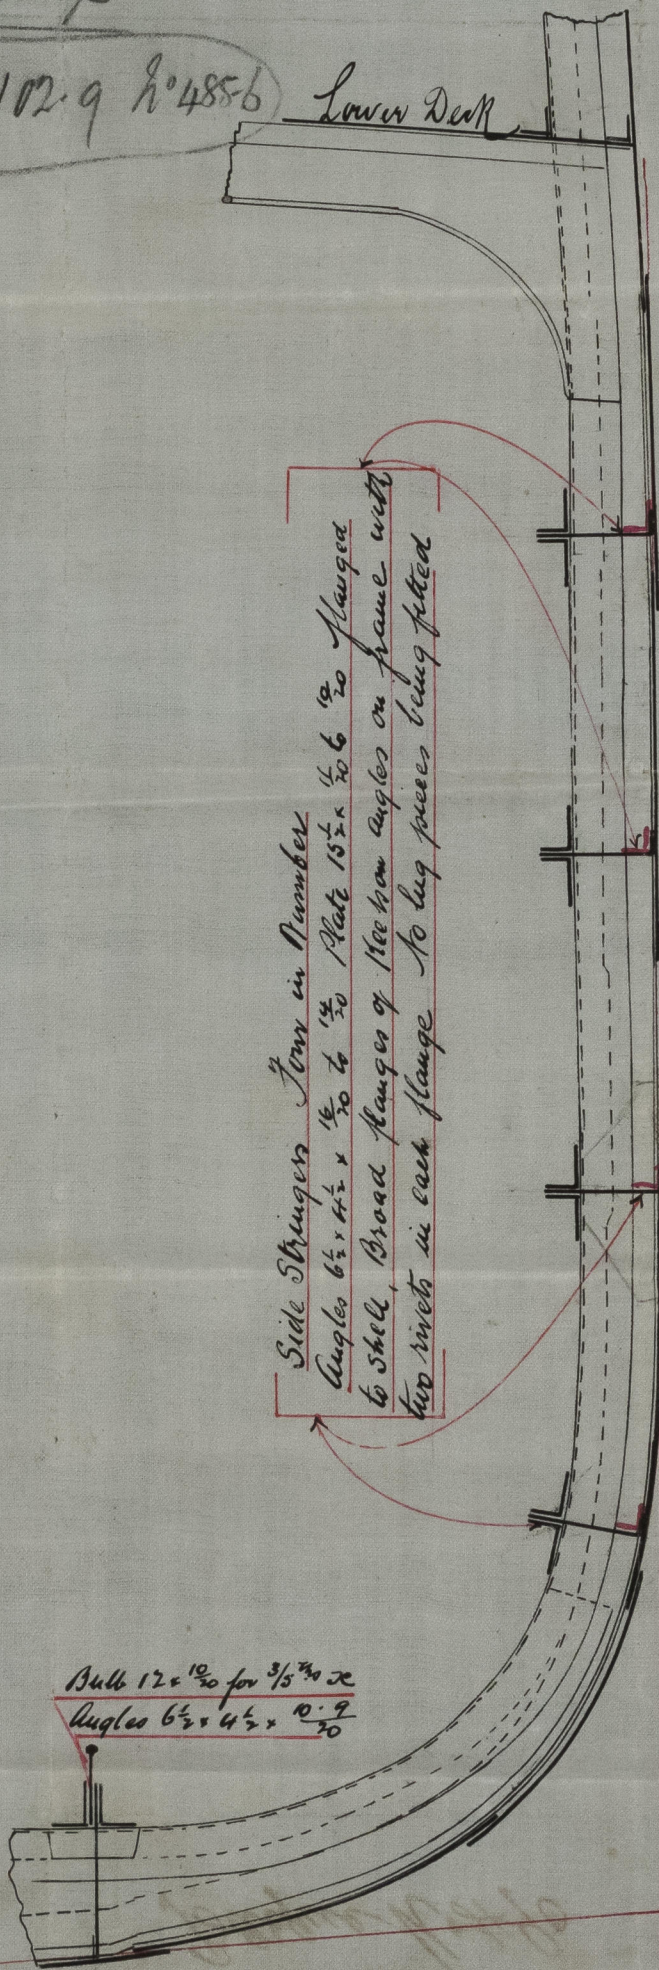

Adopted  
W.L. 9/1/02



© 2021

Lloyd's Register  
Foundation

008186-008200-0264





Tracing showing  
arrangement of side Hinges  
Russell Ho:  
Barque No 90



Lloyd's Register  
Foundation